16

Bel

PLAT AND RECORD

Of a Survey on Section 17 T 2 R 12 E. of the 4 P. M. in ROCK Township

Rock County, Wisconsin, made APRIL the 8th 1974

I hereby certify that the following is a correct record of said survey as made by me.

Hugh J. Lee

County Surveyor.

COUNTY BUILDING
IN CITY OF BELOIT

THE GEO. B. BARNARD COMPANY, ST. LOUIS

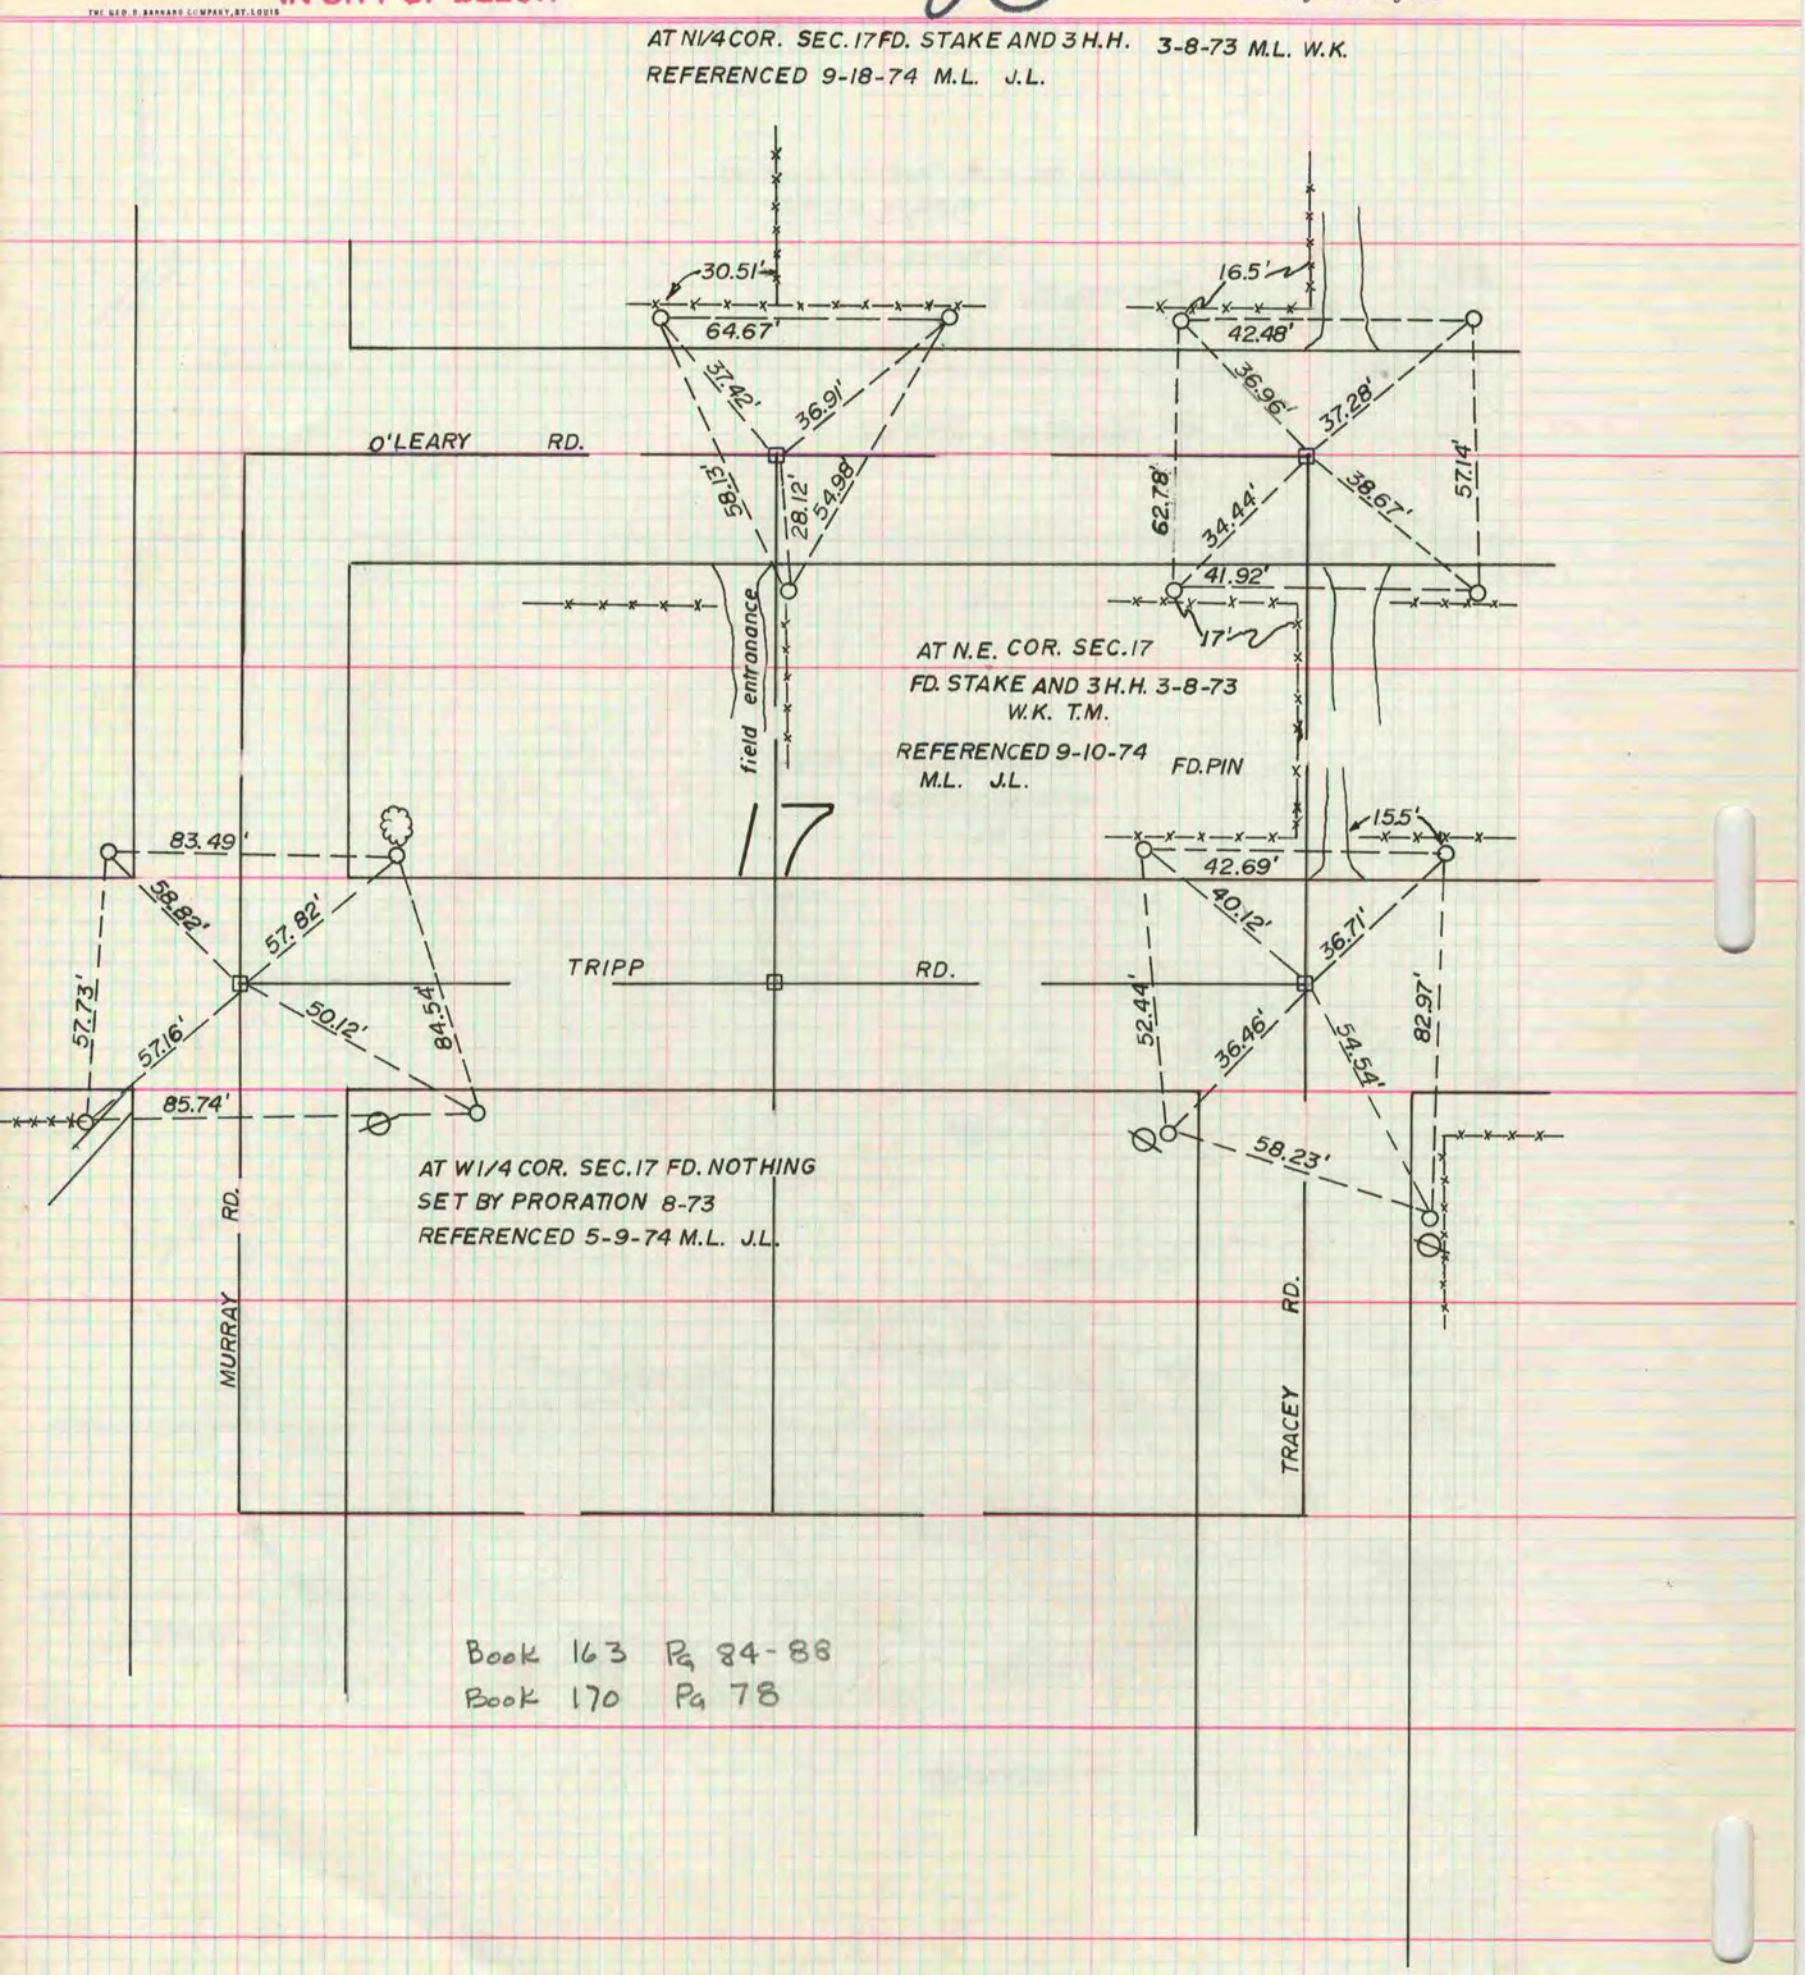

Book 163 Pg 84-88
Book 170 Pg 78