PLAT AND RECORD

COUNTY BUILDING
IN CITY OF BELOIT

Of a Survey on Section 11&14 T 2 R 11 E. of the 4 P. M. in Plymouth Township

Rock County, Wisconsin, made November the 4th & 5th & 10th 1910

I hereby certify that the following is a correct record of said survey as made by me.

(Signed) C. V. Kerch
R.H.I.B. County Surveyor.
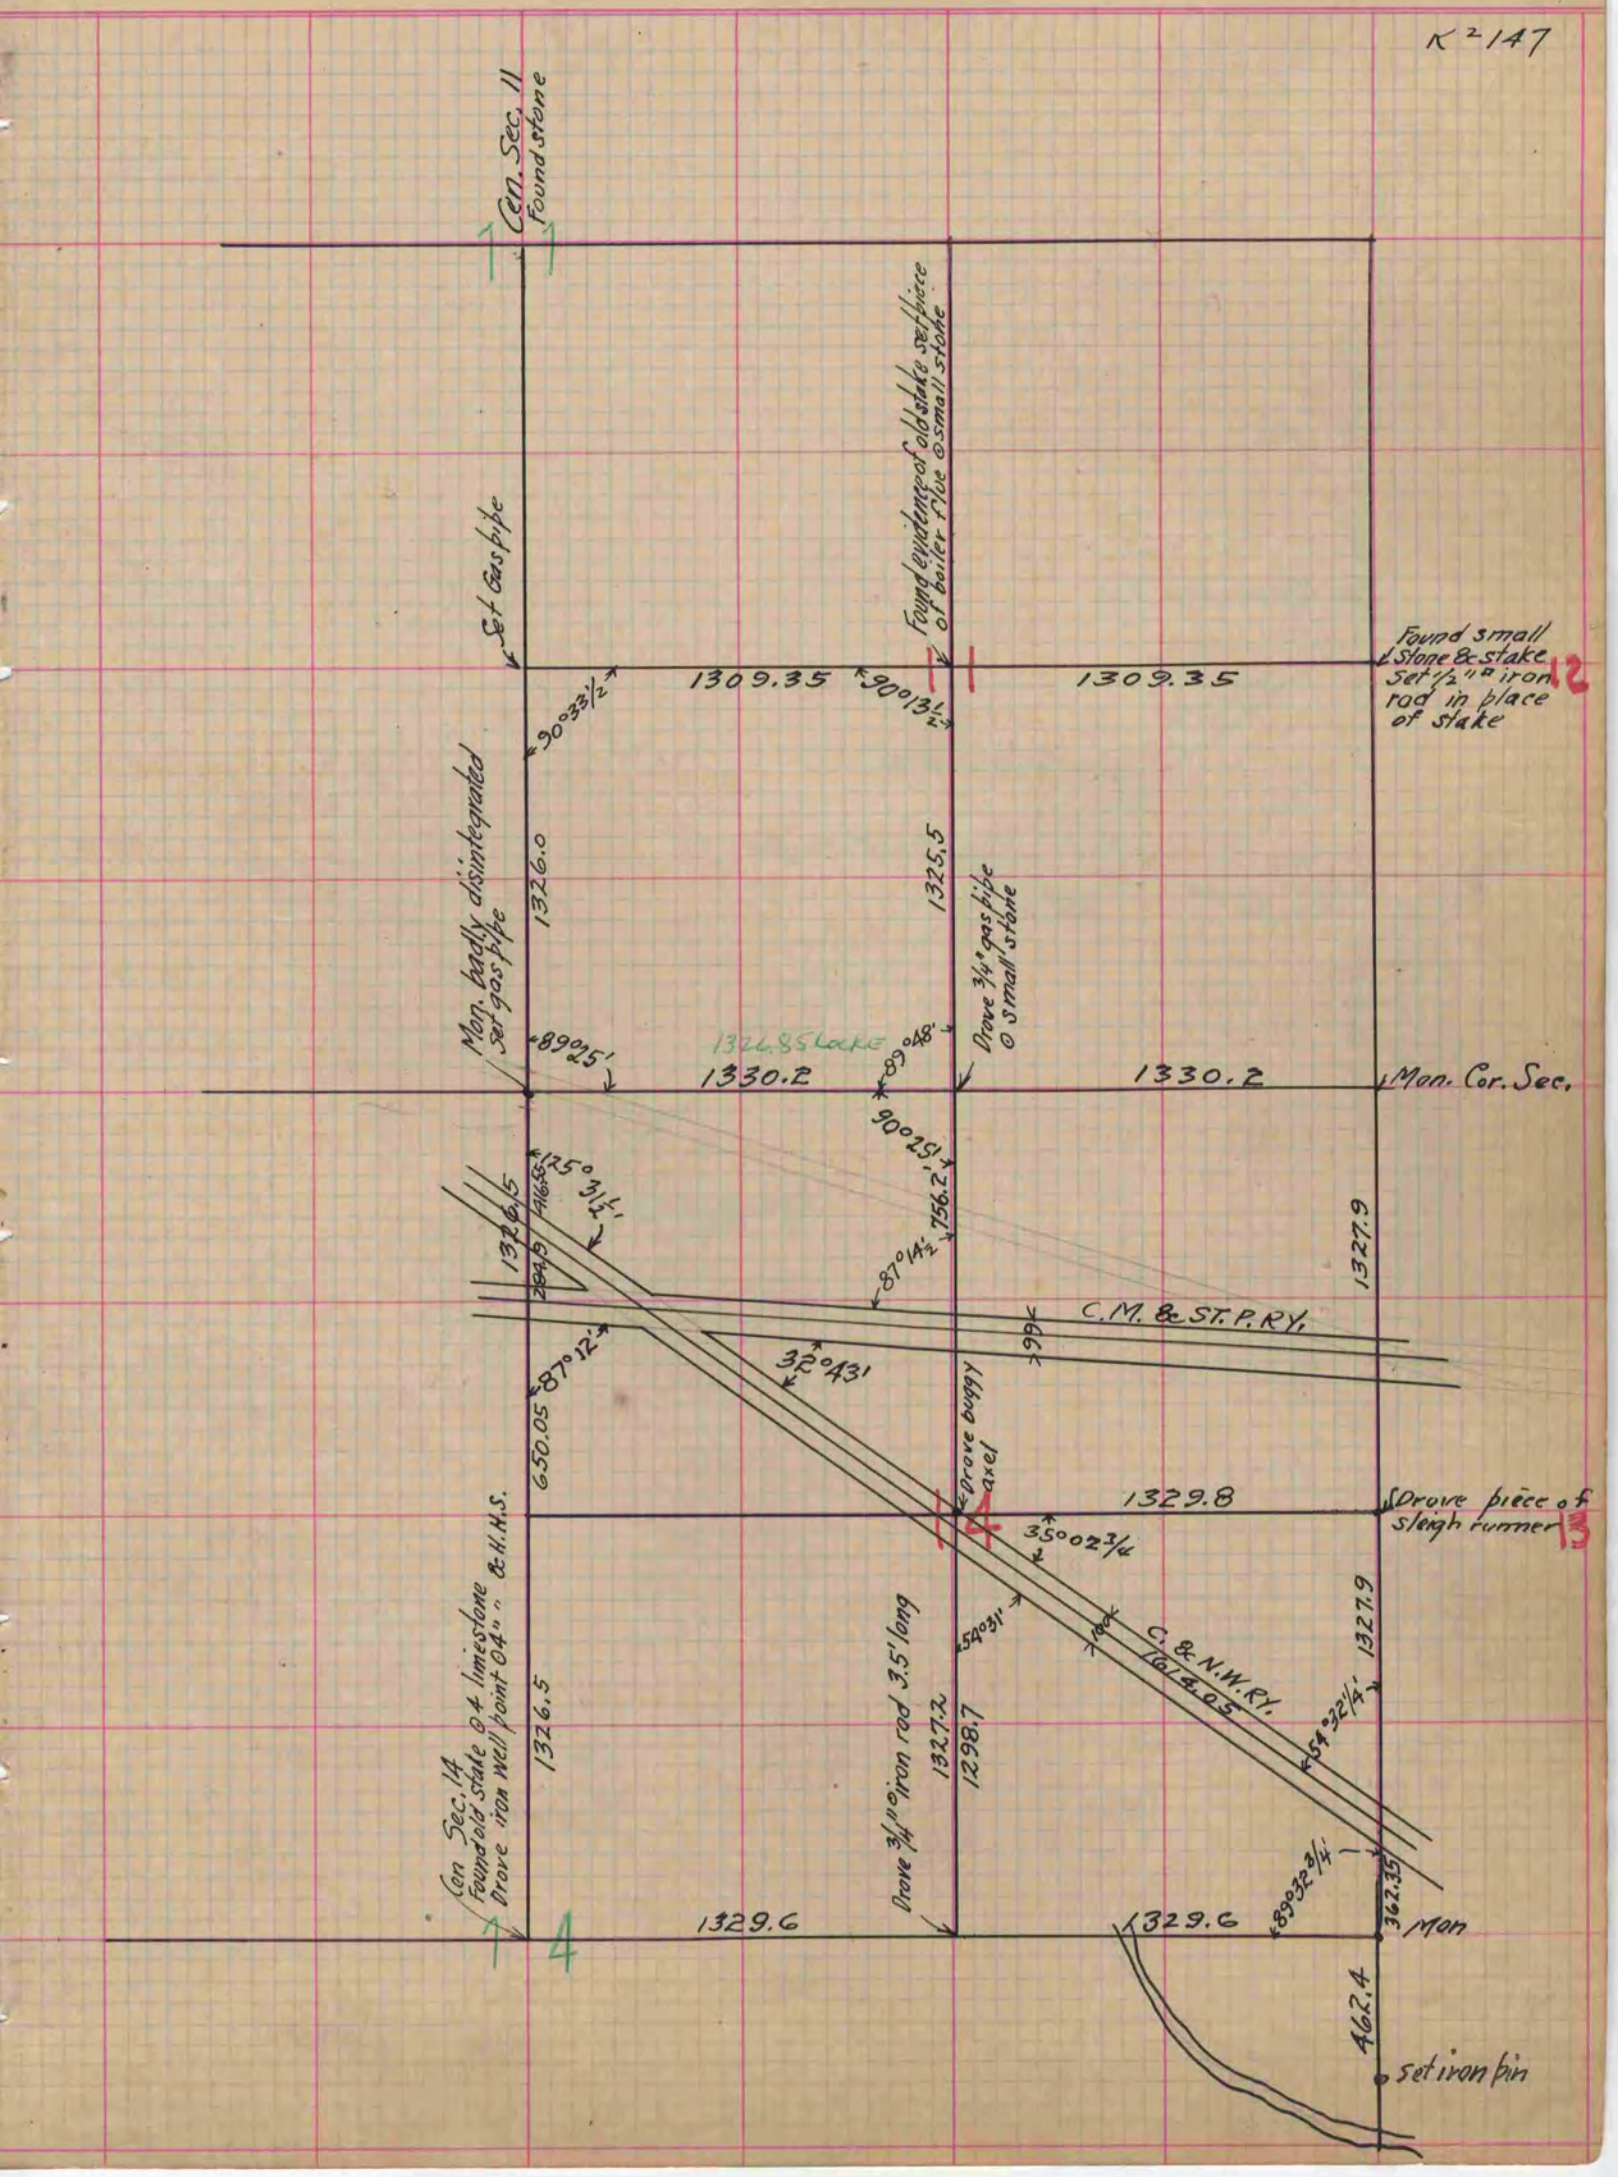
K²147