# PLAT AND RECORD

71

COUNTY BUILDING
IN CITY OF BELOIT

Of a Survey on Section 13 T 2 R 14 E. of the 4 P. M. in Bradford Township

Rock County, Wisconsin, made October the 18th & 19th 1912

I hereby certify that the following is a correct record of said survey as made by me.

County Surveyor.
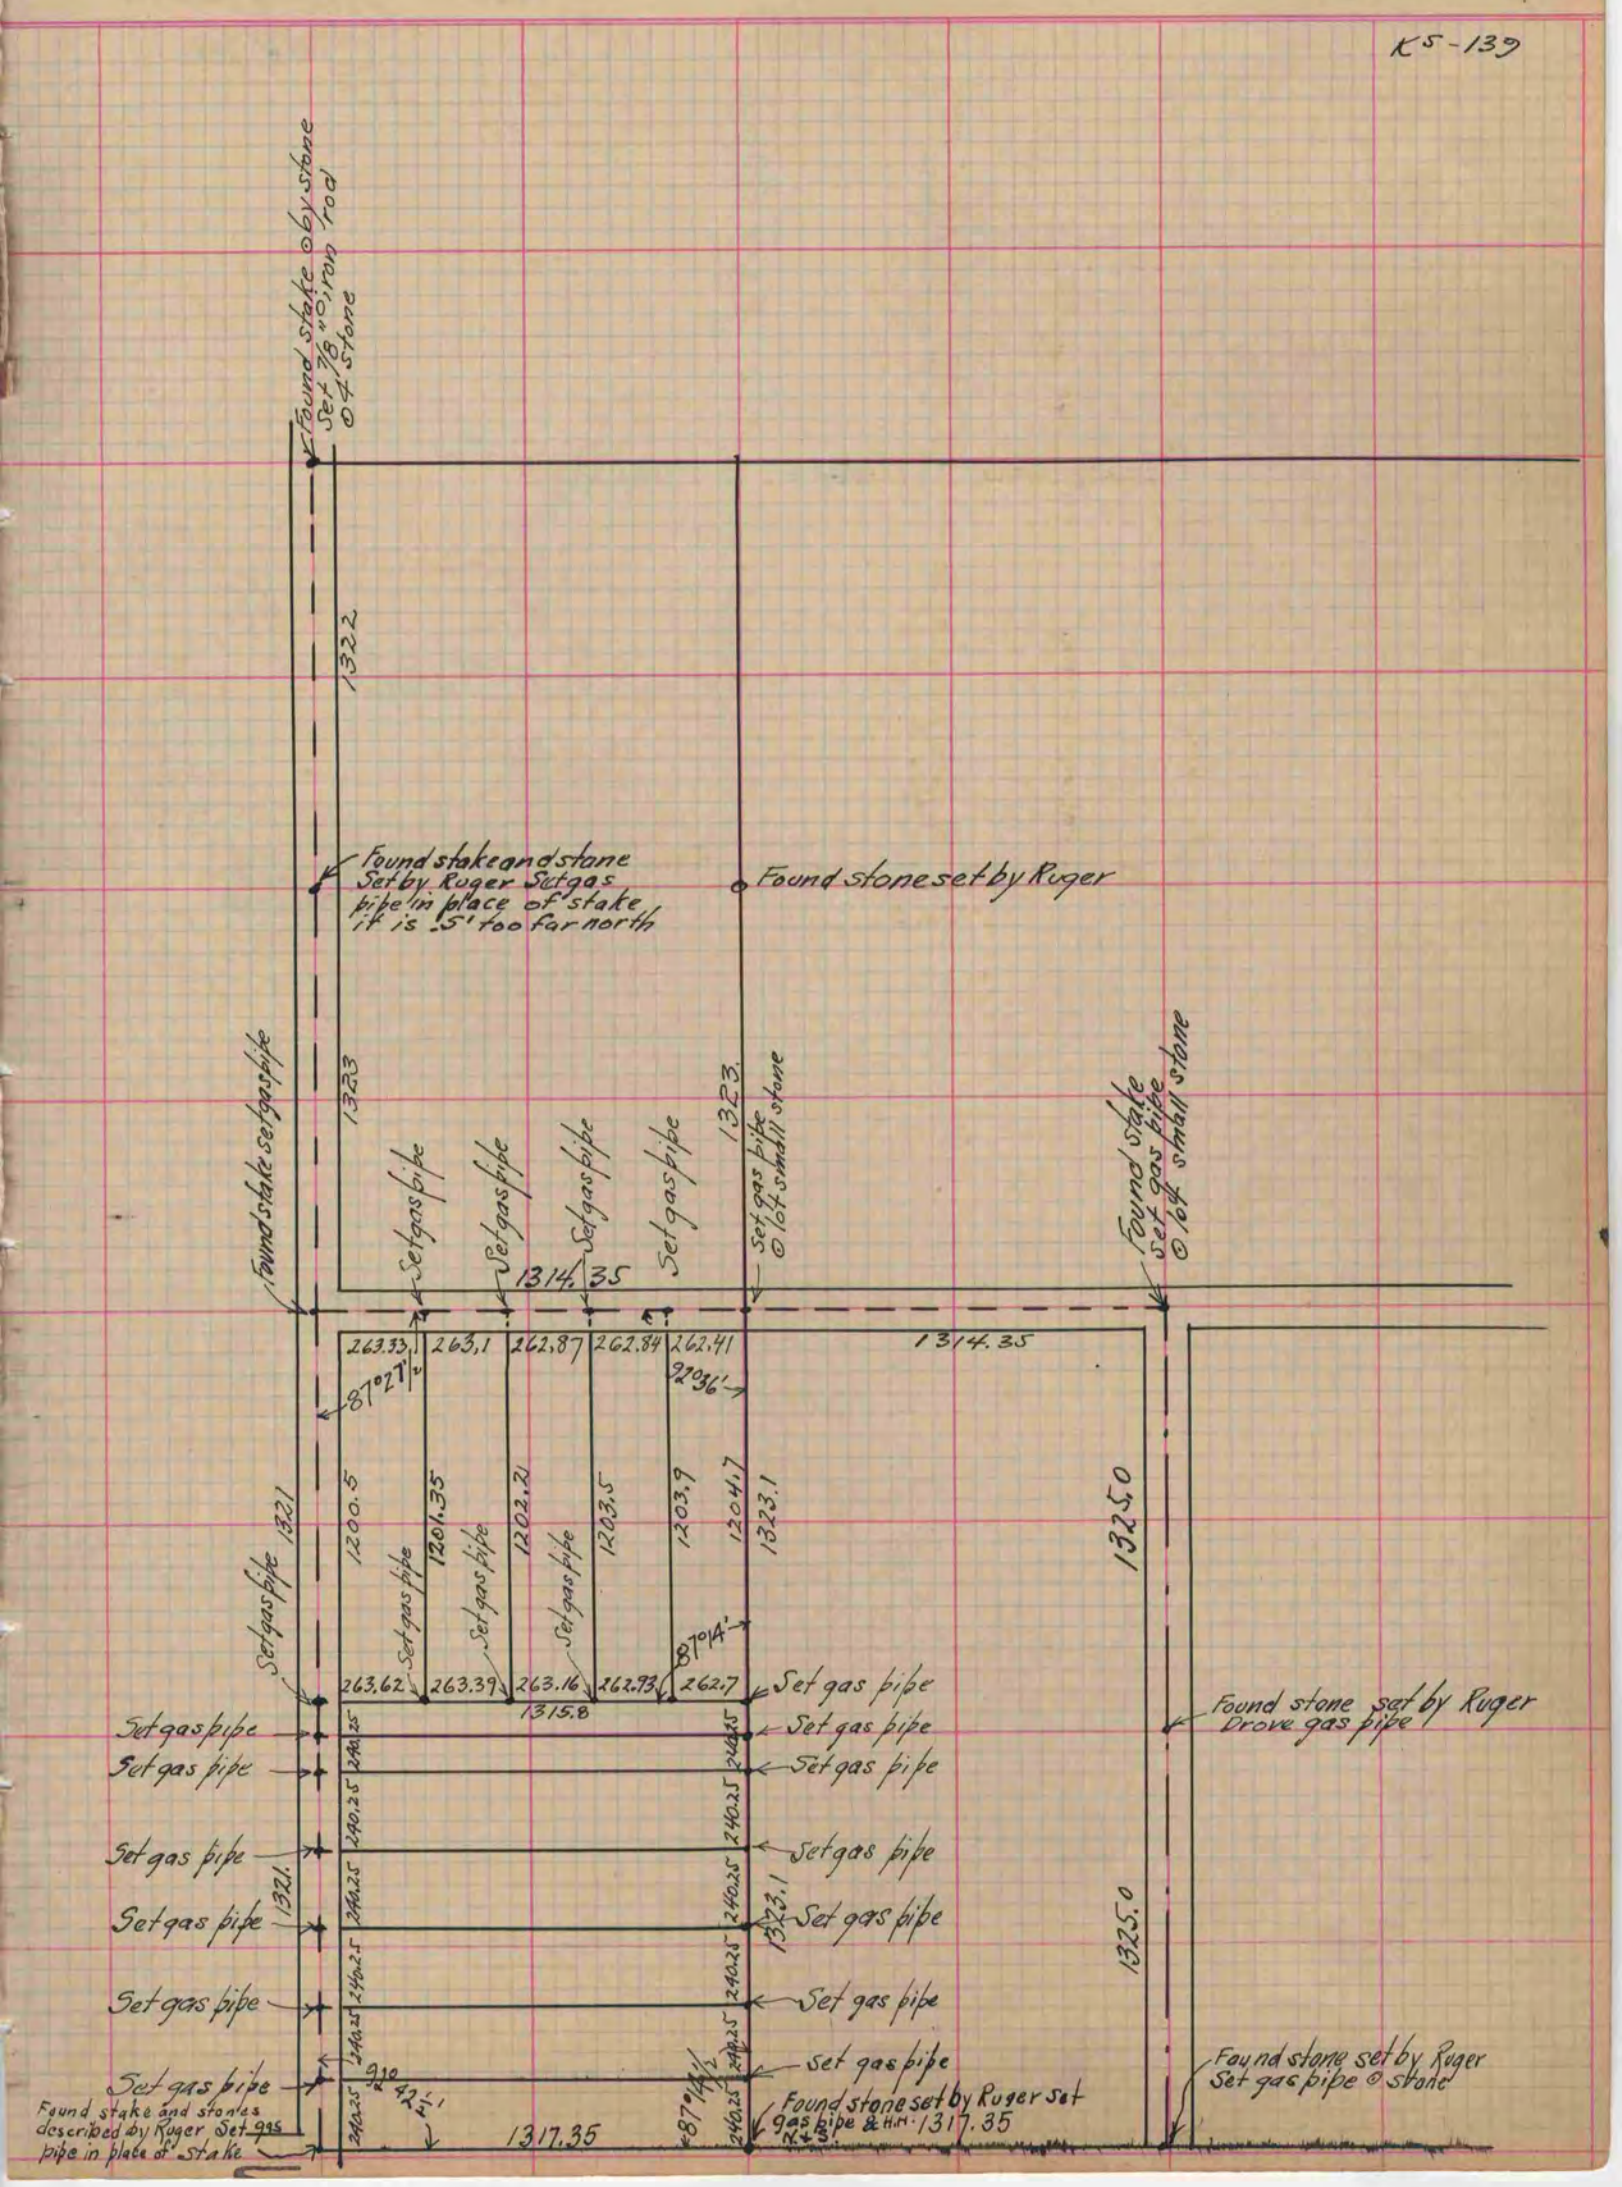
K5-139