PLAT AND RECORD

COUNTY BUILDING
IN CITY OF BELOIT

Of a Survey on Section 14 T 1 R 12 E. of the 4 P. M. in Beloit Township

Rock County, Wisconsin, made August the 27 1919

I hereby certify that the following is a correct record of said survey as made by me.

R. R. Batterman
County Surveyor.

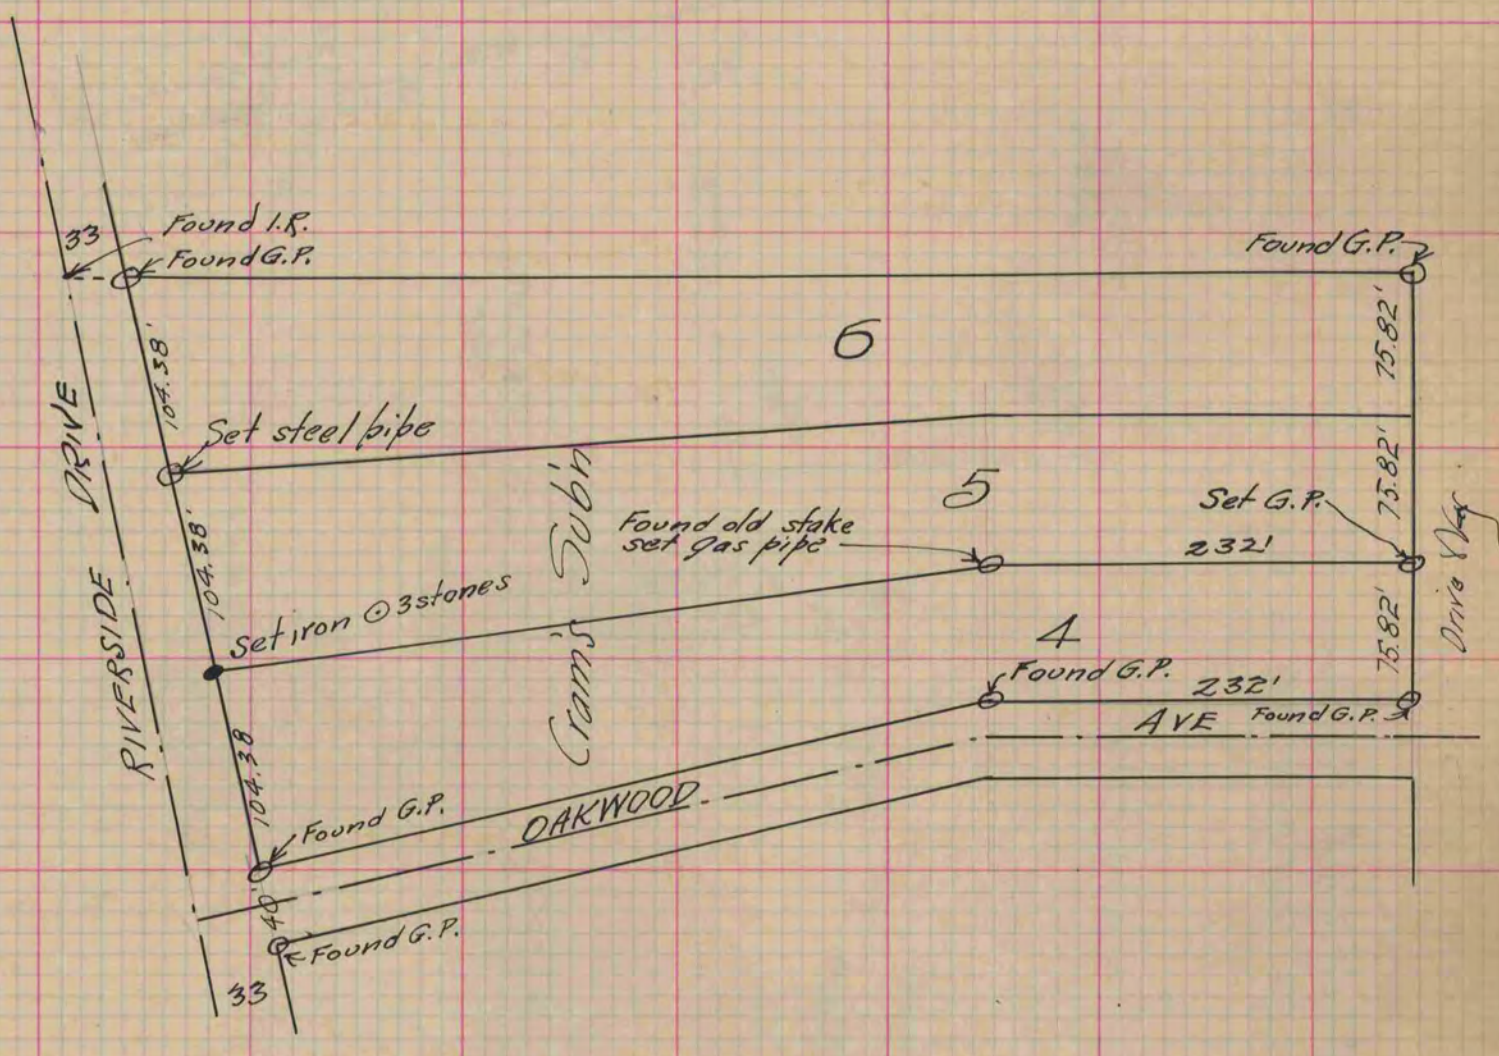

#252
B.7.P.40
For. W.S. Rundell