PLAT AND RECORD

COUNTY BUILDING
IN CITY OF BELOIT

Of a Survey on Section S½, N.E¼ 1 T 46 R 1 E. of the 3 P. M. in Rockton Township
~~Rock~~ Winnebago County, ~~Wisconsin,~~ Illinois made July the 10 19 20

I hereby certify that the following is a correct record of said survey as made by me.

R. N. Patterman
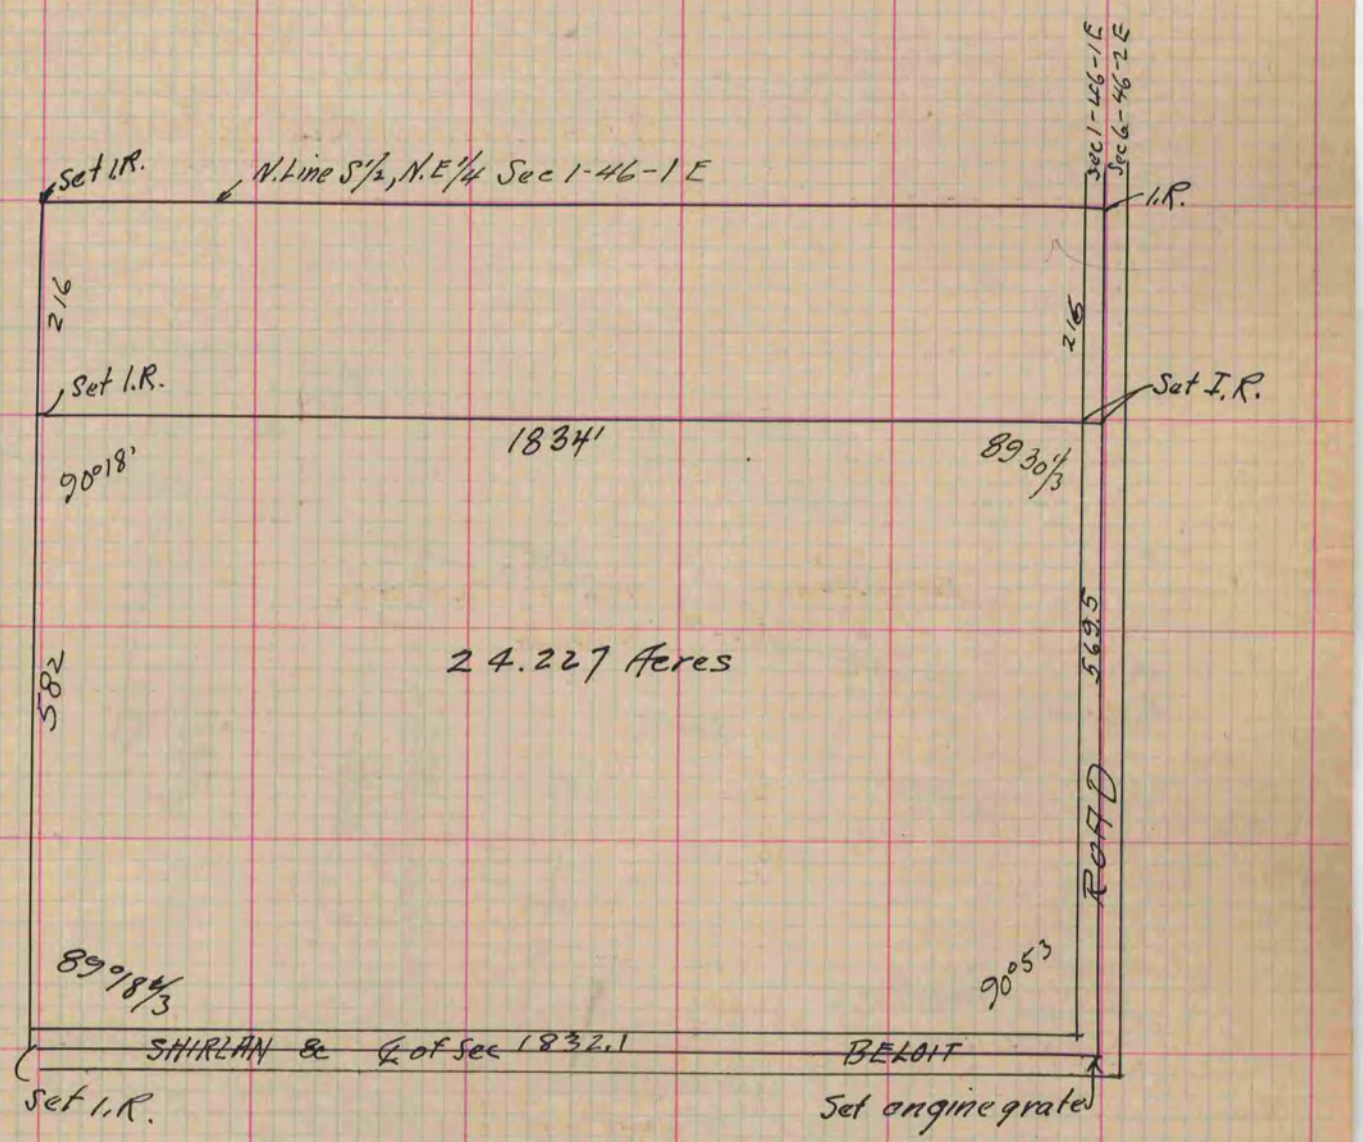
County Surveyor.