PLAT AND RECORD

Of a Survey on Section 16 T 2 R 10 E. of the 4 P. M. in Spring Valley Township

Rock County, Wisconsin, made April the 3rd 1857

I hereby certify that the following is a correct record of said survey as made by me.

COUNTY BUILDING
IN CITY OF BELOIT

(Signed) Joseph Church by Chas. H. Brown
R1813 Deputy County Surveyor.

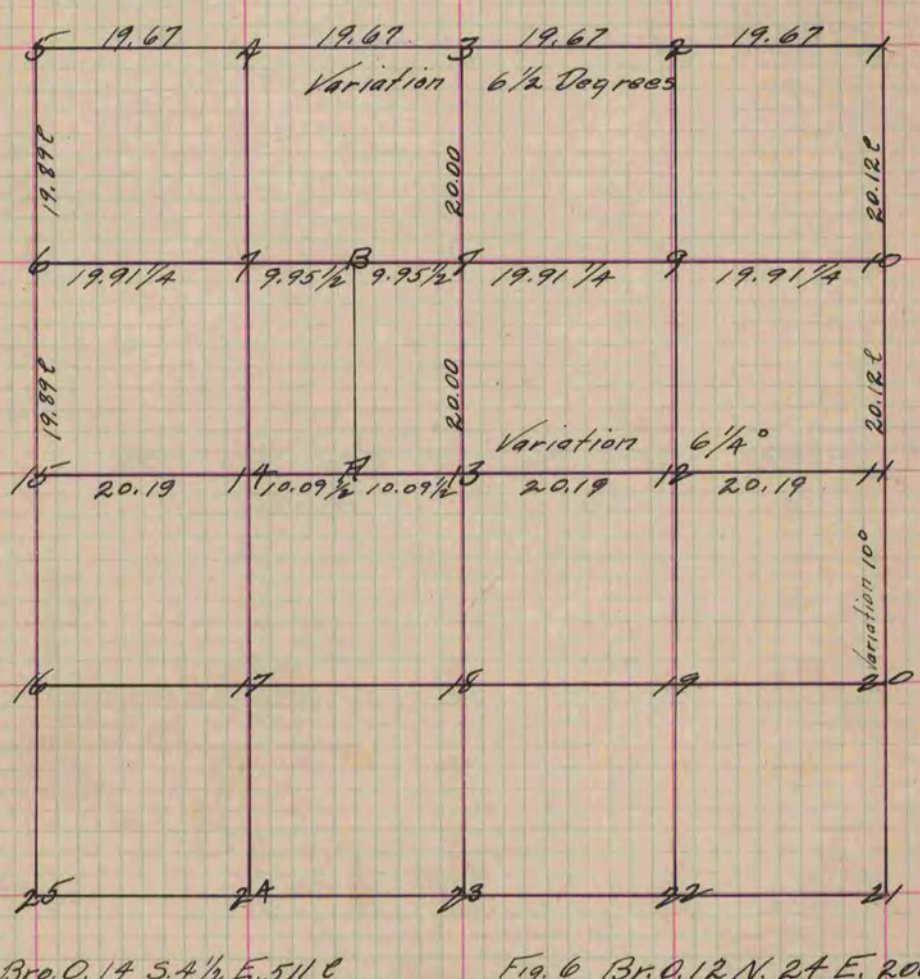

Fig. 3 Bro. O. 14 S. 4½ E. 511 c
4 N. 32½ W. 330 c
" 7 12 S. 12 E. 670 c
14 S. 6½ E. 673 c
" 8 12 S. 81½ E. 359½ c
S. 59½ E. 241
" 9 10 S. 10 W. 240
12 S. 13½ W. 291
" 12 10 N. 9½ W. 60
Stump N. 59½ E. 90
" 13 V. O. 11. S. 75 E. 261
Br. O. 6 N. 68½ E. 150
" 14 Stake no bearing.

Fig. 6 Br. O. 12 N. 24 E. 206
10 N. 16½ E. 203
Letter A. Br. O. 10 S. 26½ W. 126
Stump S. 179
" B. Y. O. 10 N. 13 E. 5.15
12 N. 31¼ E. 5.54

Copied from Page 74 Vol. I Original County Surveyor's Record