38

PLAT AND RECORD

Of a Survey on Section 28 T 2 R 11 E. of the 4 P. M. in Plymouth Township

Rock County, Wisconsin, made May the 25th & 26th 1855

I hereby certify that the following is a correct record of said survey as made by me.

COUNTY BUILDING
IN CITY OF BELOIT

(Signed) Joseph Church
R.H.B.
County Surveyor.

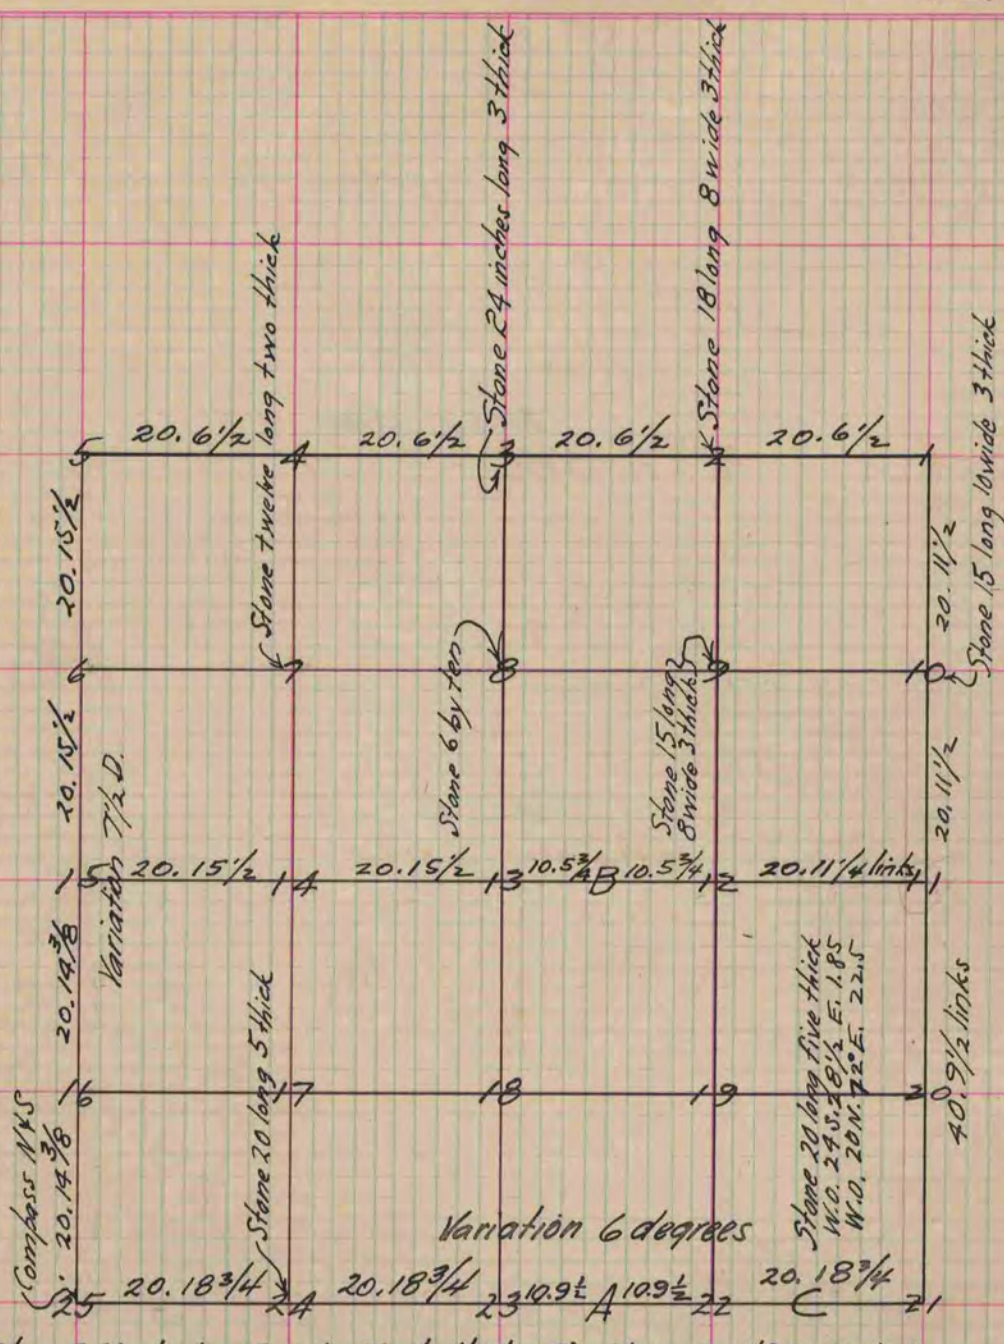

Fig. 25 Stone 24 inch. long 8 wide 4 inch thick School house S. 6½° E. 239 links - S.E. cor. of Jake Fishers house N. 47¾ W. 151

" 21 Stone 12 inches long 3 inches thick

" 15 Stone 18 long four inches thick 8 inches wide. S. Corner house N 15½ W. 566 Locust tree N. 58 W. 42 links

" 6 Stone 15 inch long ten wide 3 thick

" 4 Stone 20 inch long ten wide 3 thick Black O. N 54E 203 links - Black Oak N. 54 W. 220 links

" 5 Stone 18 long 6 inch thick

" 1 Stone 15 long 8 wide 4" thick

" 13 Stone 15 long 8 wide 8 thick

" 12 Stone 14 long 8 wide 6 thick

" 11 Stone 18 long 8 wide

" 23 Stone 20 long 5 inches thick - Lewis Smith's house N.W. Corner S. 35¾ E. 257¾ links Locust tree Six inches N 28½ W. 44½

A. Stone 20 long 6 inches thick . B. Stone 14 long 8 inches wide 3 inch thick

Fig. 8 Stone ten inches long 6 inches wide

" 9 Stone 6 by ten inches

" 24 Stone 20 inches long 5 inches thick

Copied from Page 39 Vol. 1. Original County Surveyors Record