

# U.S. PUBLIC LAND SURVEY MONUMENT RECORD

For Public Land Survey Corners in:

WI ADMINISTRATIVE CODE A-E 7.08 REQUIREMENT

T. 2 N., R. 11 E

### CORNER CODE INDEX

PLYMOUTH TWP  
**ROCK COUNTY WI**

IF AVAILABLE  
ROCK COUNTY COORDINATES PREFERRED

A	1	2	3	4	5	6	7	8	9	10	11	12	13	14	15	16	17	18	19	20	21	22	23	24	25
B																									
C	6																								
D																									
E																									
F	1																								
G																									
H																									
I																									
J																									
K																									
L	18																								
M																									
N																									
O																									
P	19																								
Q																									
R																									
S																									
T	30																								
U																									
V																									
W																									
X	31																								
Y																									
Z																									

North \_\_\_\_\_ Elev. \_\_\_\_\_

East \_\_\_\_\_

Hor. Datum \_\_\_\_\_ Vert. Datum \_\_\_\_\_

LATITUDE \_\_\_\_\_ ELLIPS. HT. \_\_\_\_\_

LONGITUDE \_\_\_\_\_

GPS (X) \_\_\_\_\_ TRAVERSE (X) \_\_\_\_\_

BASED ON THE FOLLOWING CONTROL:

PLACE MONUMENT SYMBOL  AT PROPER LOCATION ON ABOVE INDEX

CORNER MONUMENT       WITNESS MONUMENT

(a) BEARINGS ARE BASED ON:

FIELD BOOK \_\_\_\_\_ PAGE # \_\_\_\_\_

SHEET 1 OF 2

SHOW A PLAN VIEW DRAWING DEPICTING THE CORNER MONUMENT AND SURROUNDING PHYSICAL FEATURES, INCLUDING THE EXCAVATION AREA AND DEPTH.

PLANNING & ZONING COMMITTEE ADOPTED THE ABOVE FORM ON 12/2/1982

CORNER CODE J-15

PL548

(B) Describe any record evidence, monument evidence, occupational evidence, testimonial evidence or any other material evidence you considered, and whether the monument was found or placed.

1833 HARRISON EAST ON RAND. BET. 10 & 15  
330 LEFT TIMBER & ENTER MARSH  
1980 LEFT MARSH & ENTER SEAT? TIMBER  
2640 TEMPY 1/4 SEC COR.  
3036 LEFT TIMBER & ENTER MARSH  
4422 BROOK 7.92' CRS SE  
5016 BROOK 19.8' CRS SE  
5242.38 INT. E BDY 38.28' N OF P. LAND LEVEL & WET 3<sup>RD</sup> RATE  
BEING MOSTLY BOTTOM ADJACENT TO CREEKS.  
COR WEST  
2621.19 QUARTER SEC COR. {BURR O 12 S32E 26.4' BUR O 13  
S66W 77.22' BUR O 12 BUR O 13} MARKED  
5242.38 SEC COR  
1855 CHURCH VOL 1 PG 40 STATES NOTHING ABOUT MON.  
2647.92 TO CENTER SEC 10 & 5295.84 TO N 1/4 COR SEC 10  
1864 LOCKE VOL 1 PG 199 FD STAKE (IN FENCE CORNER) VAR 6-15  
2608.32 TO SW COR SEC 10, VAR 6-20 2647.92 TO CENTER  
SEC 10, & 5295.84 TO N 1/4 COR SEC 10  
1868 LOCKE PG 42 COMMENCED AT COR. FOR SECS 9, 10, 15 & 16.  
FOUND STUMPS OF BTS IN SECS 10, 15, & 16 COR.  
1.98' E OF FIRST POST S OF COR OF FENCE. EAST  
BETWEEN SECS 10 & 15 VAR 5-40  
2621.19 SET TEMPORARY 1/4 COR COR LOST  
5247.33 INTERSECTED EAST BOUNDARY 14.19' S OF COR. SET  
AS GIVEN ON PAGE 39  
2623.66 SET 1/4 COR 2.48' EAST AND 7.10' NORTH OF  
TEMPORARY 1/4 COR. COR 4.29' AND 15.18' E OF COR  
OF FENCES VAR CORRECTED 5-49 AUG 29<sup>TH</sup> 1868  
1871 RUGER VOL 2 PG 60 STONE. 2646.44 TO SW COR SEC 10  
1871 RUGER VOL 2 PG 81 2618.55 TO SW COR SEC 10 &  
2647.26 TO CENTER OF SEC 10  
1873 RUGER VOL 2 PG 112 STONE MON. 2618.55 TO SW COR  
SEC 10  
1976 BARNES VOL 5 PG 155 FD CUT STONE LEANING AT A 45  
DEGREE ANGLE, RESET STONE. TOP IS 1.5' ABOVE GROUND.  
STONE MARKED "S 1/4". REFERENCED SAME. STONE @ FENCE INT.  
1990 SCHROEDER CSM VOL 14 PG 342 STATES NOTHING

FD CUT L.S. 1.5' ABOVE GRADE. L.S. IS LEANING NW/WEST. IN WARM WEATHER FOUND THAT STONE MOVED. EXCAVATION FOUND 3 LARGE PIECES OF CUT L.S. FIRST FOUND L.S. IS 1.7' LONG, 2<sup>ND</sup> PIECE IS 1.7' LONG LAYING ALONG SIDE TOP, & THIRD PIECE CONSISTS OF 2 PIECES- 0.55' WIDE, 1.7' LONG, 0.2' THICK LEANING AT ABOUT 70 DEGREE ANGLE AND ABOUT 1.5' DEEP. THE LAST AND DEEPER PIECE WAS IN HARMONY WITH LOCK'S DISTANCE. REPLACED WITH POLY. MON. PLACED CARSONITE NEXT TO MON. PLACED 2 MAGNETS NEAR BASE OF POLY. LAID PIECES OF FD CUT L.S. TO THE WEST OF POLY. DID NOT SEARCH FOR REFERENCE PIPES THAT I PLACED IN 1976.

C) Was the corner restored through acceptance of (1) an obliterated evidence location, or, (2) a found perpetuated location?

ACCEPTED FD 3<sup>RD</sup> AND DEEP L.S. REPLACED WITH POLY.

I, Donald Barnes, hereby certify that the corner location as identified by the corner code index was determined by me under my direction and control and that this U.S. Public Land Survey Monument Record is correct and complete to the best of my knowledge and belief.


Seal  
Donald Barnes  
Emboss

SHEET 1 OF 2

4-07-03


CORNER CODE J-15

A.E. 7.08 REQUIREMENT

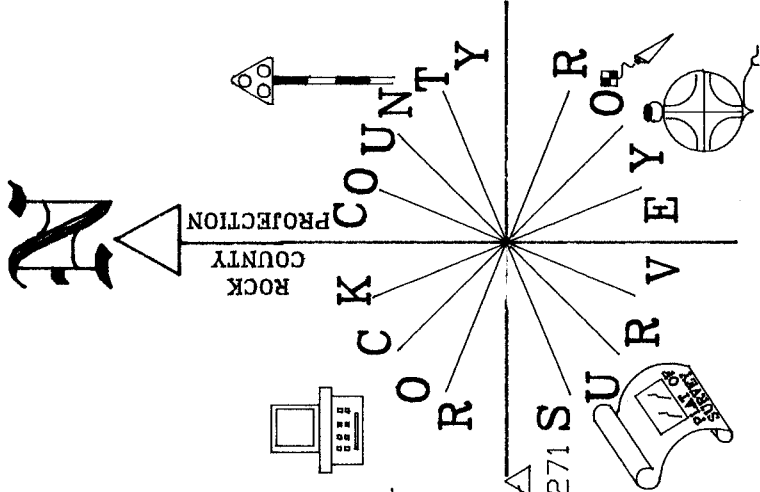

FARM FIELD

STA #271  
1.8' EAST OF WEST  
PVMT EDGE  
NORTH OF BRIDGE  
COTTON GIN PIN

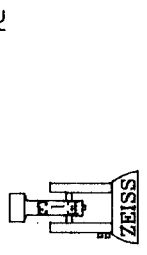

NOT TO SCALE

N25-55-34E 17,368  
RED/WHITE ANT.  
MAGNET ON TOP  
16" DEEP  
DF POLY  
1.7' BELOW TOP

N46-03-41E 42,50  
S87-22-21E 31.28  
N1-11-02W 30.93  
N0-50-56W 27.78

N46-03-41E 42,50  
0.8' ABOVE  
TOP OF POLY.

N23-22-06W 11,176  
CELL TOWER  
N24-49-11W 34,081  
FOOTVILLE WATER TANK ANT  
N33-43-20W 15,609

N52-03-06E 42,84  
N87-36-16W 34.22  
S47-06-37E 47.54

S47-06-37E 47.54  
ANT. 33,965  
S73-27-13W 22,933  
FOOTVILLE WATER TANK  
S68-16-30W 22,933

S 1/4 COR  
SEC 10  
PLYMOUTH TWP  
R11E T2N

FARM FIELD

FARM FIELD

EMBOSSED SEAL  
*Rondo Baues*  
4-07-03

SHEET 2 OF 2  
J-15

3/4X24" REROD/PLASTIC CAP  
POLY, MON./CARSONITE POST  
PLACED 2 MAGNETS NEAR BASE &  
PIECES OF CUT L.S. TO THE WEST  
OBSERVATION SHEET #548 & 271  
1976 VOL 5 PG 155 REFERENCE PIPES  
WHICH WERE NOT SEARCHED FOR

FARM FIELD