PLAT AND RECORD

Of a Survey on Section 30 T 2 R 11 E. of the 4 P. M. in Plymouth Township

Rock County, Wisconsin, made November the 9th 1869

I hereby certify that the following is a correct record of said survey as made by me.

COUNTY BUILDING
IN CITY OF BELOIT

(Signed) R. K. Lee
R. H. B.
County Surveyor.

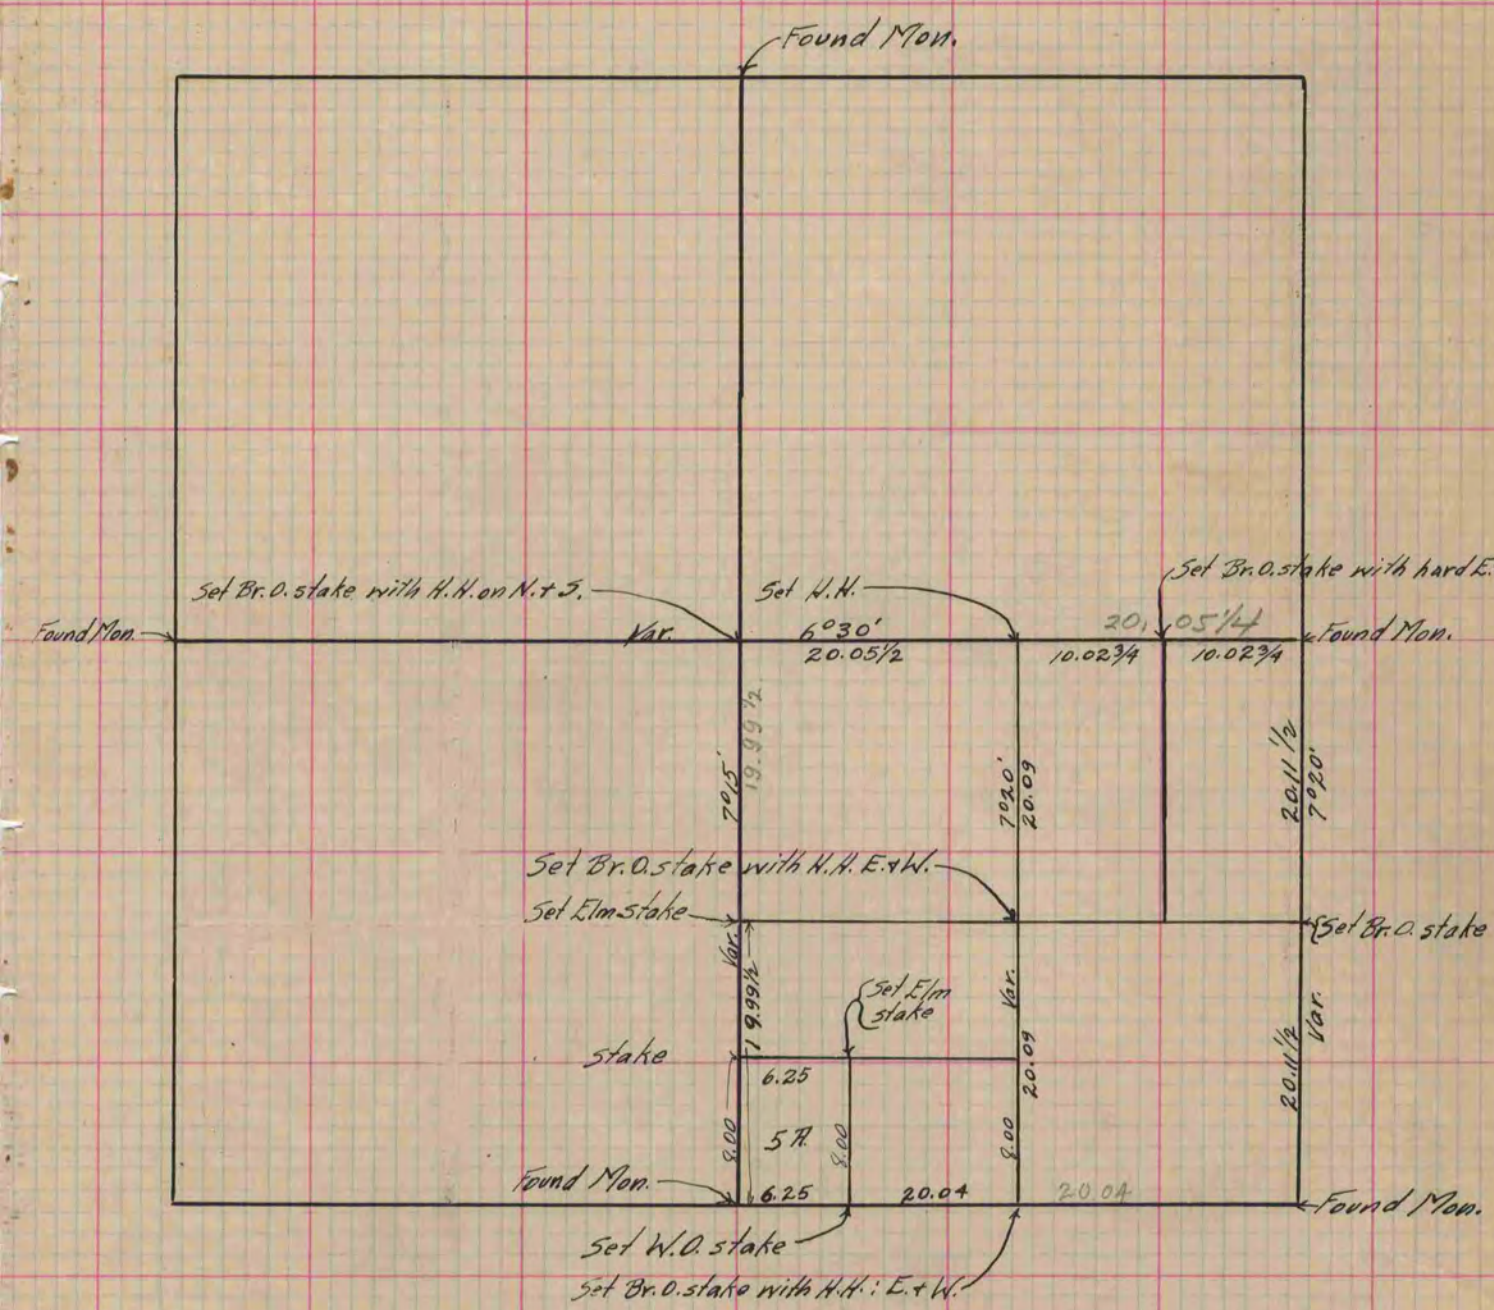

Copied from Upper ½ of Page 9 Vol. 2. Original County Surveyor's Record.