Paper weight _____ minimum)

Black non-fading ink required

# U.S. PUBLIC LAND SURVEY MONUMENT RECORD

For Public Land Survey Corners in:

T. 3 N., R. 12 E

WI ADMINISTRATIVE CODE A-E 7.08 REQUIREMENT

CORNER CODE INDEX

| | | | | | |
|---|---|---|---|---|---|
| 6 | 5 | 4 | 3 | 2 | 1 |
| 7 | 8 | 9 | 10 | 11 | 12 |
| 18 | 17 | 16 | 15 | 14 | 13 |
| 19 | 20 | 21 | 22 | 23 | 24 |
| 30 | 29 | 28 | 27 | 26 | 25 |
| 31 | 32 | 33 | 34 | 35 | 36 |

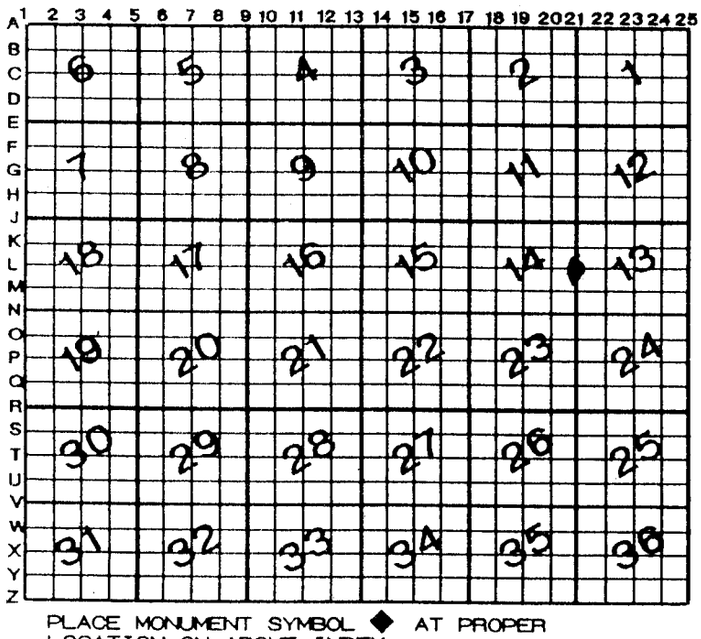

PLACE MONUMENT SYMBOL ◆ AT PROPER LOCATION ON ABOVE INDEX

JANESVILLE TWP

ROCK COUNTY WI

IF AVAILABLE ROCK COUNTY COORDINATES PERFERRED

North 81,593.439 m Elev. _____

East 679,194.501 m

5595

Hor. Datum NAD83 Vert. Datum _____

LATITUDE _____ ELLIPS. HT.

LONGITUTE _____ _____

GPS (X) ___ TRAVERSE (X) ___

BASED ON THE FOLLOWING CONTROL:

(a) ◆ CORNER MONUMENT DISK ○ WITNESS MONUMENT

NOTE ON PLAT: COORDINATES & BEARINGS ON THIS PLAT ARE ORIENTED TO THE WI COORDINATE SYSTEM SOUTH ZONE, NAD 83. ALL PLAT DISTANCES ARE GROUND LENGTH AND MAY BE CONVERTED TO GRID LENGTH BY MULTIPLYING THE DISTANCE BY THE GRID FACTOR PROVIDED ON THE DETAIL SHEETS.

WIDOT PROJ. #5569-03-21 DATE: MAY 19 1995

NE 14 · 2665.25 N1/4 14

S89-23-10E

N01-42-22W

2646.23

E1/4 14

COORDINATES FOR E1/4 SEC 14 ON DOT sheet ARE IN ERROR. THEY ARE THE SAME AS FOR NE 14

BEARINGS ARE BASED ON: _____

267 694,48

2,228,323,96 FT

D. Barnes 4/02/04

FIELD BOOK _____ PAGE # _____ SHEET 1 OF 1

SHOW A PLAN VIEW DRAWING DEPICTING THE CORNER MONUMENT AND SURROUNDING PHYSICAL FEATURES, INCLUDING THE EXCAVATION AREA AND DEPTH.

PLANNING & ZONING COMMITTEE ADOPTED THE ABOVE FORM ON 12/2/1982

CORNER CODE L-21(1)