PLAT AND RECORD

Of a Survey on Section 18 T 3 R 12 E. of the 4 P. M. in JANESVILLE Township

Rock County, Wisconsin, made SEPTEMBER the 15 1960

I hereby certify that the following is a correct record of said survey as made by me.

COUNTY BUILDING
IN CITY OF BELOIT.

R H Batterman

County Surveyor.
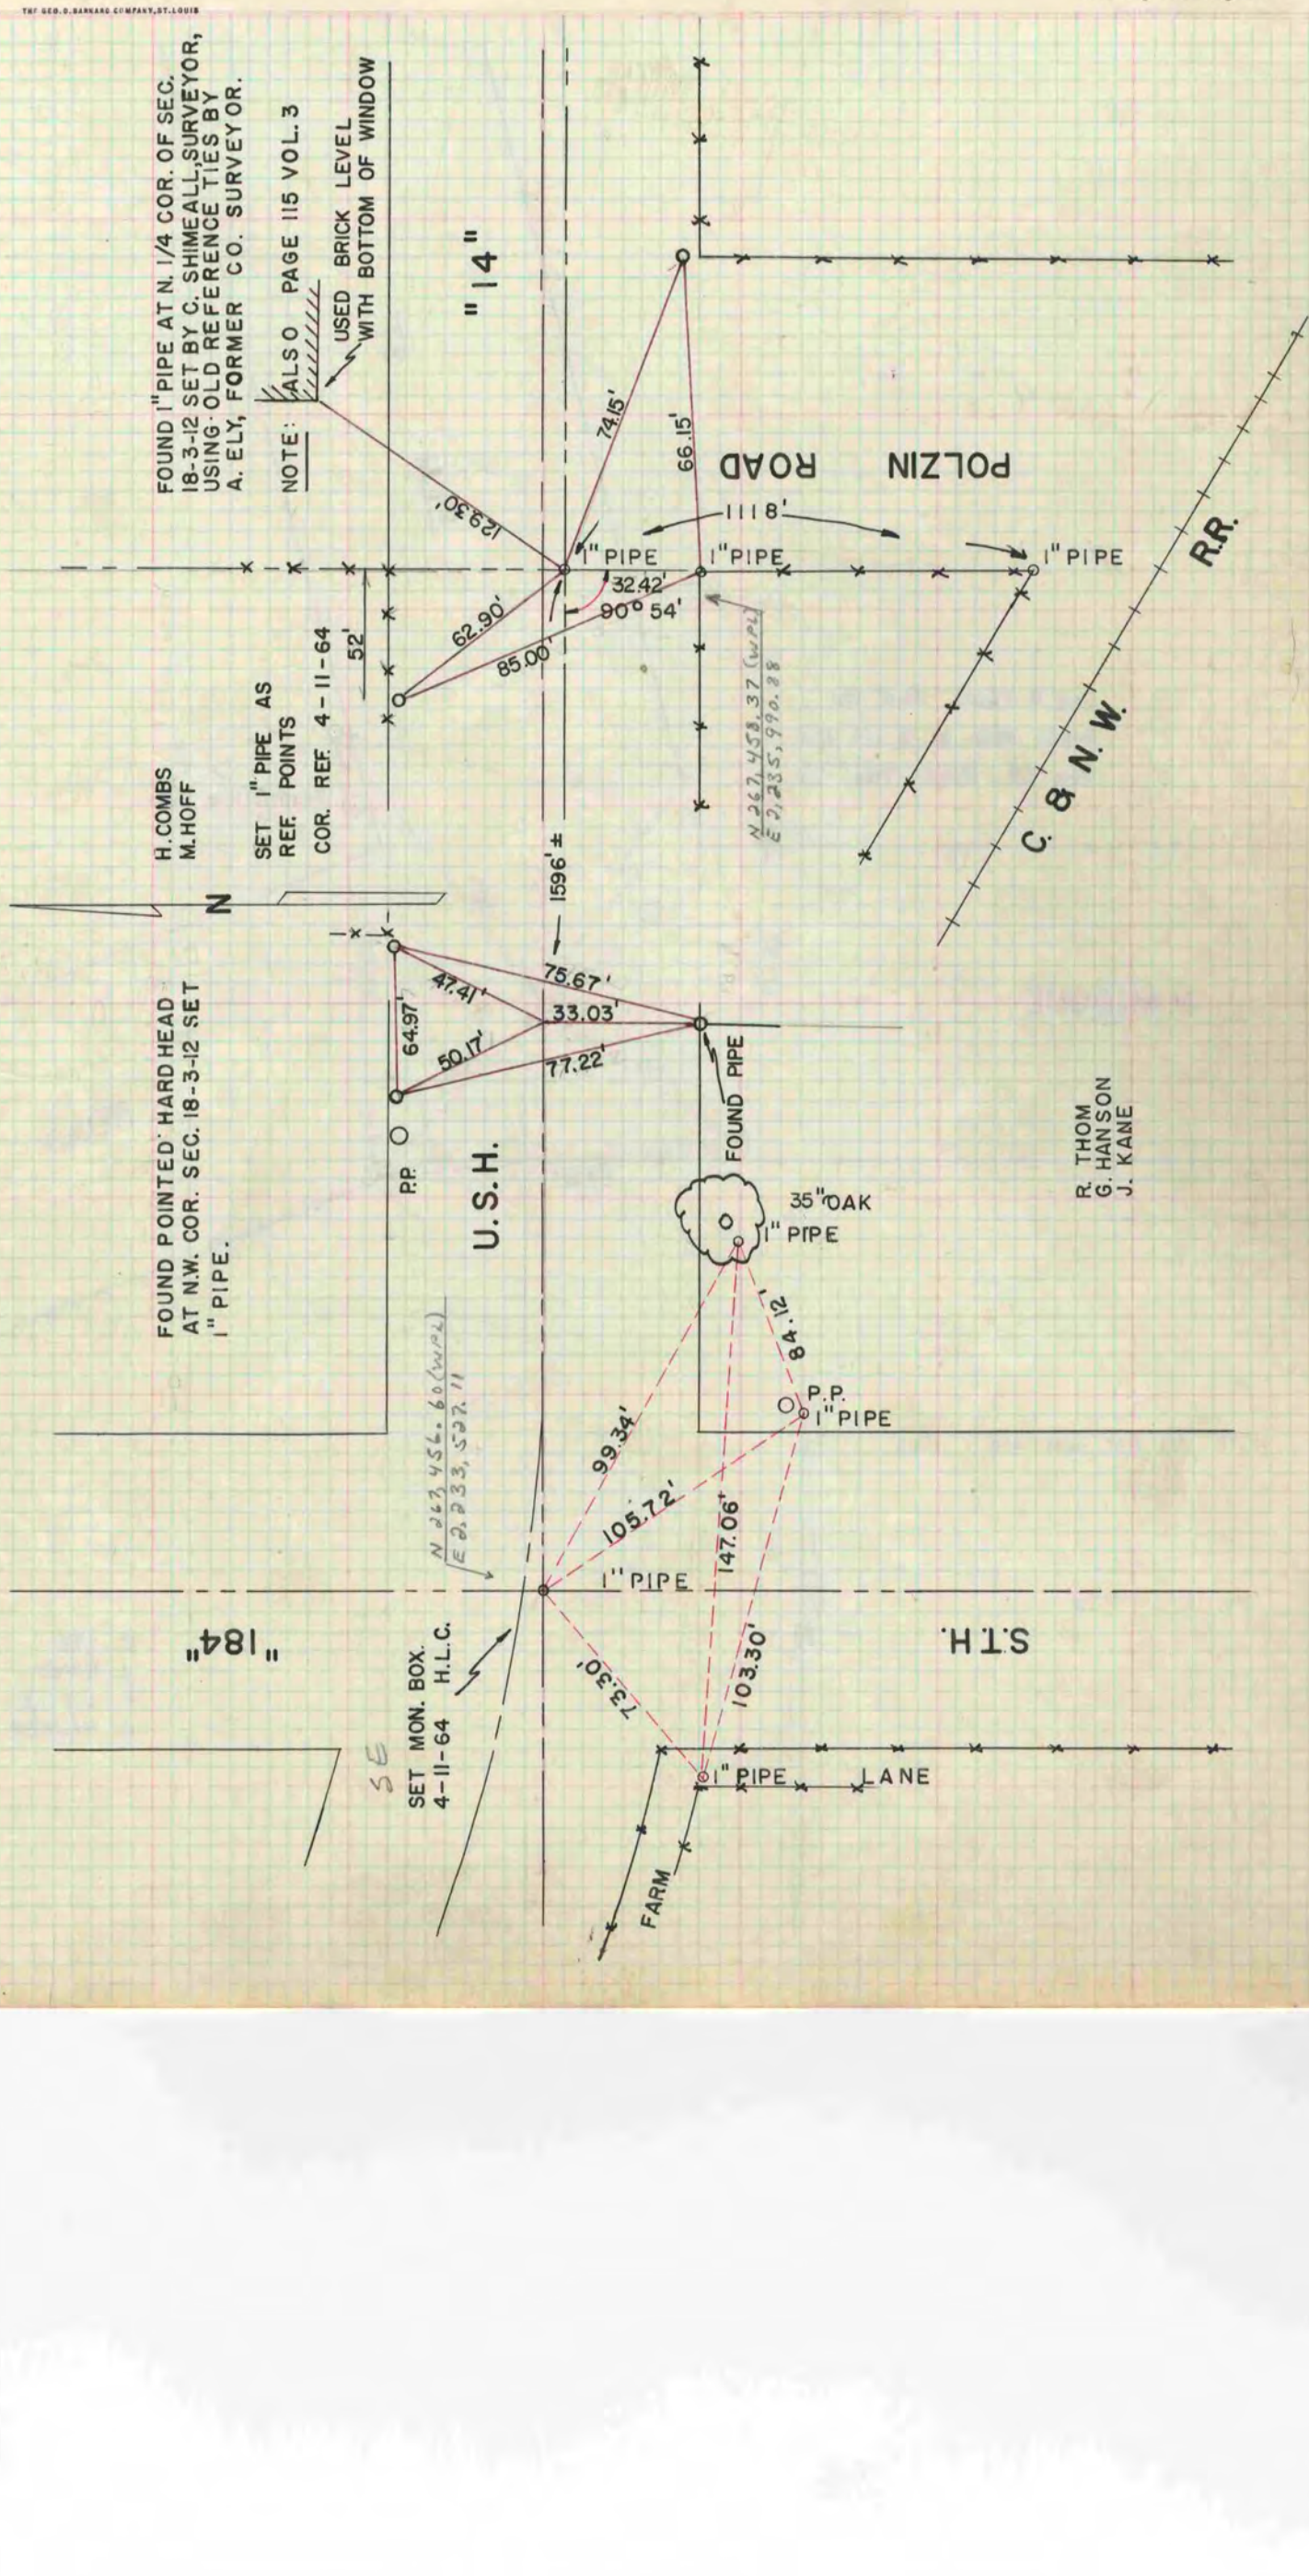
THE GEO. D. BARNARD COMPANY, ST. LOUIS