PLAT AND RECORD

Of a Survey on Section 34 T 4 R 10 E. of the 4 P. M. in Union Township

Rock County, Wisconsin, made August the 1855

I hereby certify that the following is a correct record of said survey as made by me.

COUNTY BUILDING
IN CITY OF BELOIT

(Signed) Joseph Church
County Surveyor.

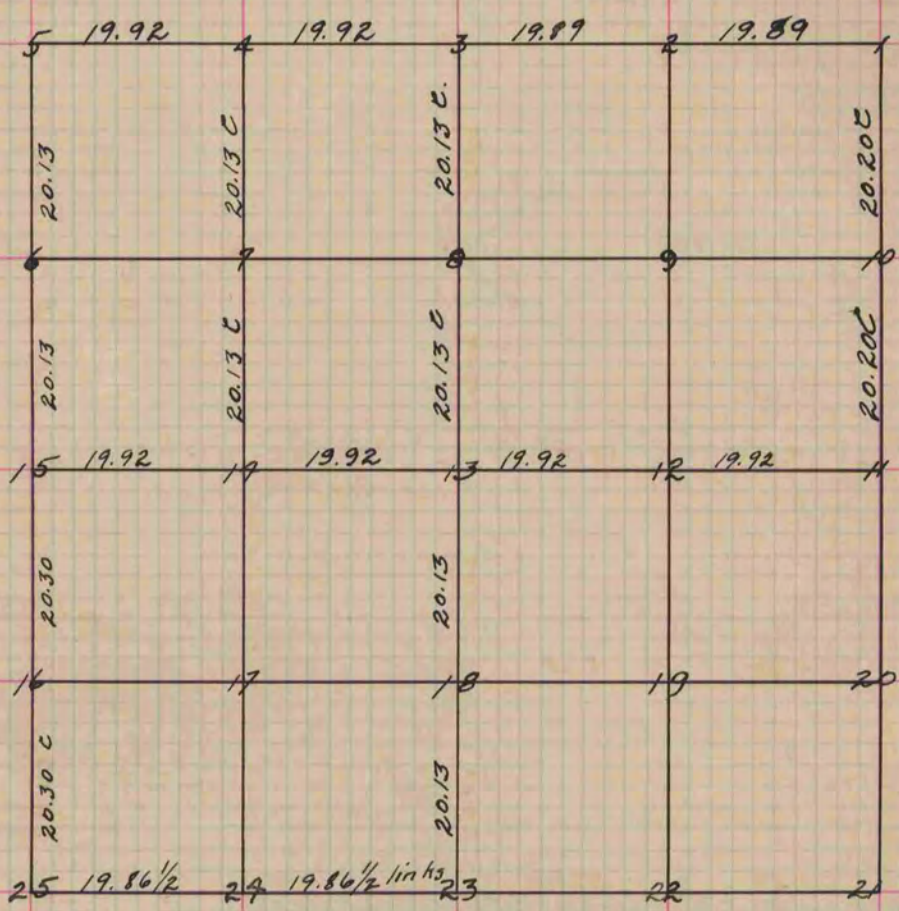

Fig. 13 is in the centre of Sec. limestone and stake.
" 18 Post in Marsh.
" 23 Government stake in Mound.
" 24 Stake no bearings.
" 26 Stake no bearings.
" 5 Government trees do not agree, made others Br. O. 18 S 64 D. W. 85
Do. 145. 68½ E. 253 C.
" 4 Stake no bearings.
" 2 Wit. Br. O. 20 N. 64½ E. 63 C. Br. O. 245. 12 W. 88 links.
" 12 Post in Marsh
" 14 Post in Marsh
" 7 Stake no bearings.
" 17 Stake in Marsh

Copied from Page 46 Vol 1. Original County Surveyors Record.