

U.S. PUBLIC LAND SURVEY MONUMENT RECORD

For Public Land Survey Corners in the


T. 1 N., R. 13 E.

CORNER CODE INDEX

|   |   
|---|---|---|---|---|---|---|---|---|---|----|----|----|----|----|----|----|----|----|----|----|----|----|----|----|----|
|   | 1 | 2 | 3 | 4 | 5 | 6 | 7 | 8 | 9 | 10 | 11 | 12 | 13 | 14 | 15 | 16 | 17 | 18 | 19 | 20 | 21 | 22 | 23 | 24 | 25 |
| A |   |   
| B |   |   
| C |   |   |   |   |   |   |   |   |   |    |    |    |    |    |    |    |    |    |    |    |    |    |    |    |    |
| D |   |   |   |   |   |   |   |   |   |    |    |    |    |    |    |    |    |    |    |    |    |    |    |    |    |
| E |   |   |   |   |   |   |   |   |   |    |    |    |    |    |    |    |    |    |    |    |    |    |    |    |    |
| F |   |   |   |   |   |   |   |   |   |    |    |    |    |    |    |    |    |    |    |    |    |    |    |    |    |
| G |   |   |   |   |   |   |   |   |   |    |    |    |    |    |    |    |    |    |    |    |    |    |    |    |    |
| H |   |   |   |   |   |   |   |   |   |    |    |    |    |    |    |    |    |    |    |    |    |    |    |    |    |
| I |   |   |   |   |   |   |   |   |   |    |    |    |    |    |    |    |    |    |    |    |    |    |    |    |    |
| J |   |   |   |   |   |   |   |   |   |    |    |    |    |    |    |    |    |    |    |    |    |    |    |    |    |
| K |   |   |   |   |   |   |   |   |   |    |    |    |    |    |    |    |    |    |    |    |    |    |    |    |    |
| L |   |   |   |   |   |   |   |   |   |    |    |    |    |    |    |    |    |    |    |    |    |    |    |    |    |
| M |   |   |   |   |   |   |   |   |   |    |    |    |    |    |    |    |    |    |    |    |    |    |    |    |    |
| N |   |   |   |   |   |   |   |   |   |    |    |    |    |    |    |    |    |    |    |    |    |    |    |    |    |
| O |   |   |   |   |   |   |   |   |   |    |    |    |    |    |    |    |    |    |    |    |    |    |    |    |    |
| P |   |   |   |   |   |   |   |   |   |    |    |    |    |    |    |    |    |    |    |    |    |    |    |    |    |
| Q |   |   |   |   |   |   |   |   |   |    |    |    |    |    |    |    |    |    |    |    |    |    |    |    |    |
| R |   |   |   |   |   |   |   |   |   |    |    |    |    |    |    |    |    |    |    |    |    |    |    |    |    |
| S |   |   |   |   |   |   |   |   |   |    |    |    |    |    |    |    |    |    |    |    |    |    |    |    |    |
| T |   |   |   |   |   |   |   |   |   |    |    |    |    |    |    |    |    |    |    |    |    |    |    |    |    |
| U |   |   |   |   |   |   |   |   |   |    |    |    |    |    |    |    |    |    |    |    |    |    |    |    |    |
| V |   |   |   |   |   |   |   |   |   |    |    |    |    |    |    |    |    |    |    |    |    |    |    |    |    |
| W |   |   |   |   |   |   |   |   |   |    |    |    |    |    |    |    |    |    |    |    |    |    |    |    |    |
| X |   |   |   |   |   |   |   |   |   |    |    |    |    |    |    |    |    |    |    |    |    |    |    |    |    |
| Y |   |   |   |   |   |   |   |   |   |    |    |    |    |    |    |    |    |    |    |    |    |    |    |    |    |
| Z |   |   |   |   |   |   |   |   |   |    |    |    |    |    |    |    |    |    |    |    |    |    |    |    |    |

PLACE MONUMENT SYMBOL (◆) AT PROPER LOCATION ON ABOVE INDEX

EXAMPLE

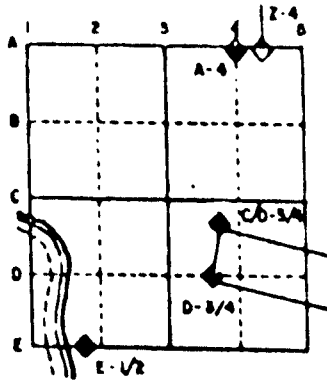

TURTLE TWP  
ROCK COUNTY WI

IF AVAILABLE  
STATE PLANE COORDINATES

North (Y) 227,287.98      Elevation (Z) \_\_\_\_\_  
 East (X) 514,708.35      Zone \_\_\_\_\_  
 Hor. Datum COUNTY      Vert. Datum \_\_\_\_\_

◆ CORNER MONUMENT

○ WITNESS MONUMENT

BEARINGS ARE BASED ON:

(B) Describe any record evidence, monument evidence, occupational evidence, testimonial evidence or any other material evidence you considered, and whether the monument was found or placed.

1836 LYON SET QUARTER POST BUR OAK 6 N78E 68 & BUR OAK 7 N41W 67.  
CALLS FOR 2647.92 TO SE & SW CORNERS OF SEC 3.

1864 LOCKE VOL 1 PG 204 FOUND N. BT 2643.30 TO CENTER OF SEC 10.

1865 LOCKE VOL 1 PG 229 FOUND W BT ERROR IN EAST. SET BR OAK STAKE  
2658.48 TO NW COR SEC 10.

1920 BATTERMAN VOL 3 PG 100 FOUND MONUMENT. SET C.I. CYL. SURROUNDED  
BY HARD HEADS.

1959 MAP #12705 2668.38 TO NW COR SEC 10.

1988 LEE MAP #12362 2664.77 TO NW COR SEC 10 & 2664.77 TO NE COR SEC  
10.

FOUND PIN. N88-09-27W 2668.13 TO NW COR SEC 10 & S88-04-15E 2661.39 TO  
SE COR SEC 9.

C) Was the corner restored through acceptance of (1) an obliterated  
evidence location, or, (2) a found perpetuated location?

ACCEPTED FOUND PERPETUATED LOCATION.

D) Describe any material discrepancy between the location of the  
corner as restored or reestablished and the location of that corner as  
previously restored or reestablished by distance and direction. Show  
the discrepancy on the plan view drawing under (a), above. Show the  
distances between the corner as previously restored or reestablished  
and (1) the corner as restored or reestablished, and (2) to at least 4  
of the witness monuments shown on the drawing in (a), above.

(E) Was the corner reestablished through lost corner proportionate  
methods? If so, show the method, including the directions and  
distances to other public land survey corners used as evidence or used  
for proportioning the corner location.

NO

I, Donald Barnes, hereby certify that the corner points as identified  
by the corner code index were, in a field survey on, 1994, established,  
re-established, monumented, re-monumented, recovered or restored as  
expressed below and in conformance with the regulations and rules as  
required in the current manual of survey instructions of the United

*Donald Barnes*  
*7/13/95*

*E15*

Donald Barnes  
7-13-95

3/4X24 REROD/PLASTIC CAP  
SOUTH SIDE CTH "P"  
STA 967

1304.83

STA 966

R/R SPIKE  
CENTER N/S PVMT &  
CENTER E/W PVMT

N16-57-14W 1036.23

N30-41-09E 1754.74

FD PIN

FD LIMESTONE


S88-09-27E 2668.13

S88-04-15E 2661.38

SW COR  
SEC 3

S 1/4 COR  
SEC 3

SE COR  
SEC 3

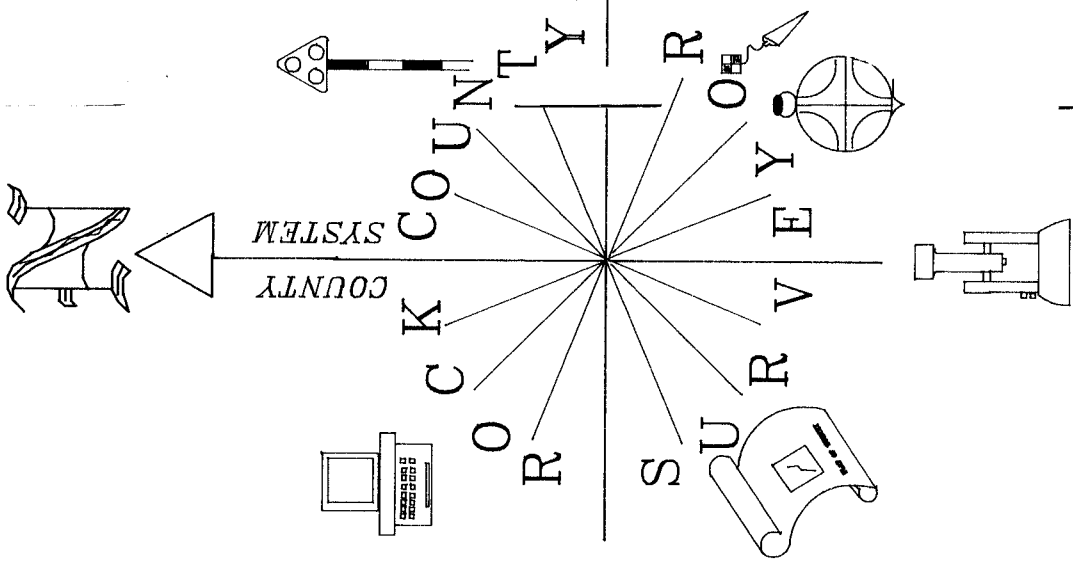

F15