# PLAT AND RECORD

423

PG 433 433

TANESVILLE REC
12/16/75 DAB

O.L. 145 - 149 Assessor's Plat of Milton
Of a Survey on Section 34 T 4 R 13 E. of the 4 P. M. in Milton Township

Rock County, Wisconsin, made September the 4-13 1939

I hereby certify that the following is a correct record of said survey as made by me.

COUNTY BUILDING
IN CITY OF BELOIT
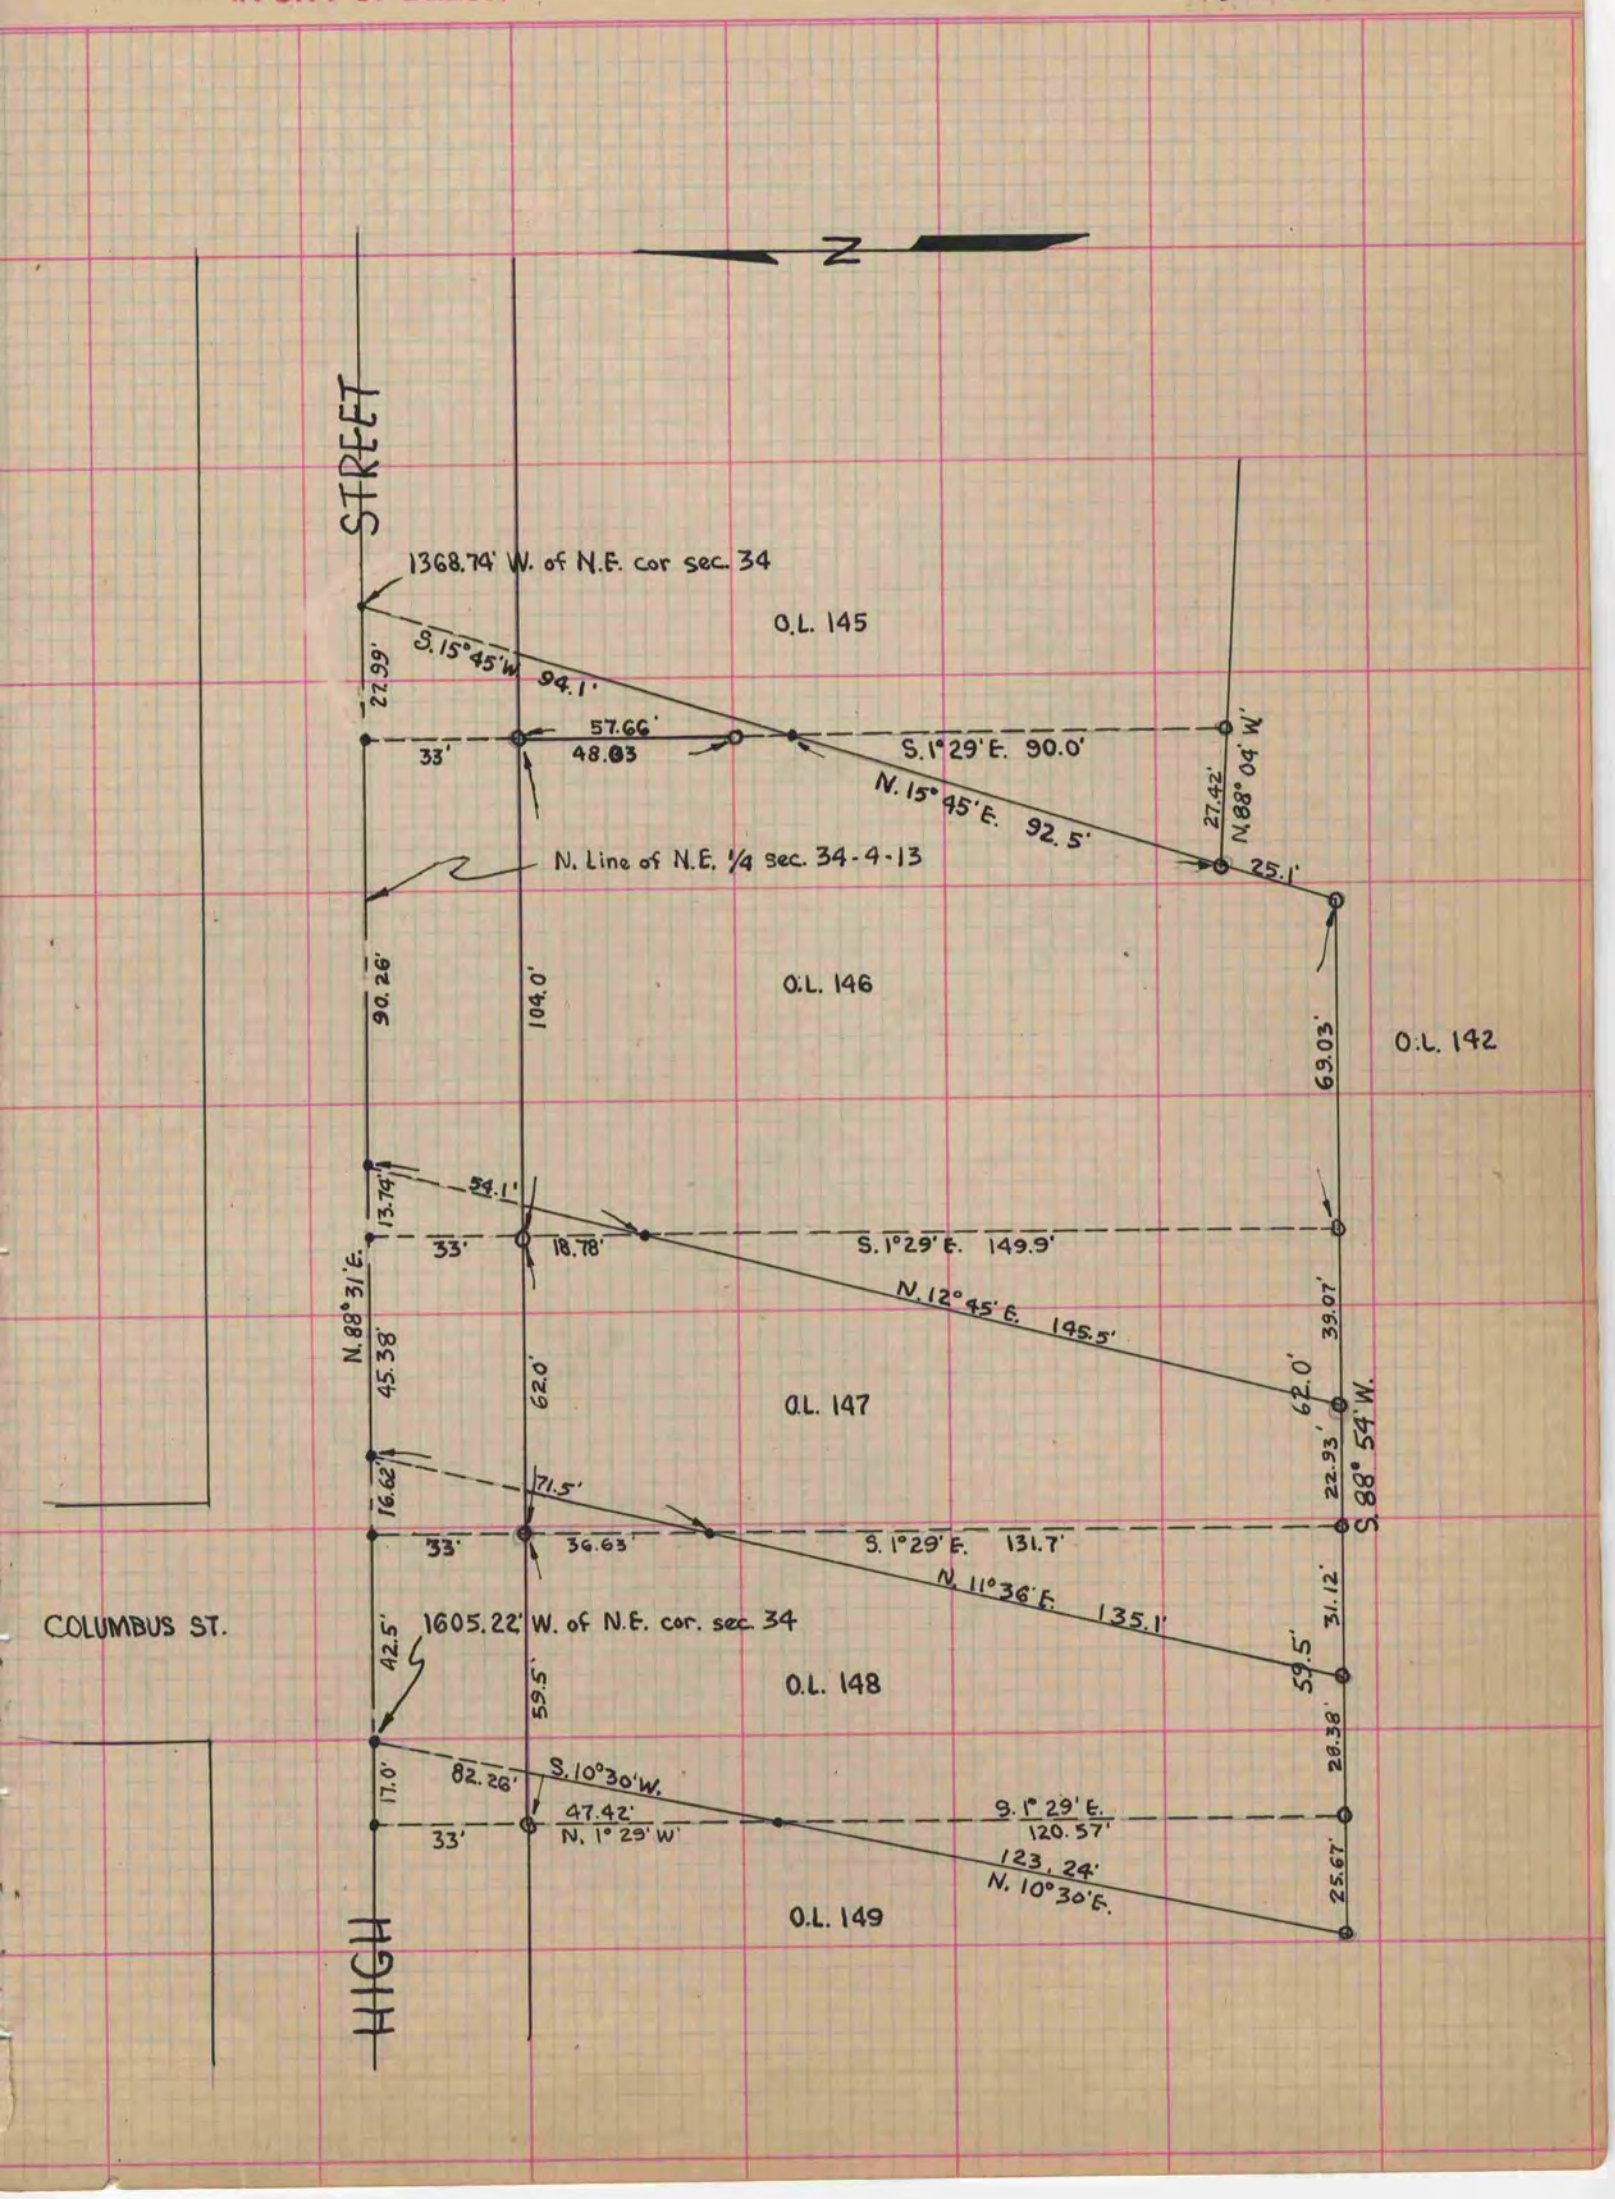
(Signed) B. J. Sunny
County Surveyor.