PLAT AND RECORD

Of a Survey on Section 16 T 2 R 13 E. of the 4 P. M. in La Prairie Township

Rock County, Wisconsin, made October the 4th & 5th 1860

I hereby certify that the following is a correct record of said survey as made by me.

COUNTY BUILDING
IN CITY OF BELOIT

(Signed) Edward Ruger RRB County Surveyor.

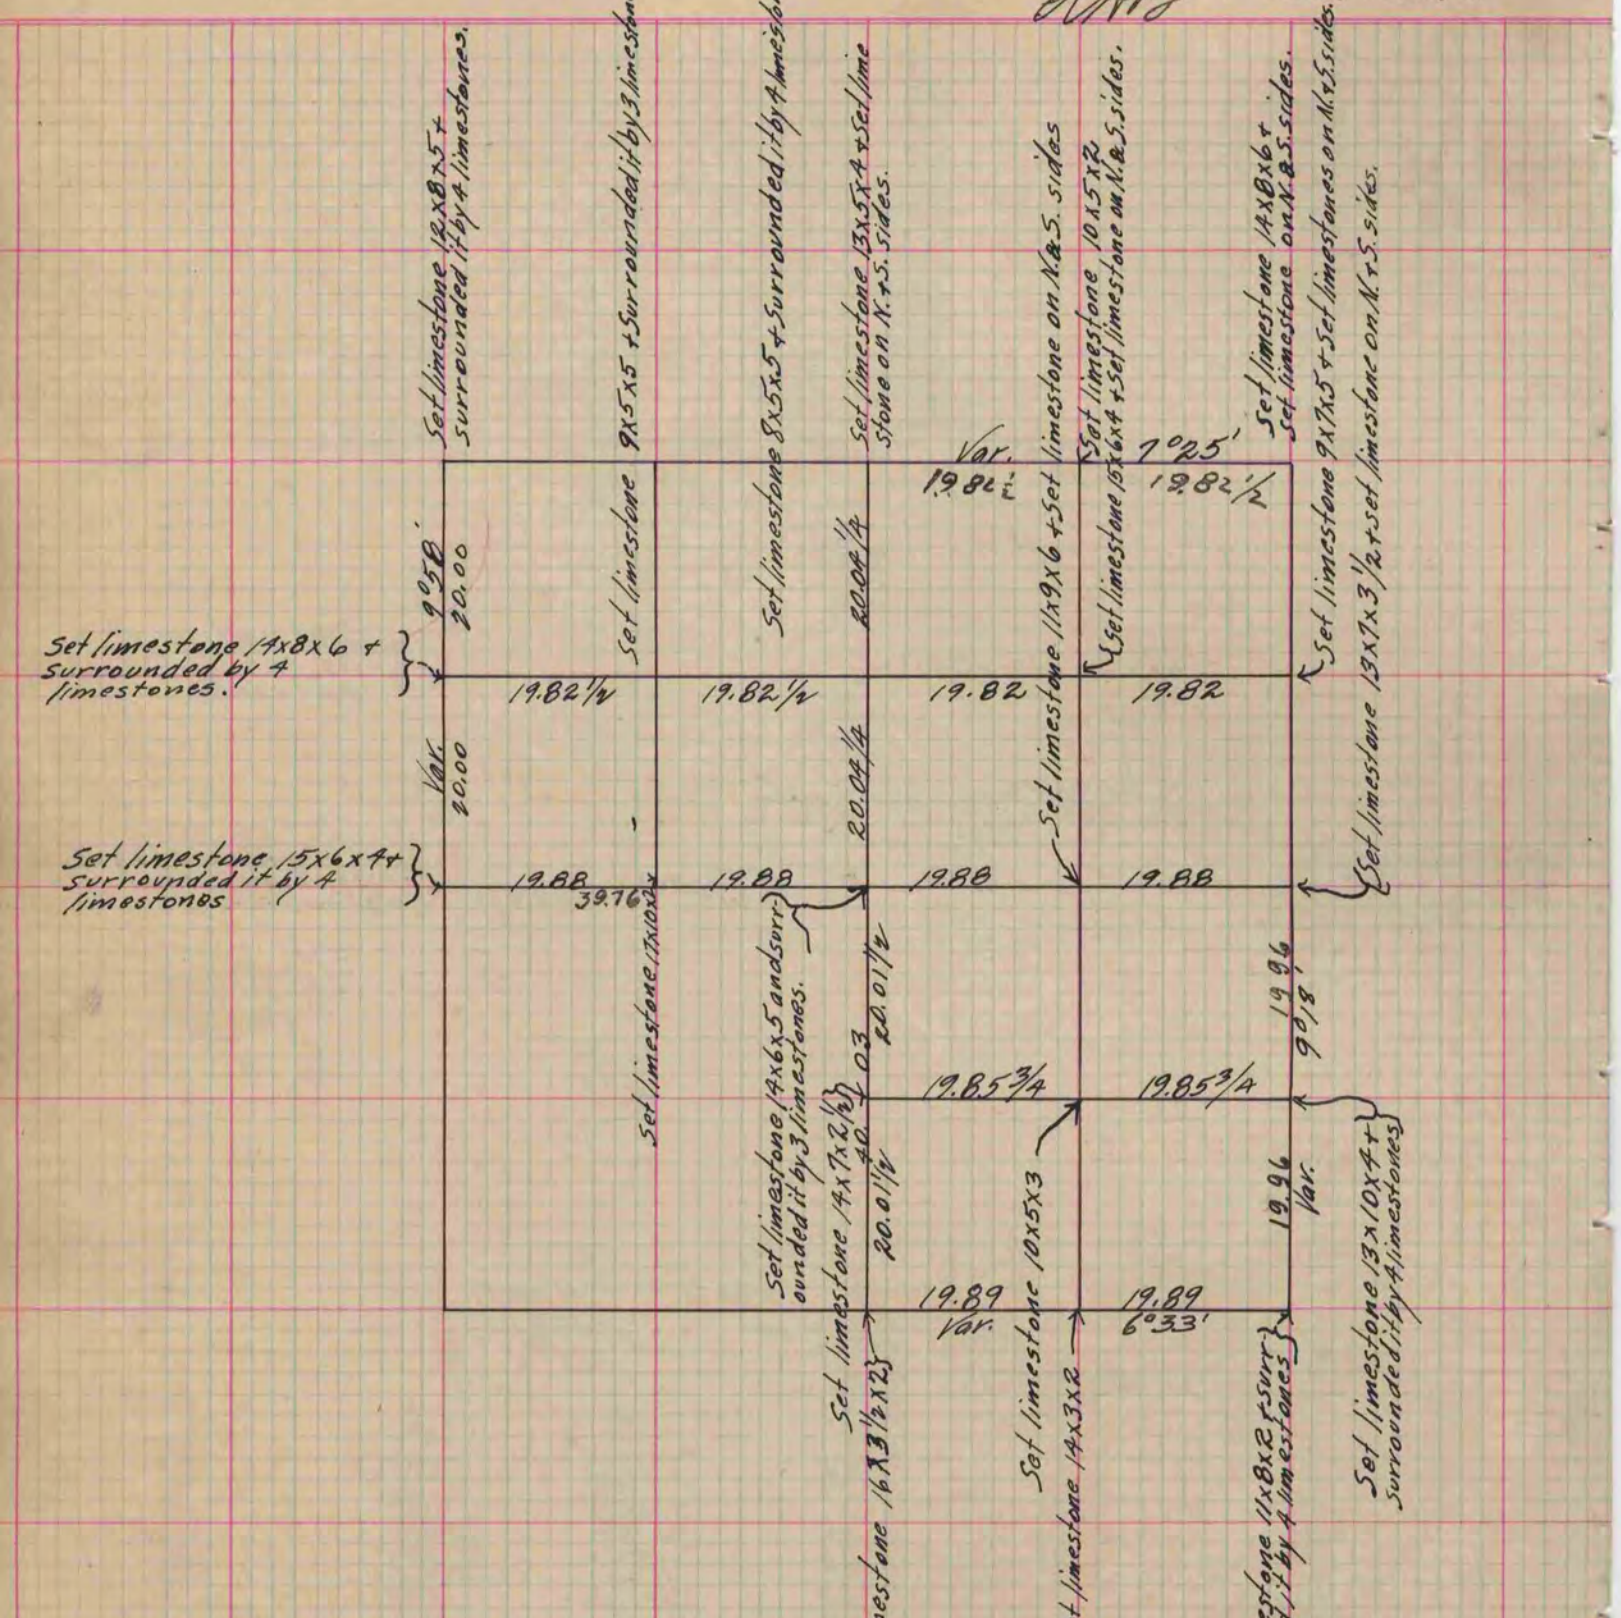

Copied from Page 149 Vol. 1. Original County Surveyor's Record.