PLAT AND RECORD

Of a Survey on Section 8 T 1 R 14 E. of the 4 P. M. in Clinton Township

Rock County, Wisconsin, made May the 4,2+3 1877

I hereby certify that the following is a correct record of said survey as made by me.

COUNTY BUILDING
IN CITY OF BELOIT

(Signed) Edward Ruger
County Surveyor.

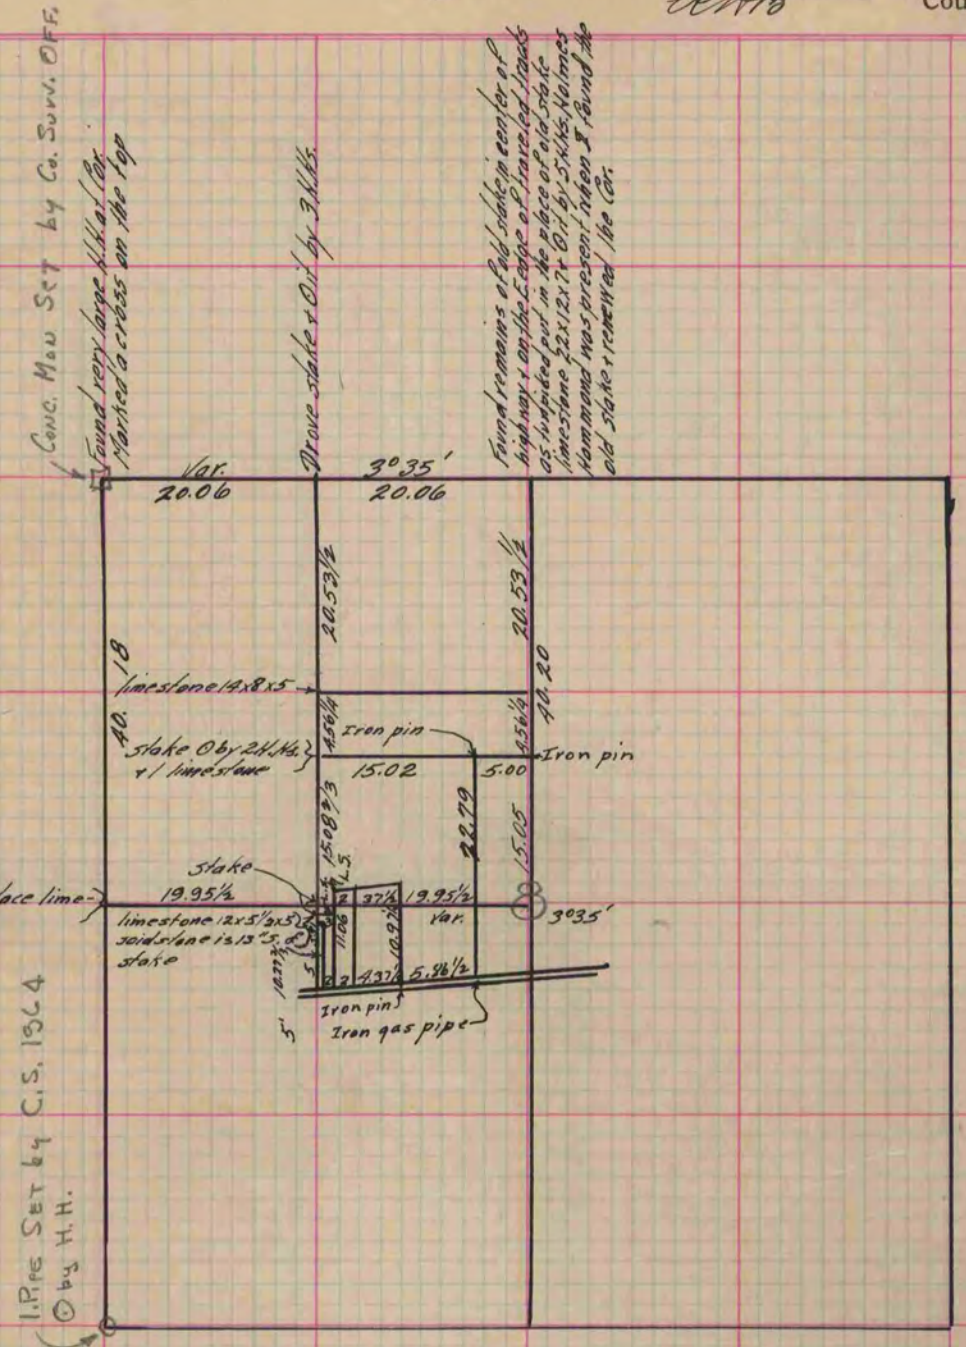

Copied from P. 178 Vol. 2 Original County Surveyor's Record