

U.S. PUBLIC LAND SURVEY MONUMENT RECORD

For Public Land Survey Corners in:

WI ADMINISTRATIVE CODE A-E 7.08 REQUIREMENT

T. 1N., R. 14E

CORNER CODE INDEX

A	2	3	4	5	6	7	8	9	10	11	12	13	14	15	16	17	18	19	20	21	22	23	24	25
B																								
C	6					5					A			3			2						1	
D																								
E																								
F																								
G	1					8			9				10			11							12	
H																								
J																								
K																								
L	18					17			16				15			14							13	
M																								
N																								
O																								
P	19					20			21				22			23							24	
Q																								
R																								
S																								
T	30					29			28				27			26							25	
U																								
V																								
W																								
X	31					32			33				34			35							36	
Y																								
Z																								

CLINTON TWP

ROCK COUNTY WI

IF AVAILABLE
ROCK COUNTY COORDINATES PERFERRED

North _____ Elev. _____

East _____

Hor. Datum _____ Vert. Datum _____

LATITUDE _____ ELLIPS. HT. _____

LONGITUDE _____

GPS (X) _____ TRAVERSE (X) _____

BASED ON THE FOLLOWING CONTROL:

PLACE MONUMENT SYMBOL AT PROPER LOCATION ON ABOVE INDEX

CORNER MONUMENT

WITNESS MONUMENT

(a)

BEARINGS ARE BASED ON:

N 1/4 COR SEC 2

T46N R3E

3rd P.M.

FIELD BOOK _____ PAGE # _____

SHEET 1 OF 7

SHOW A PLAN VIEW DRAWING DEPICTING THE CORNER MONUMENT AND SURROUNDING PHYSICAL FEATURES, INCLUDING THE EXCAVATION AREA AND DEPTH.

PLANNING & ZONING COMMITTEE ADOPTED THE ABOVE FORM ON 12/2/1982

CORNER CODE 210(1)

CL7510 N 1/4 COR SEC 2 T46N R3E 3RD P.M.

(B) Describe any record evidence, monument evidence, occupational evidence, testimonial evidence or any other material evidence you considered, and whether the monument was found or placed.

1833 LYON EAST ALONG THE SOUTH LINE OF SEC 33

2640 SET POST FOR 1/4 SECTION CORNER

BLACK OAK 5 N71 1/2W 30

BUR OAK 16 N41 1/2E 276

5280 HAVING PASSED OVER A WET GLADE, SET A POST FOR CORNER TO SECS #33 & 34. BUR OAK 20 N65W 37, BUR OAK 15 N72E 200. LAND ROLLING AND THICKLY TIMBERED WITH BUR OAK, EXCEPT IN THE GLADES.

1848 TERRITORIAL ROAD RECORDS. SHEET 1 PG 66 & SHEET 2 PG 67. JOHN McKEY, ROBBINS, WHITE WERE COMMISSIONERS APPOINTED BY THE LEGISLATURE. E.G. WHEELER, SURVEYOR SIGNED THE FOLLOWING CERTIFICATE: NOTE: AS WILL BE SEEN BY THE MINUTES OF THE CENTER LINE OF THE ROAD STRIKES THE EAST LINE OF ROCK COUNTY, 50 LINKS (33') NORTH FROM THE STATE LINE & CONTINUES PARALLEL TO THE STATE LINE UNTIL IT STRIKES THE EAST LINE OF SEC 36 T1N R12E. IT THEN ANGLES TO THE NORTH WEST MAKING 3 SMALL ANGLES TO THE TERMINUS(?). STAKES ARE SET IN THE CENTER LINE. THEY ARE MARKED & NUMBERED & ARE WITNESSED WHERE EVER LINE COULD BE FOUND CONVENIENT. E.G. WHEELER SURVEYOR.

1993 FIDIS Z11. SET 5/8" REBAR. HE DECLARED THE CORNER LOST REESTABLISHED THROUGH SINGLE PROPORTIONATE BETWEEN TWO FOUND ALUMINUM MONUMENTS. SKETCH CALLS FOR AN ALUMINUM MONUMENT AT THE S 1/4 COR OF SEC 32 AND THE SE CORNER OF SECTION 33.

FOUND REBAR AND TIES AS SHOWN. DID NOT FIND ANY MARKINGS IN THE ASPHALT THAT WOULD INDICATE THE MONUMENT WAS EVER EXCAVATED FOR.

C) Was the corner restored through acceptance of (1) an obliterated evidence location, or, (2) a found perpetuated location?

WISCONSIN ADOPTED THE "MANUAL OF INSTRUCTIONS FOR THE SURVEY OF THE PUBLIC LANDS OF THE UNITED STATES" (1973). SEE WI STATUTES 59.62. THE MANUAL, SECTION 5-19, REQUIRES AN ORDER OF THE UNITED STATES SUPREME COURT OR AUTHORIZATION OF THE ADJOINING STATES PLUS CONGRESSIONAL APPROVAL TO REPLACE A LOST STATE BOUNDARY MONUMENT. SINCE AUTHORIZATION MUST BE SECURED BEFORE A LOST STATE BOUNDARY MARKER CAN BE RESET, I DO NOT ACCEPT THIS MONUMENT BUT ONLY PERPETUATE ITS' LOCATION. ED GARVEY DEPUTY ATTORNEY GENERAL FOR THE WISCONSIN DEPARTMENT OF JUSTICE ATTORNEY GENERAL'S OFFICE WROTE AN OPINION DATED OCTOBER 18, 1983. THE OPINION DEALS WITH THIS ISSUE.

D) Describe any material discrepancy between the location of the corner as restored or reestablished and the location of that corner as previously restored or reestablished by distance and direction. Show the discrepancy on the plan view drawing under (a), above. Show the distances between the corner as previously restored or reestablished and (1) the corner as restored or reestablished, and (2) to at least 4 of the witness monuments shown on the drawing in (a),

(E) Was the corner reestablished through lost corner proportionate methods? If so, show the method, including the directions and distances to other public land survey corners used as evidence or used for proportioning the corner location.

I, Donald Barnes, hereby certify that the corner location as identified by the corner code index was determined by me under by direction and control and that this U.S. Public Land Survey Monument Record is correct and complete to the best of my knowledge and belief.

seal

Donald Barnes

3-28-1997 emboss

Number of included sheets ~~294~~ 2

CORNER CODE



A-E 7.08 REQUIREMENT

210(1)

Donald
Barnes
3-28-1997

3 of 3

(1) of 2

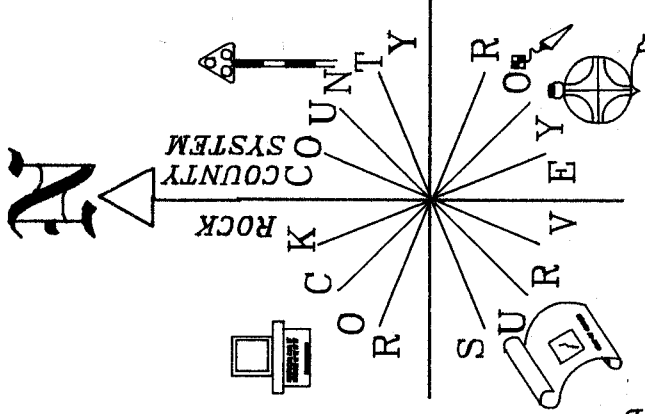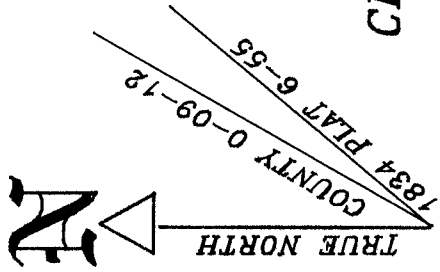

INTENT OF CONGRESS 42-30 LATITUDE
NAD83 LAT 42-29-34.52687'
LONG. 88-50-43.42483

CLINTON TWP T1N R14E

FIDIS 1983 589-37-43E 7955.16
S88-09-59E 7955.09

S 1/4 COR
SEC 32
FD ALUM. MON.

FIDIS 1993 5303.44
N88-09-57W 5303.41

FIDIS 1993 2651.72
LYON 1833 2640

SW COR
SEC 33

FD NOTHING
NO-30-09E 2649.78
TO FIDIS'S COMPUTED
POSITION

FIDIS 1993 2651.72
LYON 1833 2640

S 1/4 COR
SEC 33
FD REROD

N88-10-02W 2651.71
FIDIS 1993 2651.72
LYON 1833 2640

S88-08-35E 1483.40'

NW COR
SEC 2
FD PK

SPAULDING DEC 1838 1162.92'

S88-11-44E 1168.28

BETWEEN FIDIS'S CORNERS
PLAT 1838 2565.42

T46N R3E 3rd P.M.

SPAULDING
2174.7

SW COR
SEC 2

S88-10-02E 1243.33'

N 1/4 COR
SEC 2
FD PK

N88-10-29W 3819.97
PLAT 1838 2630.1

SE COR
SEC 33

1838 SPAULDING 1247.4

SPAULDING 1838
1896.52'

SE COR
SEC 2



The State of Wisconsin
Department of Justice

123 West Washington Avenue
Mailing Address: P.O. Box 7857
Madison, Wisconsin 53707

October 18, 1983

Bronson C. La Follette
Attorney General

Ed Garvey
Deputy Attorney General

DATE RECEIVED
10/30/83
ROCK COUNTY CORPORATION COUNSEL
JANESVILLE, WISCONSIN

Mr. Thomas A. Schroeder
Corporation Counsel
51 South Main Street
Janesville, Wisconsin 53545

Re: Survey of boundary between Wisconsin and Illinois

Dear Mr. Schroeder:

In response to your letter of September 23, 1983, concerning replacement of a lost monument marking the Wisconsin-Illinois state line between Rock County, Wisconsin, and Winnebago County, Illinois, I submit the following:

The Wisconsin Constitution, article II, section 1, narrates generally the Wisconsin-Illinois boundary as follows:

"Thence down the center of the main channel of that river [Mississippi] to the northwest corner of the state of Illinois; thence due east with the northern boundary of the state of Illinois to the place of beginning, as established by "An act to enable the people of the Illinois territory to form a constitution and state government, ..."

The original intent of Congress was to establish the boundary at 42° 30' north latitude. However, errors occurred in determining the precise latitude by the original surveyors so that the boundary actually established tilts above that latitude at the Mississippi River and below that latitude at Lake Michigan with the fulcrum lying somewhere in eastern Green County, Wisconsin. Thus, care must be taken when replacing lost state line measurements on this line.

Wisconsin has adopted the Manual of Instructions for the Survey of the Public Lands of the United States (1973) for such surveys. See sec. 59.62, Stats. The Manual, section 5-19, requires an order of the United States Supreme Court or authorization of the adjoining states plus congressional approval to

MICROFILMED

replace a lost state boundary monument. Therefore, it is my opinion that such authorizations must be secured before a lost state boundary marker can be reset.

Sincerely yours,

Donald Baines
4-28-97

B. C. La Follette
Bronson C. La Follette
Attorney General

210(1)

REPORT

OF THE

SECRETARY OF THE TREASURY,

With a report of the survey of the northern boundary line of Illinois,
furnished in obedience to a resolution of the Senate of the 22d instant.

DECEMBER 29, 1835.—Referred to the select committee on the admission of Michigan, &c.
MARCH 10, 1835.—Ordered to be printed.

TREASURY DEPARTMENT.

December 28, 1835.

SIR: In obedience to the resolution of the Senate of the 22d instant, directing the Secretary of the Treasury to cause to be laid before the Senate the report and survey of the commissioners appointed to survey and mark the northern boundary line of the State of Illinois, in pursuance of the law of the United States passed April 19, 1831, I have the honor herewith to transmit to the Senate a report from the Commissioners of the General Land Office, to which this resolution was referred.

I am, very respectfully,

LEVI WOODBURY,
Secretary of the Treasury.

Hon. M. VAN BUREN,
Vice President of the United States,
and President of the Senate.

GENERAL LAND OFFICE,

December 23, 1835.

SIR: In obedience to a resolution of the Senate of the United States of the 22d ultimo, "that the Secretary of the Treasury be directed to cause to be laid before the Senate the report and survey of the commissioners appointed to survey and mark the northern boundary line of the State of Illinois, in pursuance of the law of the United States passed April 19, 1831," and which you have referred to this office, I have the honor to transmit herewith a copy of the report made to the President of the United States by the commissioners aforesaid, (and which was filed in the Department of State,) showing the result of their operations under the law referred to.

I have the honor to be, very respectfully,

Your obedient servant,

ETHAN A. BROWN,
Commissioner.

Hon. LEVI WOODBURY,
Secretary of the Treasury.

MICROFILMED

Donald Barnes
4-28-97

Z10(1)

GALENA, Illinois, January 29, 1833.

Sir: I have the honor herewith to enclose the report of the board of commissioners appointed to ascertain and mark the northern boundary line of the State of Illinois, a duplicate of which report has this day been forwarded to the Executive of the State.

With profound respect,

I am, sir, your very obedient servant,

LUCIUS LYON,
Commissioner on the part of the U. S.

To ANDREW JACKSON,
President of the United States.

GALENA, ILLINOIS,

January 29, 1833.

Sir: In obedience to the directions of an act of the General Assembly of the State of Illinois, entitled "An act to ascertain and survey the northern boundary of this State," and an act of the Congress of the United States, entitled "An act to ascertain and mark the line between the State of Alabama and the Territory of Florida, and the northern boundary of the State of Illinois, and for other purposes," the commissioners appointed under said acts have the honor to report:

That as soon as practicable after the appointment of the commissioner on the part of the United States, the board, pursuant to arrangement, met at Galena, in the latter part of October, 1831, preparatory to commencing the survey which is now just completed. Mr. Daniel R. Davis, on the part of the United States, and Mr. Andrew M. Braley, on the part of the State, were engaged as assistant observers and surveyors for so much of the boundary as might be established during the current year; and the party, with the necessary instruments and outfit, proceeded immediately to a place on the Mississippi river near the latitude in which the line was to be established, for the purpose of commencing operations.

The weather at that time was exceedingly unfavorable for astronomical observations, and more than a month elapsed before a series could be made to the entire satisfaction of the board. This, however, having been done, a stone about seven feet long, and estimated to weigh about five tons, was heaved at one end and set firmly in the ground at high water mark, on the left or east bank of the Mississippi river, in latitude forty-two degrees and thirty minutes north from the place of beginning.

On the south side of the stone was cut the word "Illinois;" on the north side "Michigan;" on the west "N. boundary of Illinois, lat. 42° 30' N."

Having erected this monument at the place of beginning, in the latitude defined to be the northern boundary of the State by an act of Congress, entitled "An act to enable the people of the Illinois Territory to form a constitution and State government," passed the eighth day of April, one thousand eight hundred and eighteen, the survey of the boundary was commenced and continued due east ten miles sixty-nine chains

and thirty links, to its intersection with the fourth principal meridian of the surveys of the public lands, six miles and twenty chains north of the town of Galena.

A mound of earth six feet square at the base and six feet high, was erected to mark the place of intersection, which is half a mile east of the main road leading from Galena to Mineral point, in the mining district, and from it a white-oak tree, twenty inches in diameter, bears north thirty-one and a half degrees east, six chains and fifty-six links distant.

Here, on account of the lateness of the season and the inclemency of the weather, the work was discontinued for the winter, with the intention that it should be resumed as early as practicable on the following spring. As due, however, to the interest felt in the establishment of the boundary, by the citizens of the State and Territory living near it, on either side, before leaving the survey, a random line was run out eighteen miles due east, to a point beyond all the settlements in that direction.

It was also agreed by the board before its adjournment, that, as a measure recommended by considerations of economy, there should be employed on the remainder of the line but one person with the compass, and, in pursuance of this arrangement, the present commissioner on the part of the State was then appointed sole surveyor.

The early indications of hostility on the part of the Indians, through some part of whose country the line would run, prevented the meeting of the board in the spring; and after the settlement of the disturbance on the frontier, it was not until the last of October, 1832, that arrangements could be made to resume the work.

About that time the surveyor arrived, and the business was recommenced under the direction of one of the board who had been some time present; and while the commissioner on the part of the State, (Hiram Bates, Esq.) was away expected, information was received of his sickness and death, which had the appointment of the present commissioner (to wit, Andrew M. Braley) on the part of the State, and the same time with the Executive of the State, and the assistance of the necessary assistants having been engaged, the survey was resumed, and the work advanced as rapidly as the high state of water in the rivers and streams, and a due regard to accuracy would permit.

From the season with the fourth principal meridian, the point where the work was on the preceding year, the line was continued east about seventy miles to Rock river, where, after a series of celestial observations, it was found that, in the distance already run, we had diverged from the meridian four seconds in latitude—a distance so great as to bear the same proportion to the arc as the error would make a correction.

This divergence is attributable to the great and frequent fluctuations of the variation of the magnetic needle, and the general decrease of its variation in going eastwardly in this longitude, the effect of which, although frequently observed, was not made to ascertain the true meridian, is sufficient to only to counteract the tendency of the line towards the equator, but also to account satisfactorily for the error here found.

Having offset due south to the latitude 42° 30' N., and established, in a permanent and conspicuous manner, a starting point on the left or east

Donald Barnes
A-28-197

MICROFILMED

210 (1)
211

bank of Rock river, the survey was continued eastward, and scientific observations, both to ascertain the latitude and variation of the compass, being frequently made, the line was extended through to Lake Michigan, with so little variation from the true latitude as to render correction unnecessary.

At its intersection with the western shore of the lake, it was the intention of the commissioners to establish a permanent stone monument similar to the one set up at the beginning of the line on the Mississippi; the scarcity, however, and the great expense of procuring stones, induced them to relinquish the idea, and to rely on such natural monuments as were natural, as they were enabled to make and to describe.

An oak post a foot square and nine feet long was set up in the ground to the depth of five feet in a small thicket of willows, about one chain from the water's edge. This post stands at the termination of the surveyed line, and from it a black oak tree, fifteen inches in diameter, bears south twenty degrees east, three hundred and sixty-two links distant; a black oak twelve inches in diameter, bears north forty-two degrees and a half degrees west, one hundred and fifty-six links distant; a black oak twelve inches in diameter, bears north forty-two degrees and a half degrees west, one hundred and fifty-six links distant; a black oak twelve inches in diameter, bears north twenty-five degrees west, one hundred and fifty-two links distant; a black oak twelve inches in diameter, bears north one degree west, three hundred and eighty-four links distant; a black oak ten inches in diameter, bears south thirty degrees east, two hundred and twenty-eight links distant.

The three first trees are marked with a nail in a hole near the ground and facing the post; the three last are not blazed but have nails driven into them, out of sight, about three feet from the ground on the side nearest the post.

In addition to this it may be of service to add, that the post stands on a bend of the lake shore, called by the Indians "Black-oak point." The bearing of the shore from half a mile south to two and a half miles north, is about north fourteen degrees west, and at the distance of about half a mile north of the post a prairie extends to the border of the lake. Point Mitch-ee-ee-ton bears north three degrees and twenty minutes east, fifteen and one-fourth miles distant, and north of the line about six or seven miles a small stream called "Pike creek," empties into the lake.

The post is estimated to be forty miles north from Chicago, and ten miles north of a place known by the name of "Little Fort."

Having marked, as permanently and conspicuously as practicable, the termination of the boundary on the lake, and procured from Chicago the necessary supplies, the commissioners and party returned westward for the purpose of making the requisite correction of the line from Rock river to a point eighteen miles east of the fourth principal meridian.

After considerable difficulty and some delay, on account of high water and bad weather, this was finished on the seventeenth instant, and the party returned to Galena, having completed the entire survey.

In marking the boundary it was found impracticable, without incurring an unwarrantable expense, to do it in the manner prescribed by the second section of an act of the General Assembly of the State of Illinois, entitled "An act to amend an act," &c., passed February 5, 1831.

And, as the best substitute within the means of the board, it was deemed expedient to mark the line by blazing the trees as in the surveys of the public lands of the United States, but in a more conspicuous manner, and in lieu of the stones required to be set up, at the distance of every five miles, corners were made at the end of every mile and half mile, after the manner of the public surveys.

The distances from the monument on the Mississippi to the principal points on the line, which may be regarded as natural marks to determine its location, are as follows, viz.

- 4 70.00, to a point one mile and five chains south of the southern base of the Sinsinaway mound, in the mining district.
- 10 69.50, to the fourth principal meridian, at a point six and one-fourth miles north from the town of Galena.
- 12 57.80, to the north branch of Fever river, running south, half a mile south of a small place called "Buncomb."
- 18 10.00, to a point about thirty chains south of the White-oak springs on the road from Galena to Fort Winnebago.
- 21 00.00, to a point two and a half miles north of Gratio's grove.
- 43 1.39, to a post set on the right or west bank of the Peck-a-to-lake river, which is here four chains wide and runs south.
- 70 29.00, to Sugar river, which is about two chains wide and runs south.
- 81 31.09, to a post on the left or east bank of Rock river, ten chains above its junction with Turtle river. Rock river is here about seven chains wide and runs south.
- 125 9.10, to a post on the right or west bank of Fox river, which is here 2.17 chains wide and runs south.
- 138 8.99, to the west bank of the River des Plaines, which is about eighty links wide and runs south.
- 144 48.80, to a post before described, standing on the border of Lake Michigan, the termination of the survey.

The country through which this boundary line has been established having been the principal theatre of the late Indian war, is now so well and so generally known as scarcely to require description. Throughout its whole extent, from the Mississippi to the lake, it is with few exceptions made up of open wood land, (timbered chiefly with oak,) with prairies of various size and quality interspersed. Some marshes and swamps are found, but they are small and few in number. In the mining district, which there is good reason to believe extends to within thirty miles of the lake, the soil is almost invariably good, the surface rolling, the waters pure and abundant, and it requires not the spirit of prophecy to foretell, that when surveyed and offered for sale, the whole country will within a few years attract and sustain a numerous and thriving population.

All of which is respectfully submitted,

JOHN MESSINGER,

Commissioner of the State of Illinois.

LUCIUS LYON,

Commissioner on the part of the United States.

To ANDREW JACKSON,
President of the United States.

MICROFILMED

Dwight Barnes
4-28-97

210 (1)