77

COUNTY BUILDING
IN CITY OF BELOIT

# PLAT AND RECORD

Of a Survey on Section 23 T 1 R 12 E. of the 4 P. M. in Beloit Township

Rock County, Wisconsin, made April the 1919

I hereby certify that the following is a correct record of said survey as made by me.

R. H. Batterman

County Surveyor.
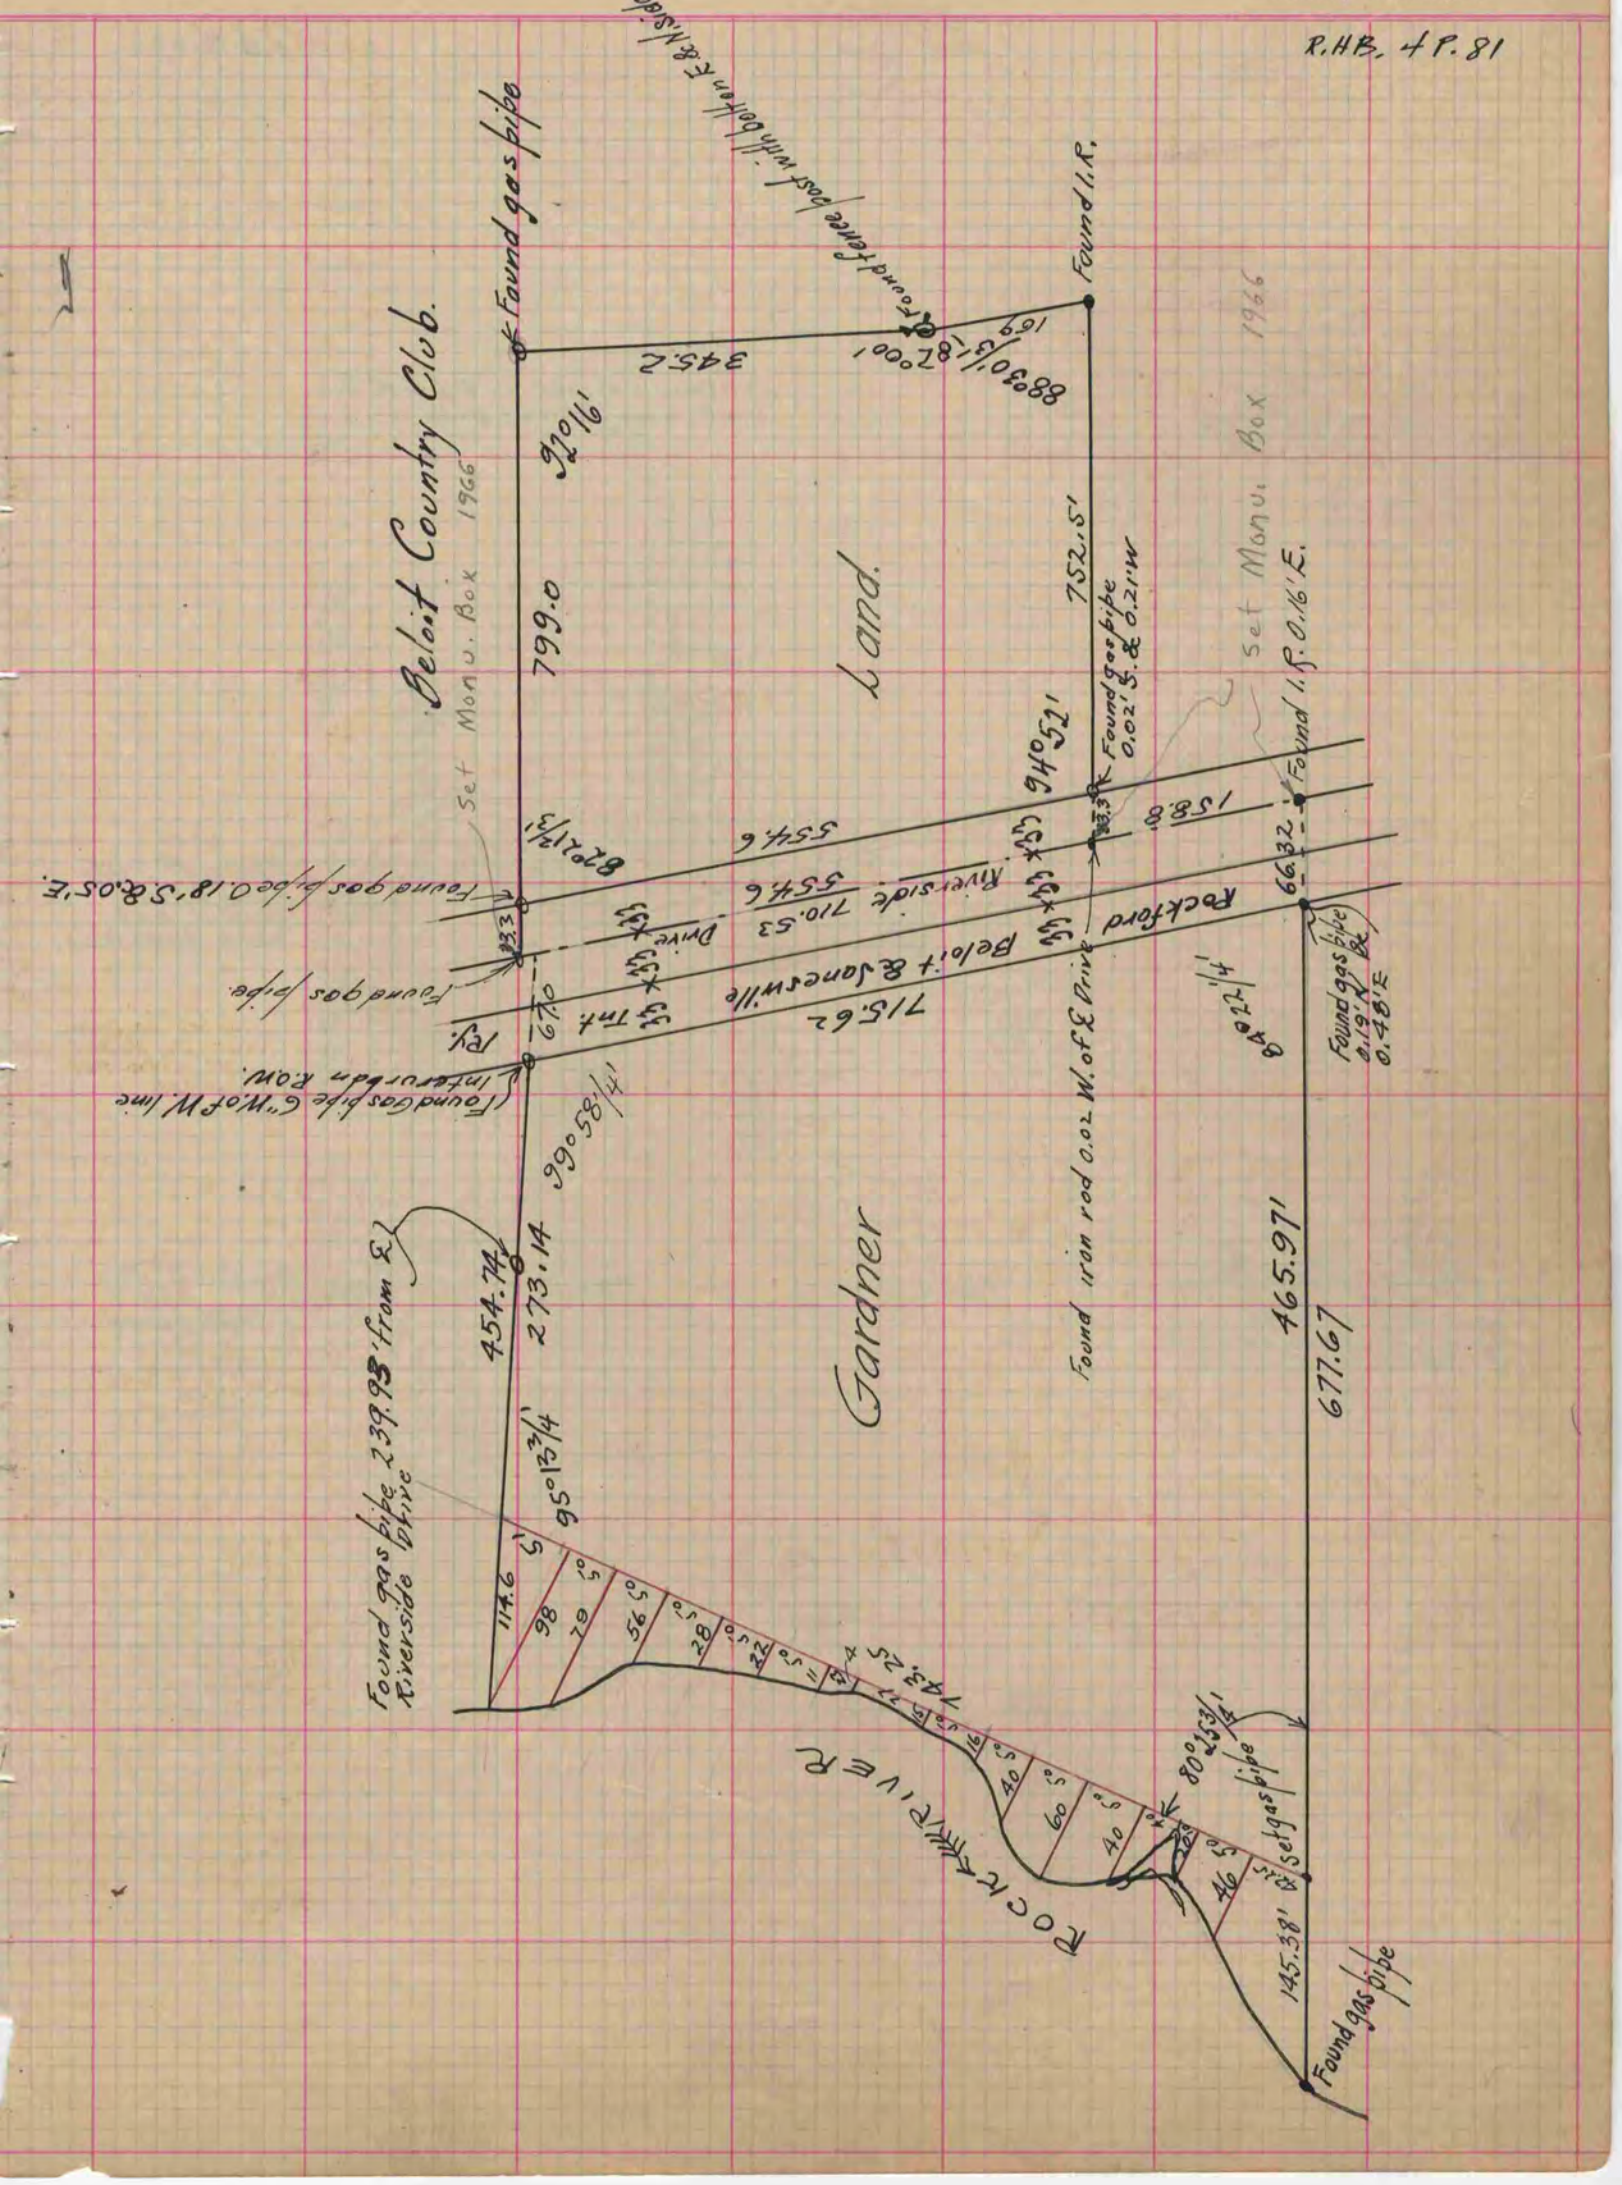
R.H.B. 4 P. 81