Paper weight _____ minimum) Black ink required

U.S. PUBLIC LAND SURVEY MONUMENT RECORD

For Public Land Survey Corners in:

T. 3 N., R. 12 E

WI ADMINISTRATIVE CODE A-E 7.08 REQUIREMENT

CORNER CODE INDEX

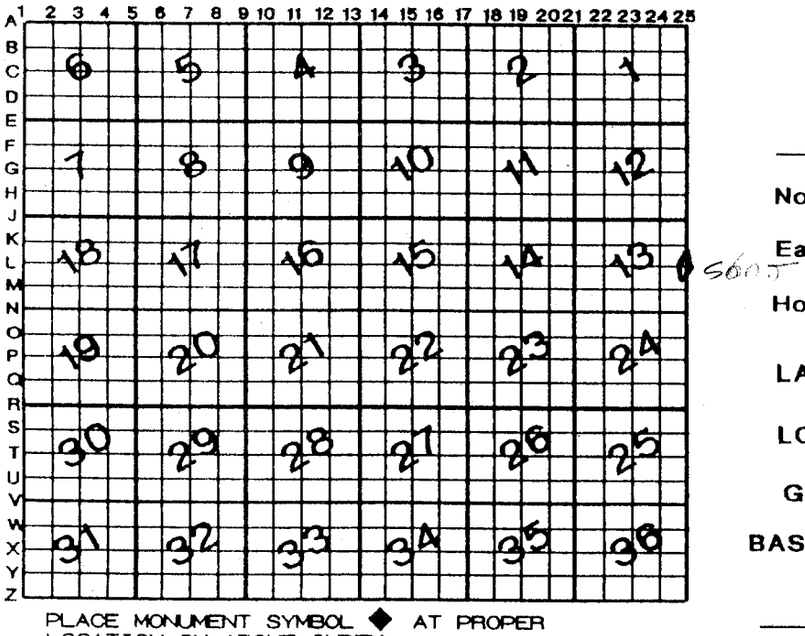

PLACE MONUMENT SYMBOL ◆ AT PROPER LOCATION ON ABOVE INDEX

JANESVILLE TWP

ROCK COUNTY WI

IF AVAILABLE
ROCK COUNTY COORDINATES PERFERRED

North 80,769,416M Elev. _____

East 680,835.365

Hor. Datum _____ Vert. Datum _____

LATITUDE _____ ELLIPS. HT.

LONGITUTE _____ _____

GPS (X) ___ TRAVERSE (X) ___

BASED ON THE FOLLOWING CONTROL:

(a) ◆ CORNER MONUMENT ○ WITNESS MONUMENT

LIMESTONE

NOTE ON PLAT: COORDINATES & BEARINGS ON THIS PLAT ARE ORIENTED TO THE WI COORDINATE SYSTEM SOUTH ZONE, NAD 83. ALL PLAT DISTANCES ARE GROUND LENGTH AND MAY BE CONVERTED TO GRID LENGTH BY MULTIPLYING THE DISTANCE BY THE GRID FACTOR PROVIDED ON THE DETAIL SHEETS.

WIDOT PROJ. #5569-03-21 DATE: MAY 19 1995

BEARINGS ARE BASED ON:

S89-23-36E

N1/4 13 2665.70 NE 13

2647.26 N01-09-43W

E1/4 13

NAD 83
264,990.99
2,233,707.36 FT

283,654.82 FT COUNTY
495,899.21

4-02-04

FIELD BOOK _____ PAGE # _____ SHEET 1 OF 1

SHOW A PLAN VIEW DRAWING DEPICTING THE CORNER MONUMENT AND SURROUNDING PHYSICAL FEATURES, INCLUDING THE EXCAVATION AREA AND DEPTH.

PLANNING & ZONING COMMITTEE ADOPTED THE ABOVE FORM ON 12/2/1982

CORNER CODE L-25