PLAT AND RECORD

Of a Survey on Section 9 T 2 R 9 E. of the 4 P. M. in ..... Township

Rock County, Wisconsin, made Nov. the 3+4 1893

I hereby certify that the following is a correct record of said survey as made by me.

COUNTY BUILDING
IN CITY OF BELOIT

(Signed) O. G. Bleedorn
RHB
County Surveyor.

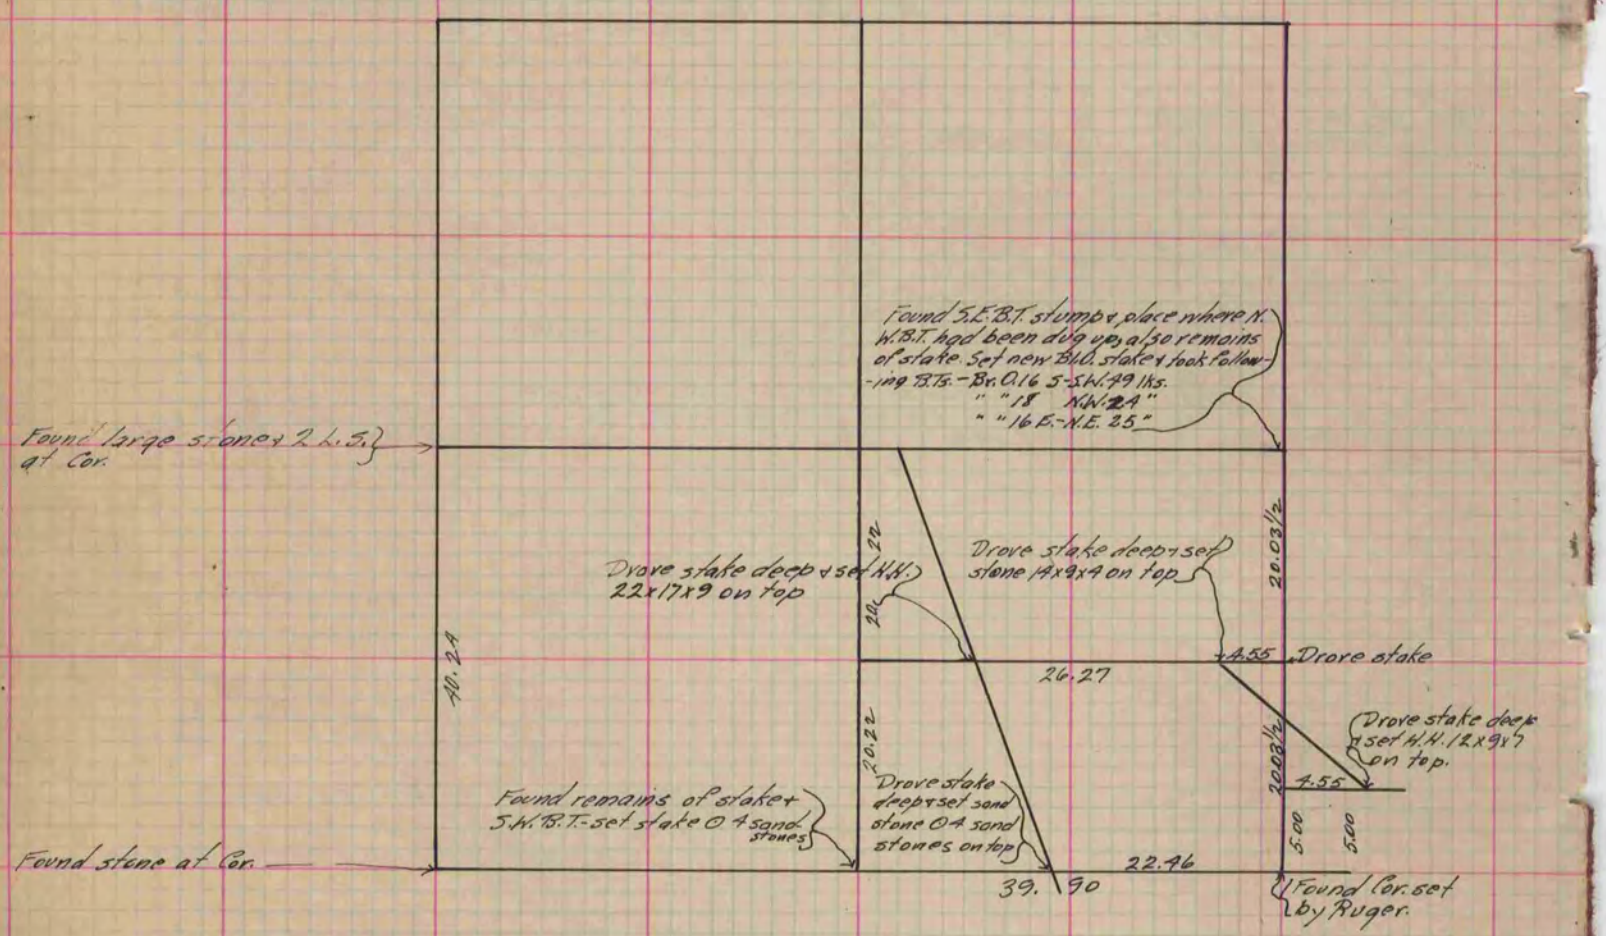

Copied from P. 375 Vol. 2 County Surveyor's Record.