422

PG 432 JANESVILLE REC

12/16/75 DAB

PLAT AND RECORD

Of a Survey on Section 27 T 4N R 10 E. of the 4 P. M. in UNION Township

Rock County, Wisconsin, made MARCH the 3rd 1958

I hereby certify that the following is a correct record of said survey as made by me.

COUNTY BUILDING
IN CITY OF BELOIT

County Surveyor.
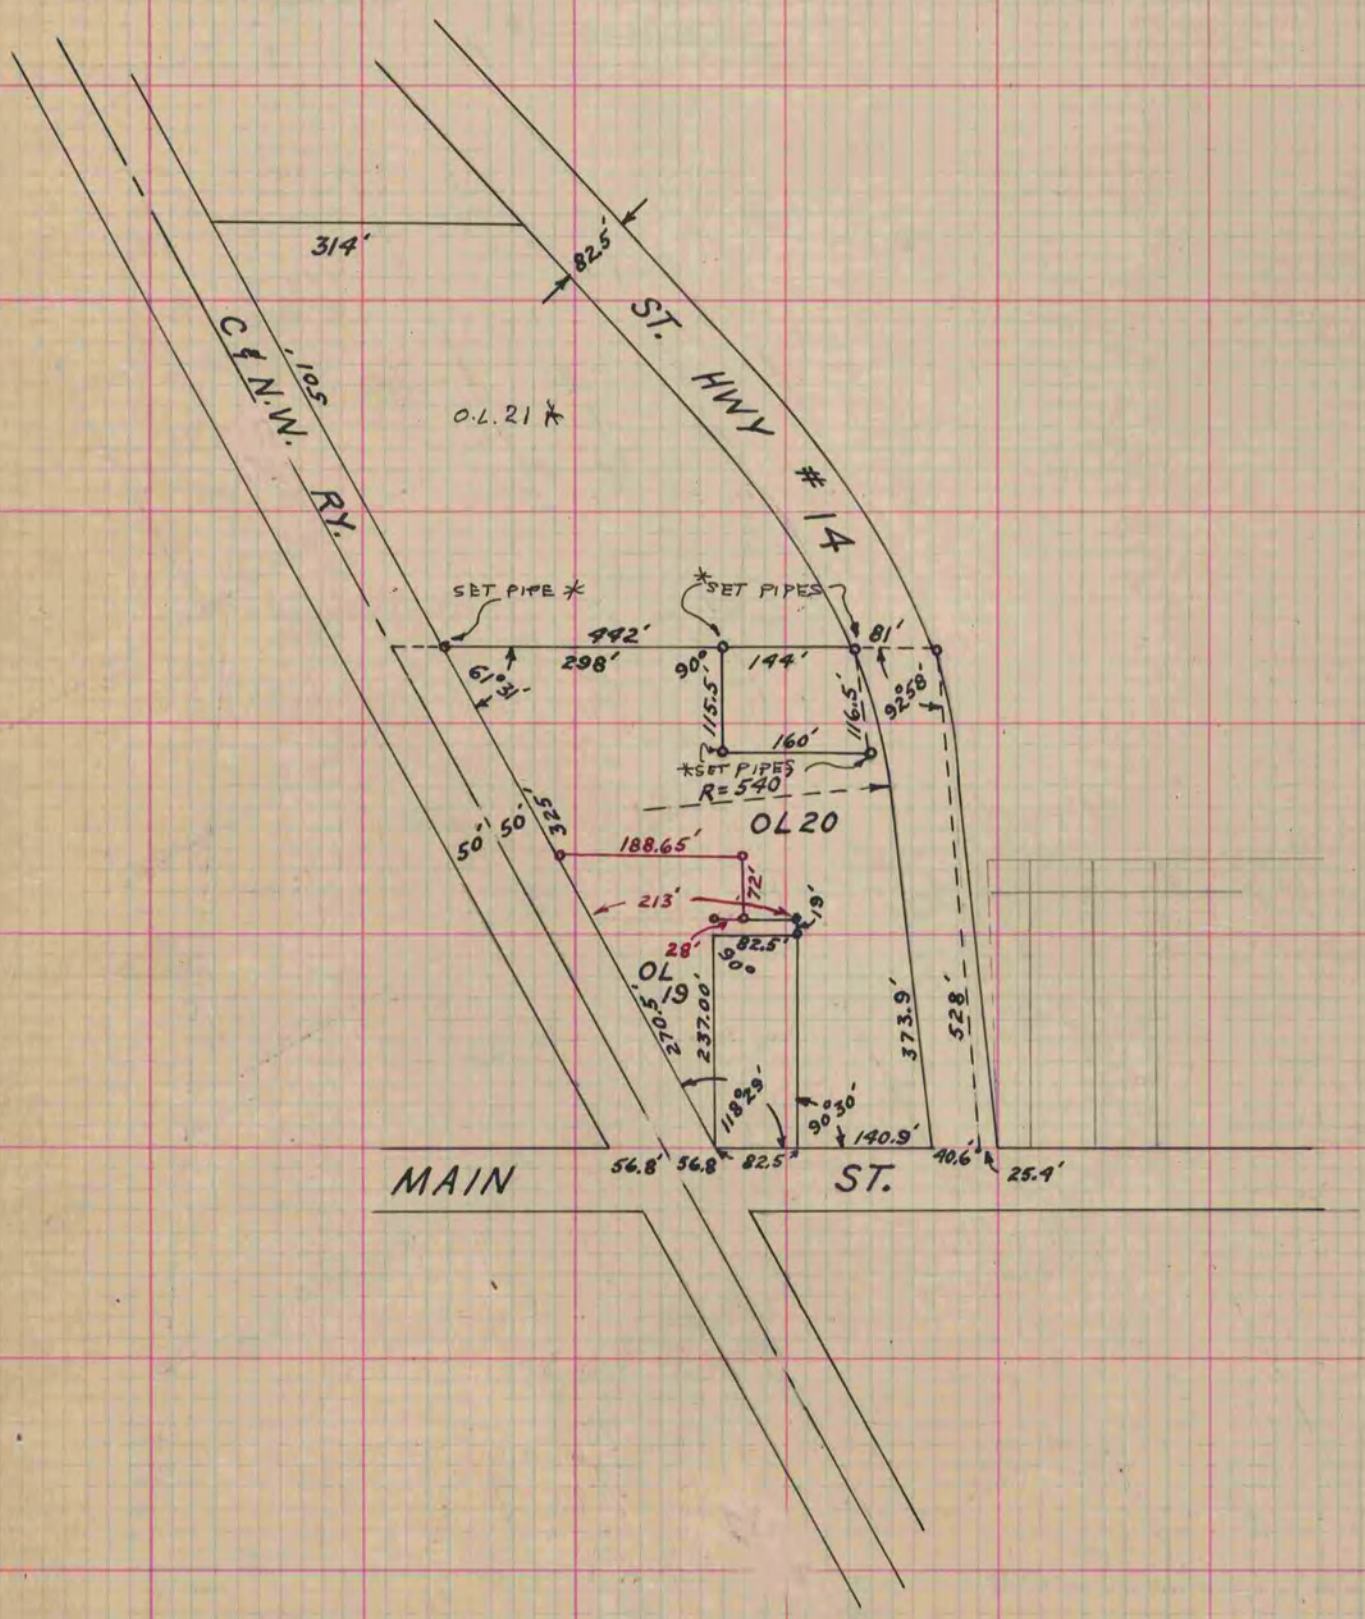
FIGURES IN RED BY
R.H. BATTERMAN JR.