229

PLAT AND RECORD

PG 234 JANESVILLE

REC 12/15/75 DAB

31 T. 3N. R. 12 E. Janesville
36 T. 3N. R. 11 E. Center
6 T 2N. R 12 E. Rock
Of a Survey on Section 1 T 2N. R 11 E. of the 4 P. M. in Plymouth Township

Rock County, Wisconsin, made May, Aug., Oct. the 1933.

I hereby certify that the following is a correct record of said survey as made by me.

COUNTY BUILDING
IN CITY OF BELOIT
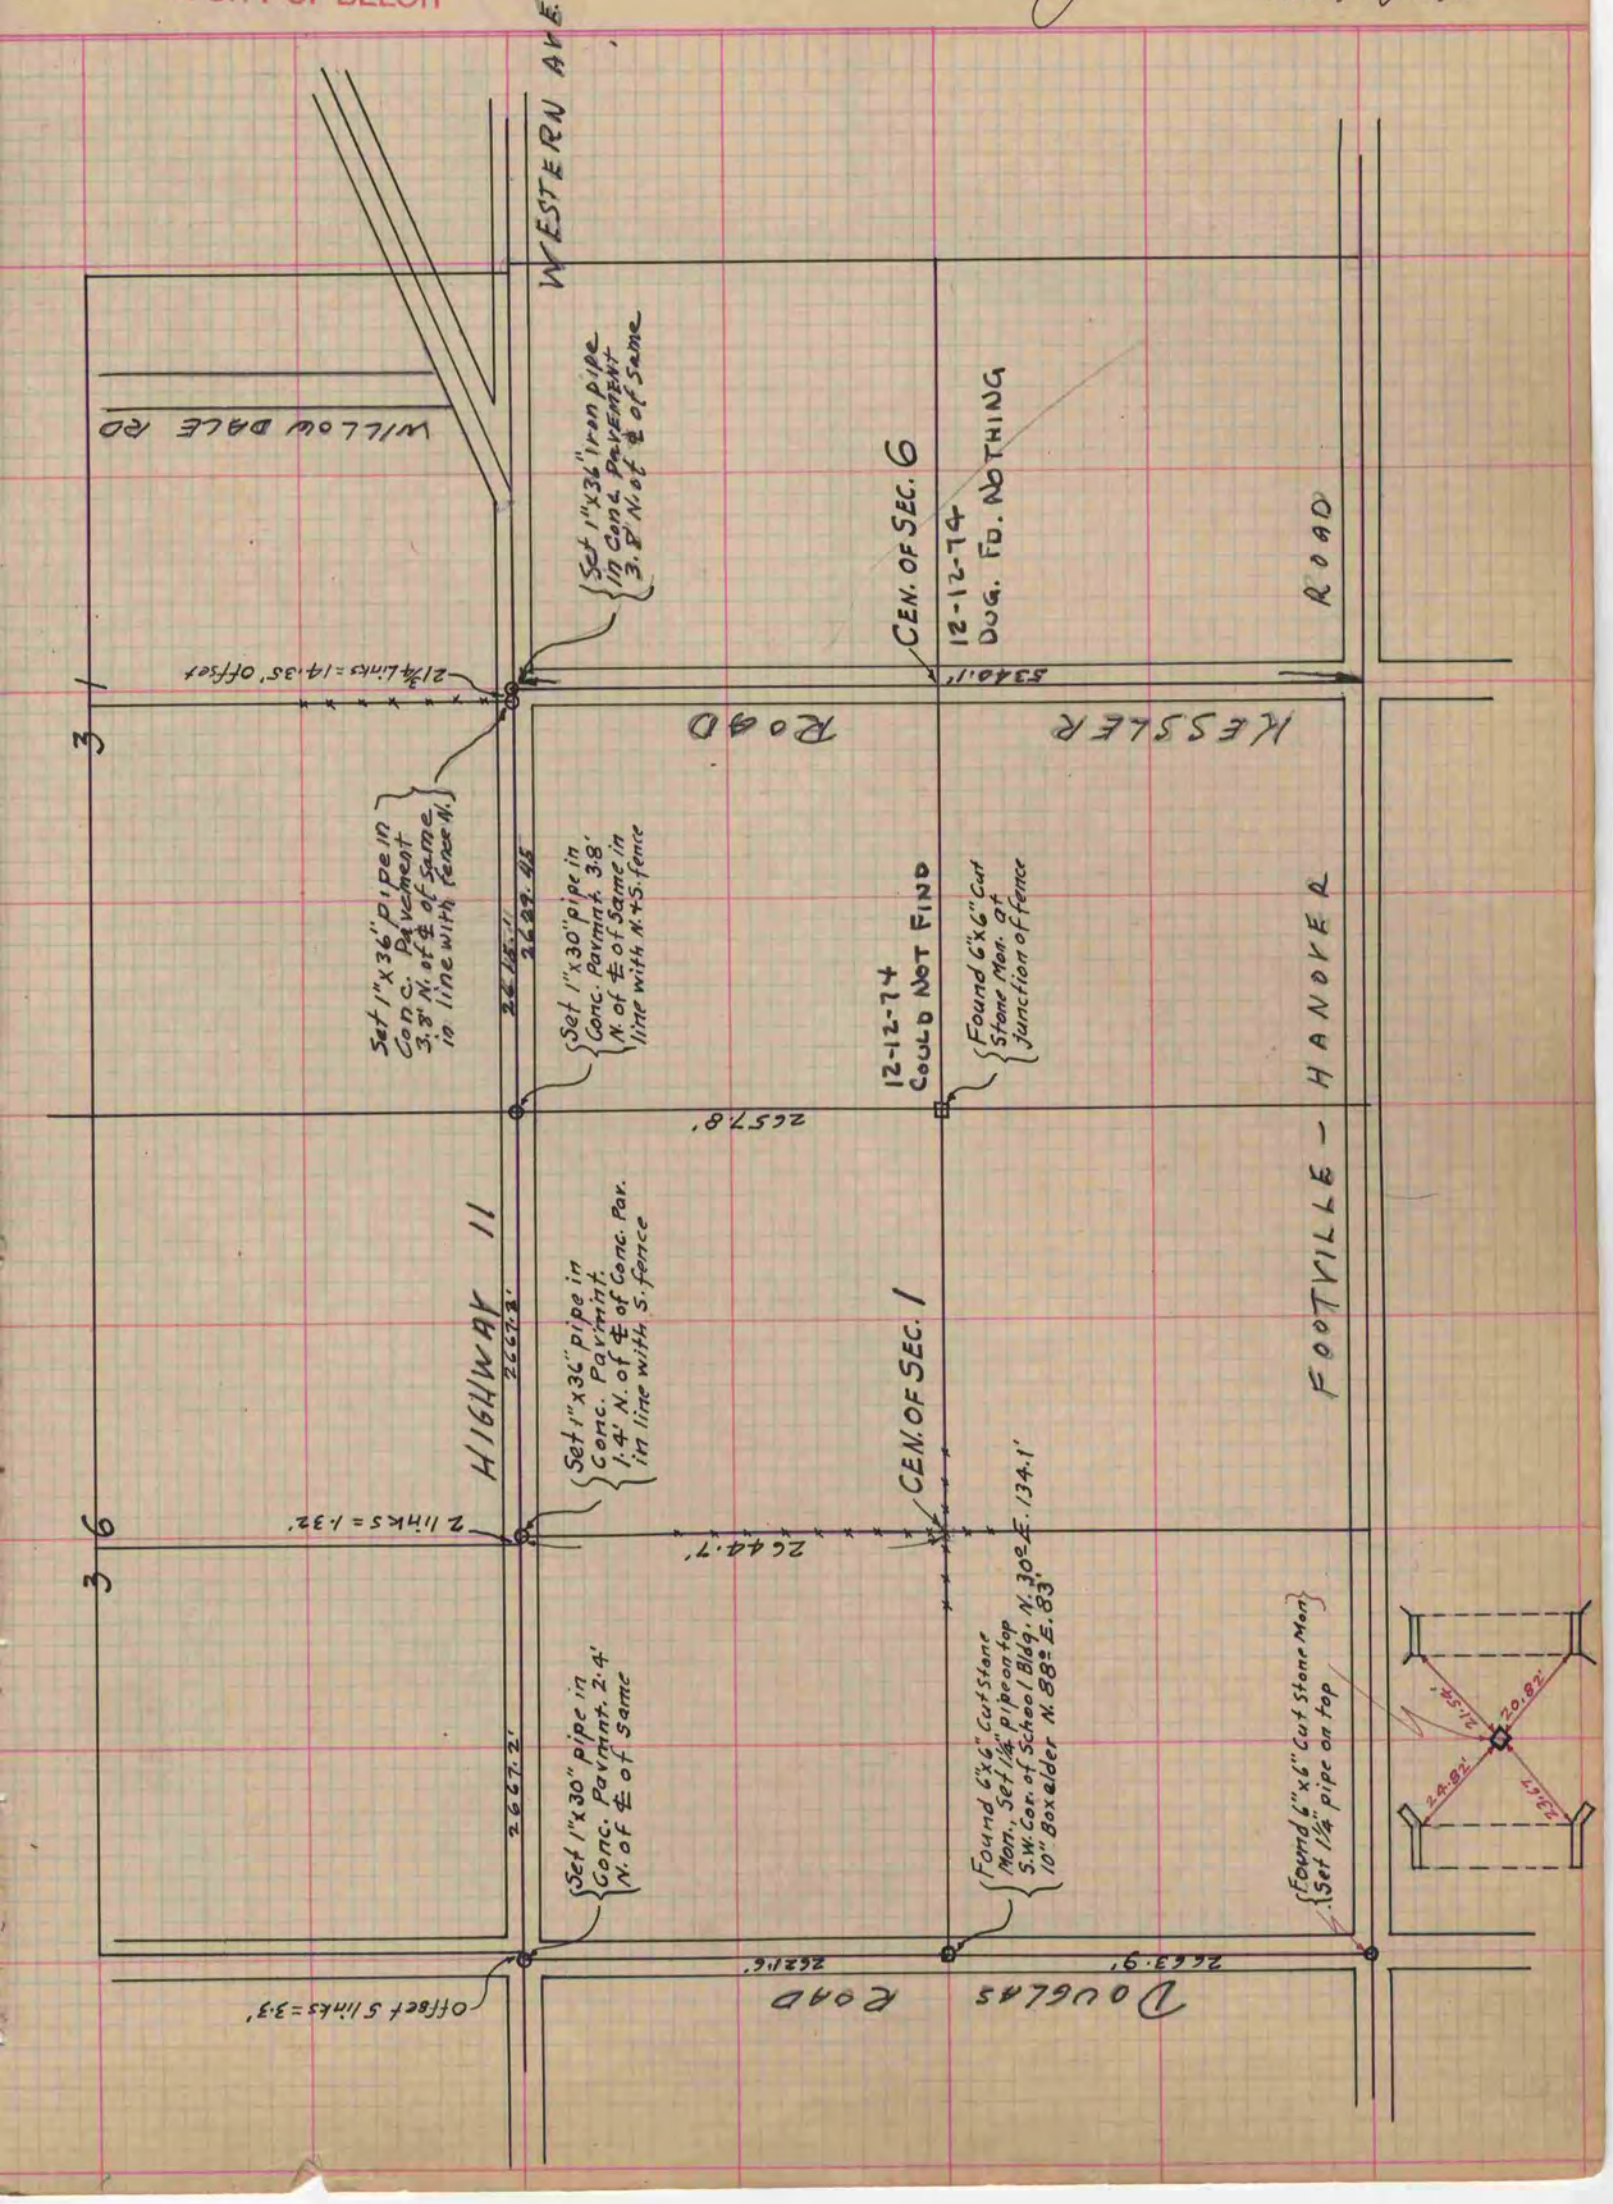
B. J. Bunney
County Surveyor.