COUNTY BUILDING
IN CITY OF BELOIT

PLAT AND RECORD

Of a Survey on Section 7 T 2 R 10 E. of the 4 P. M. in Spring Valley Township

Rock County, Wisconsin, made May the 2nd, 3rd + 5th 1879

I hereby certify that the following is a correct record of said survey as made by me.

COUNTY BUILDING
IN CITY OF BELOIT
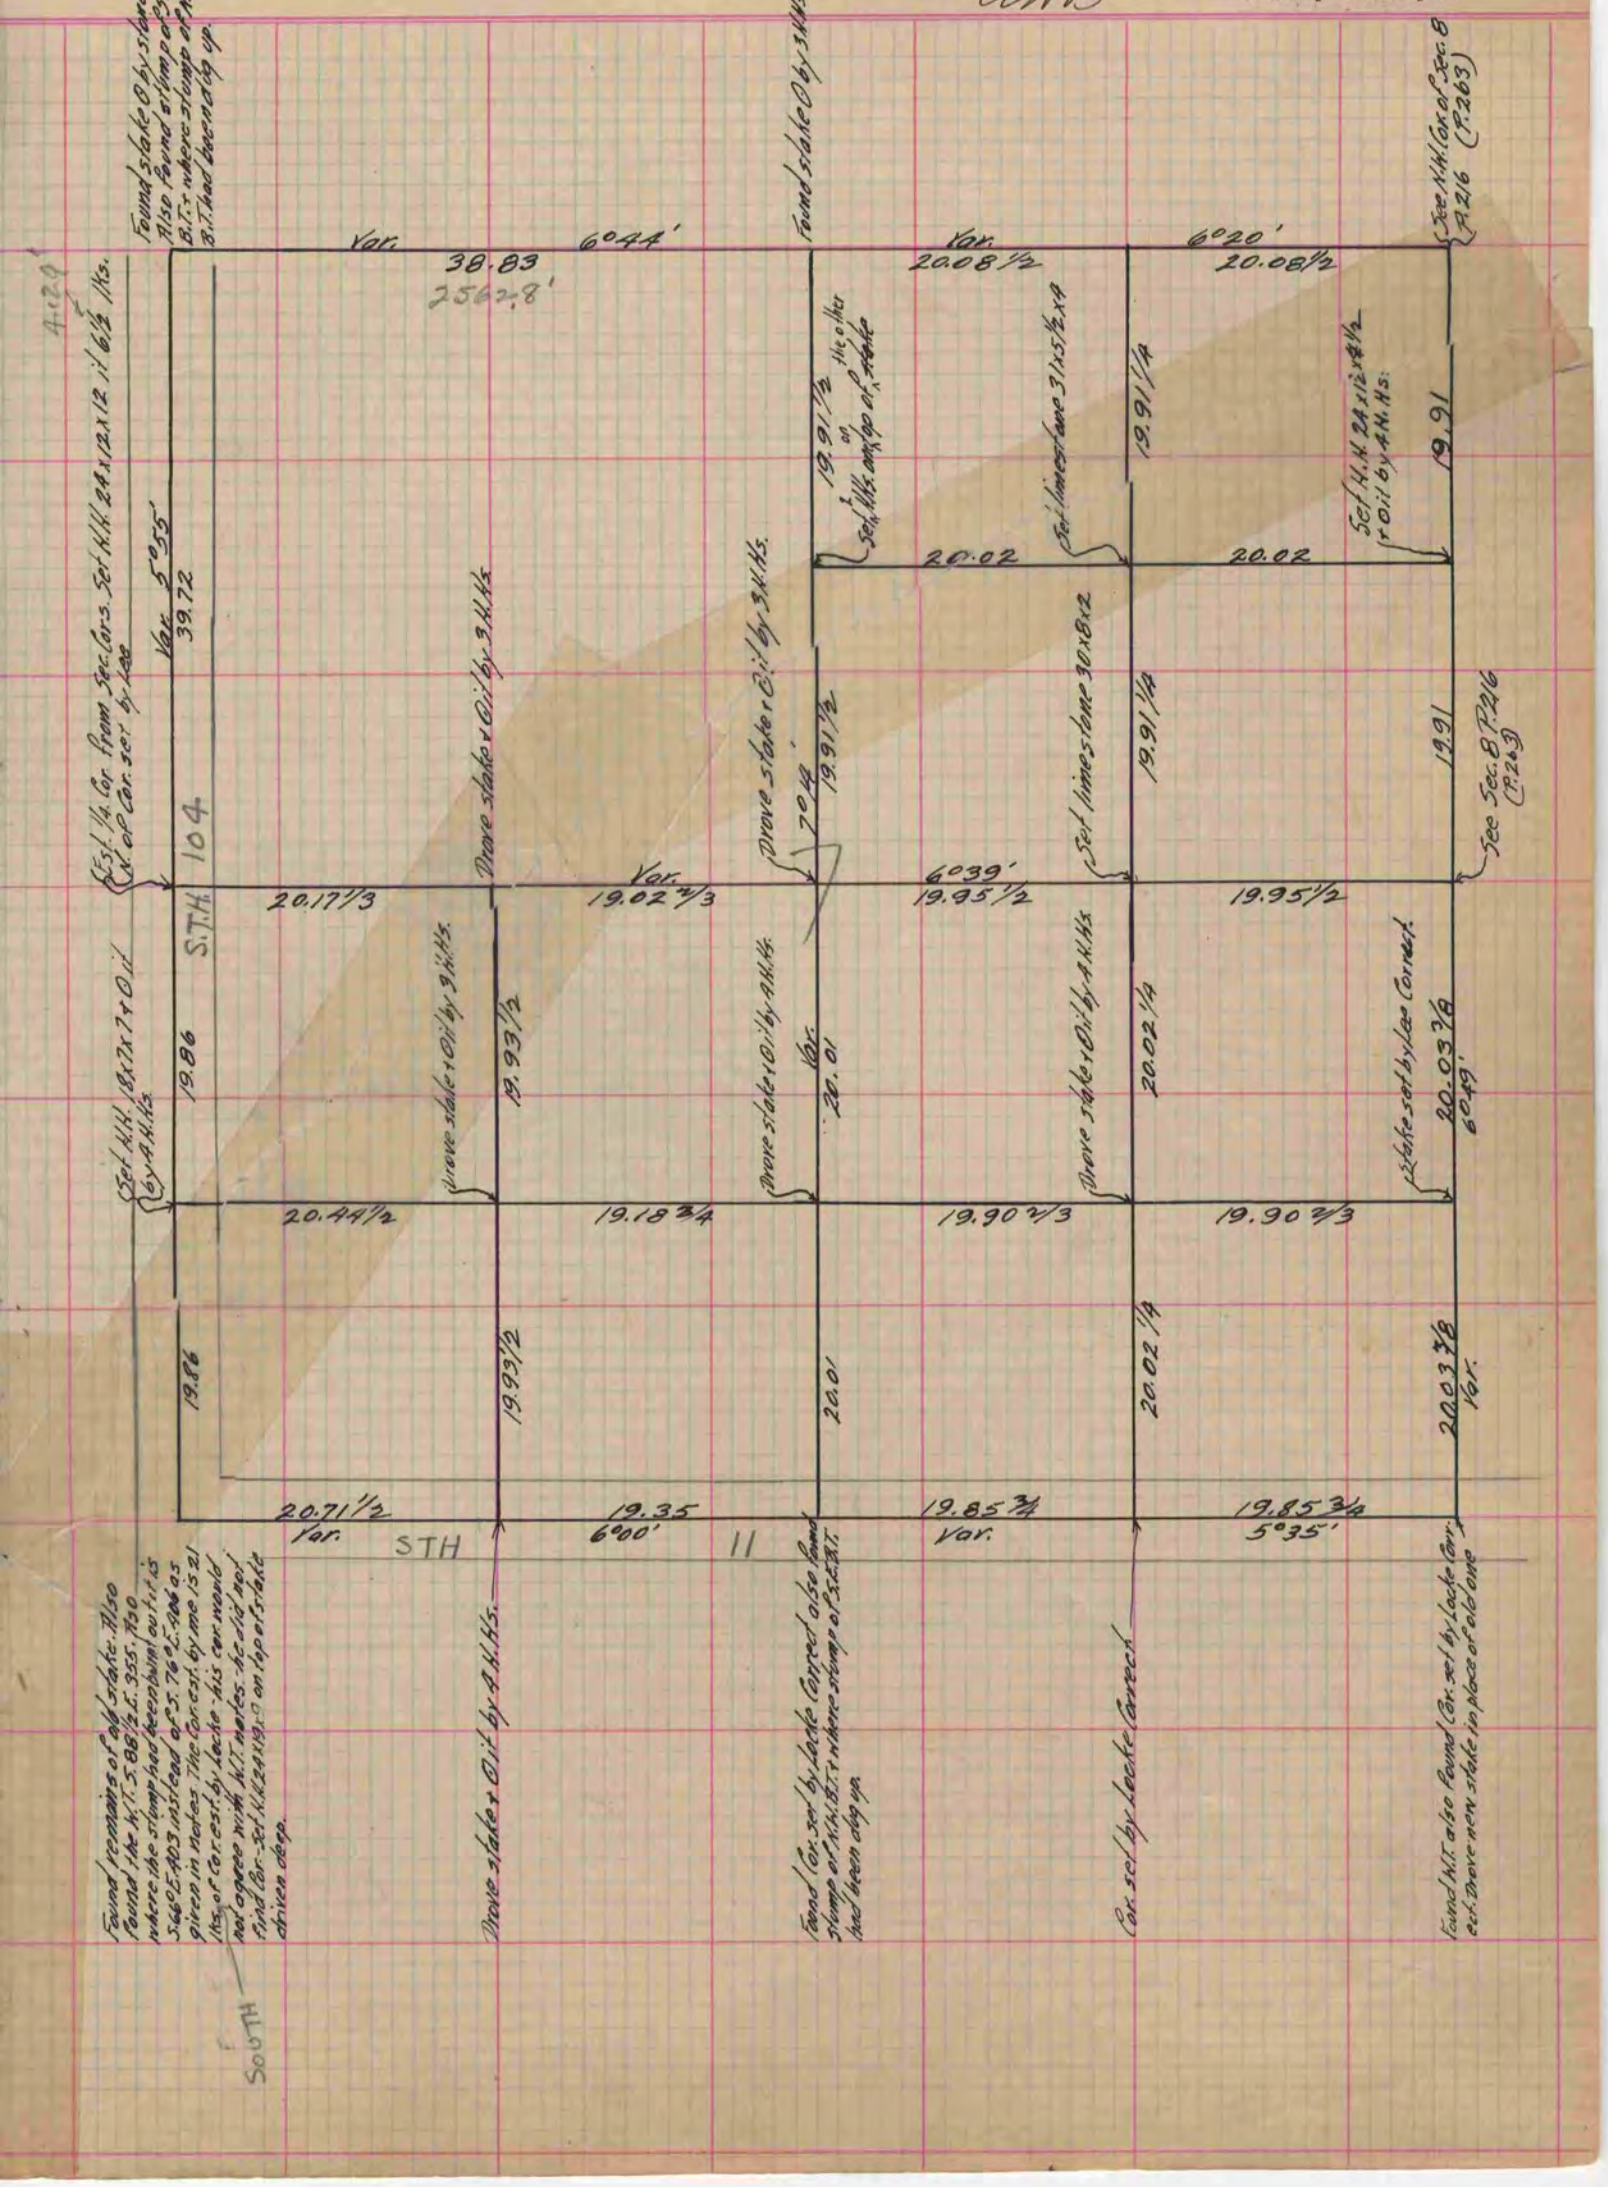
(Signed) Edward Ruger
R.R.B.
County Surveyor.