PLAT AND RECORD

Of a Survey on Section 17 T 2 R 10 E. of the 4 P. M. in Spring Valley Township

Rock County, Wisconsin, made March the 19 & 20 1879

I hereby certify that the following is a correct record of said survey as made by me.

COUNTY BUILDING
IN CITY OF BELOIT

(Signed) Edward Ruger.
R.M.S.
County Surveyor.

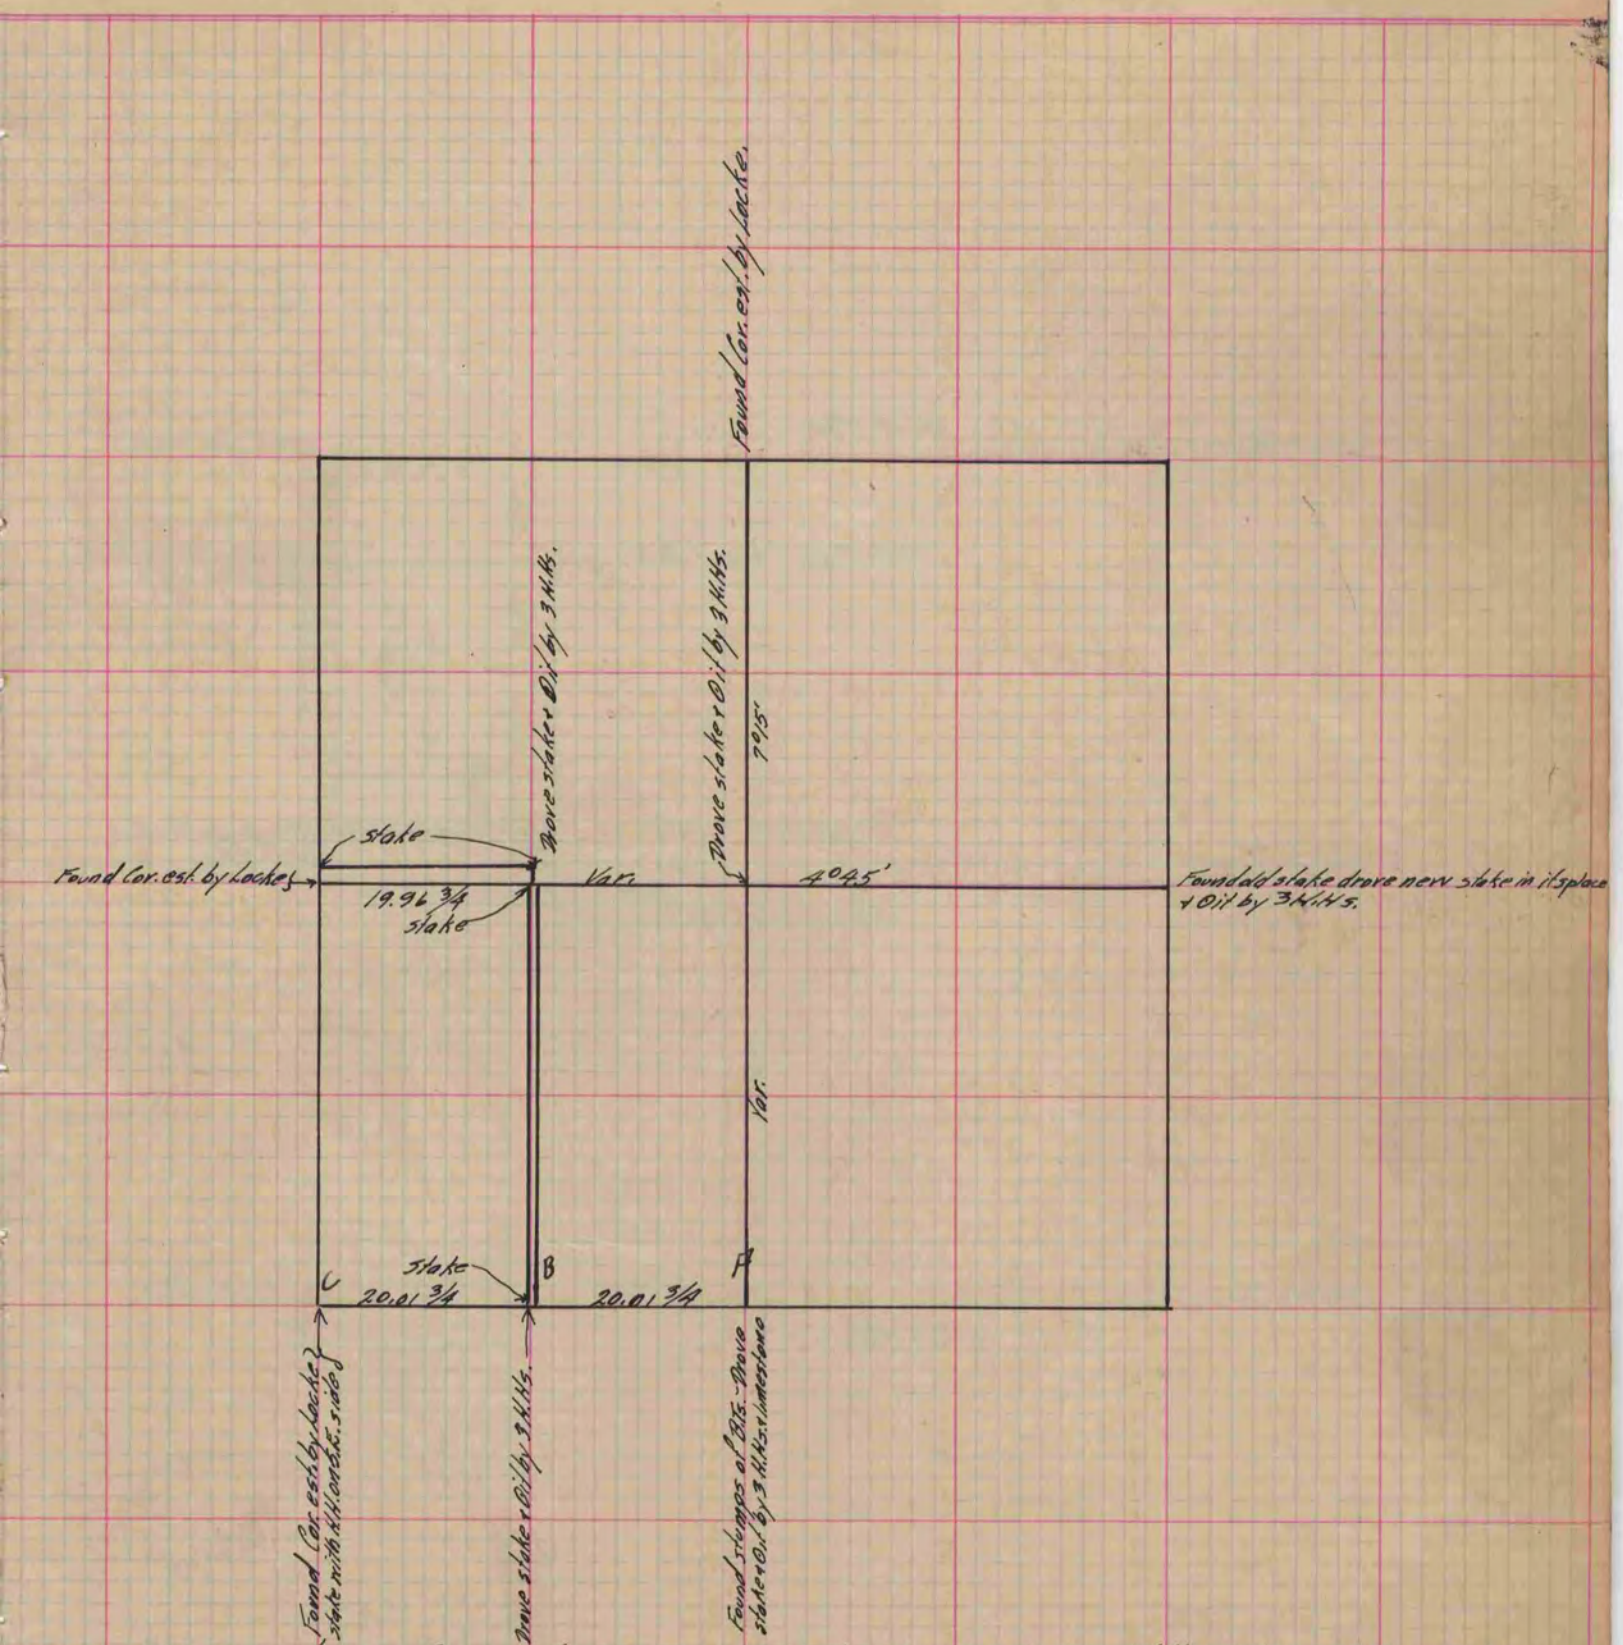

In an exchange of property, there was added on the N. end of the W. 1/2 of the S.W. 1/4, a strip 150 chs. wide & there was taken from the E. side of said W. 1/2 a strip 050 chs. wide.

Copied from P. 207 Vol. 2 County Surveyor's Record.