370

PLAT AND RECORD

Of a Survey on Section 27 T 2N R 11 E. of the 4 P. M. in PLYMOUTH Township

Rock County, Wisconsin, made MAY the 27 1968

I hereby certify that the following is a correct record of said survey as made by me.

R A Batterman

County Surveyor.

COUNTY BUILDING
IN CITY OF BELOIT
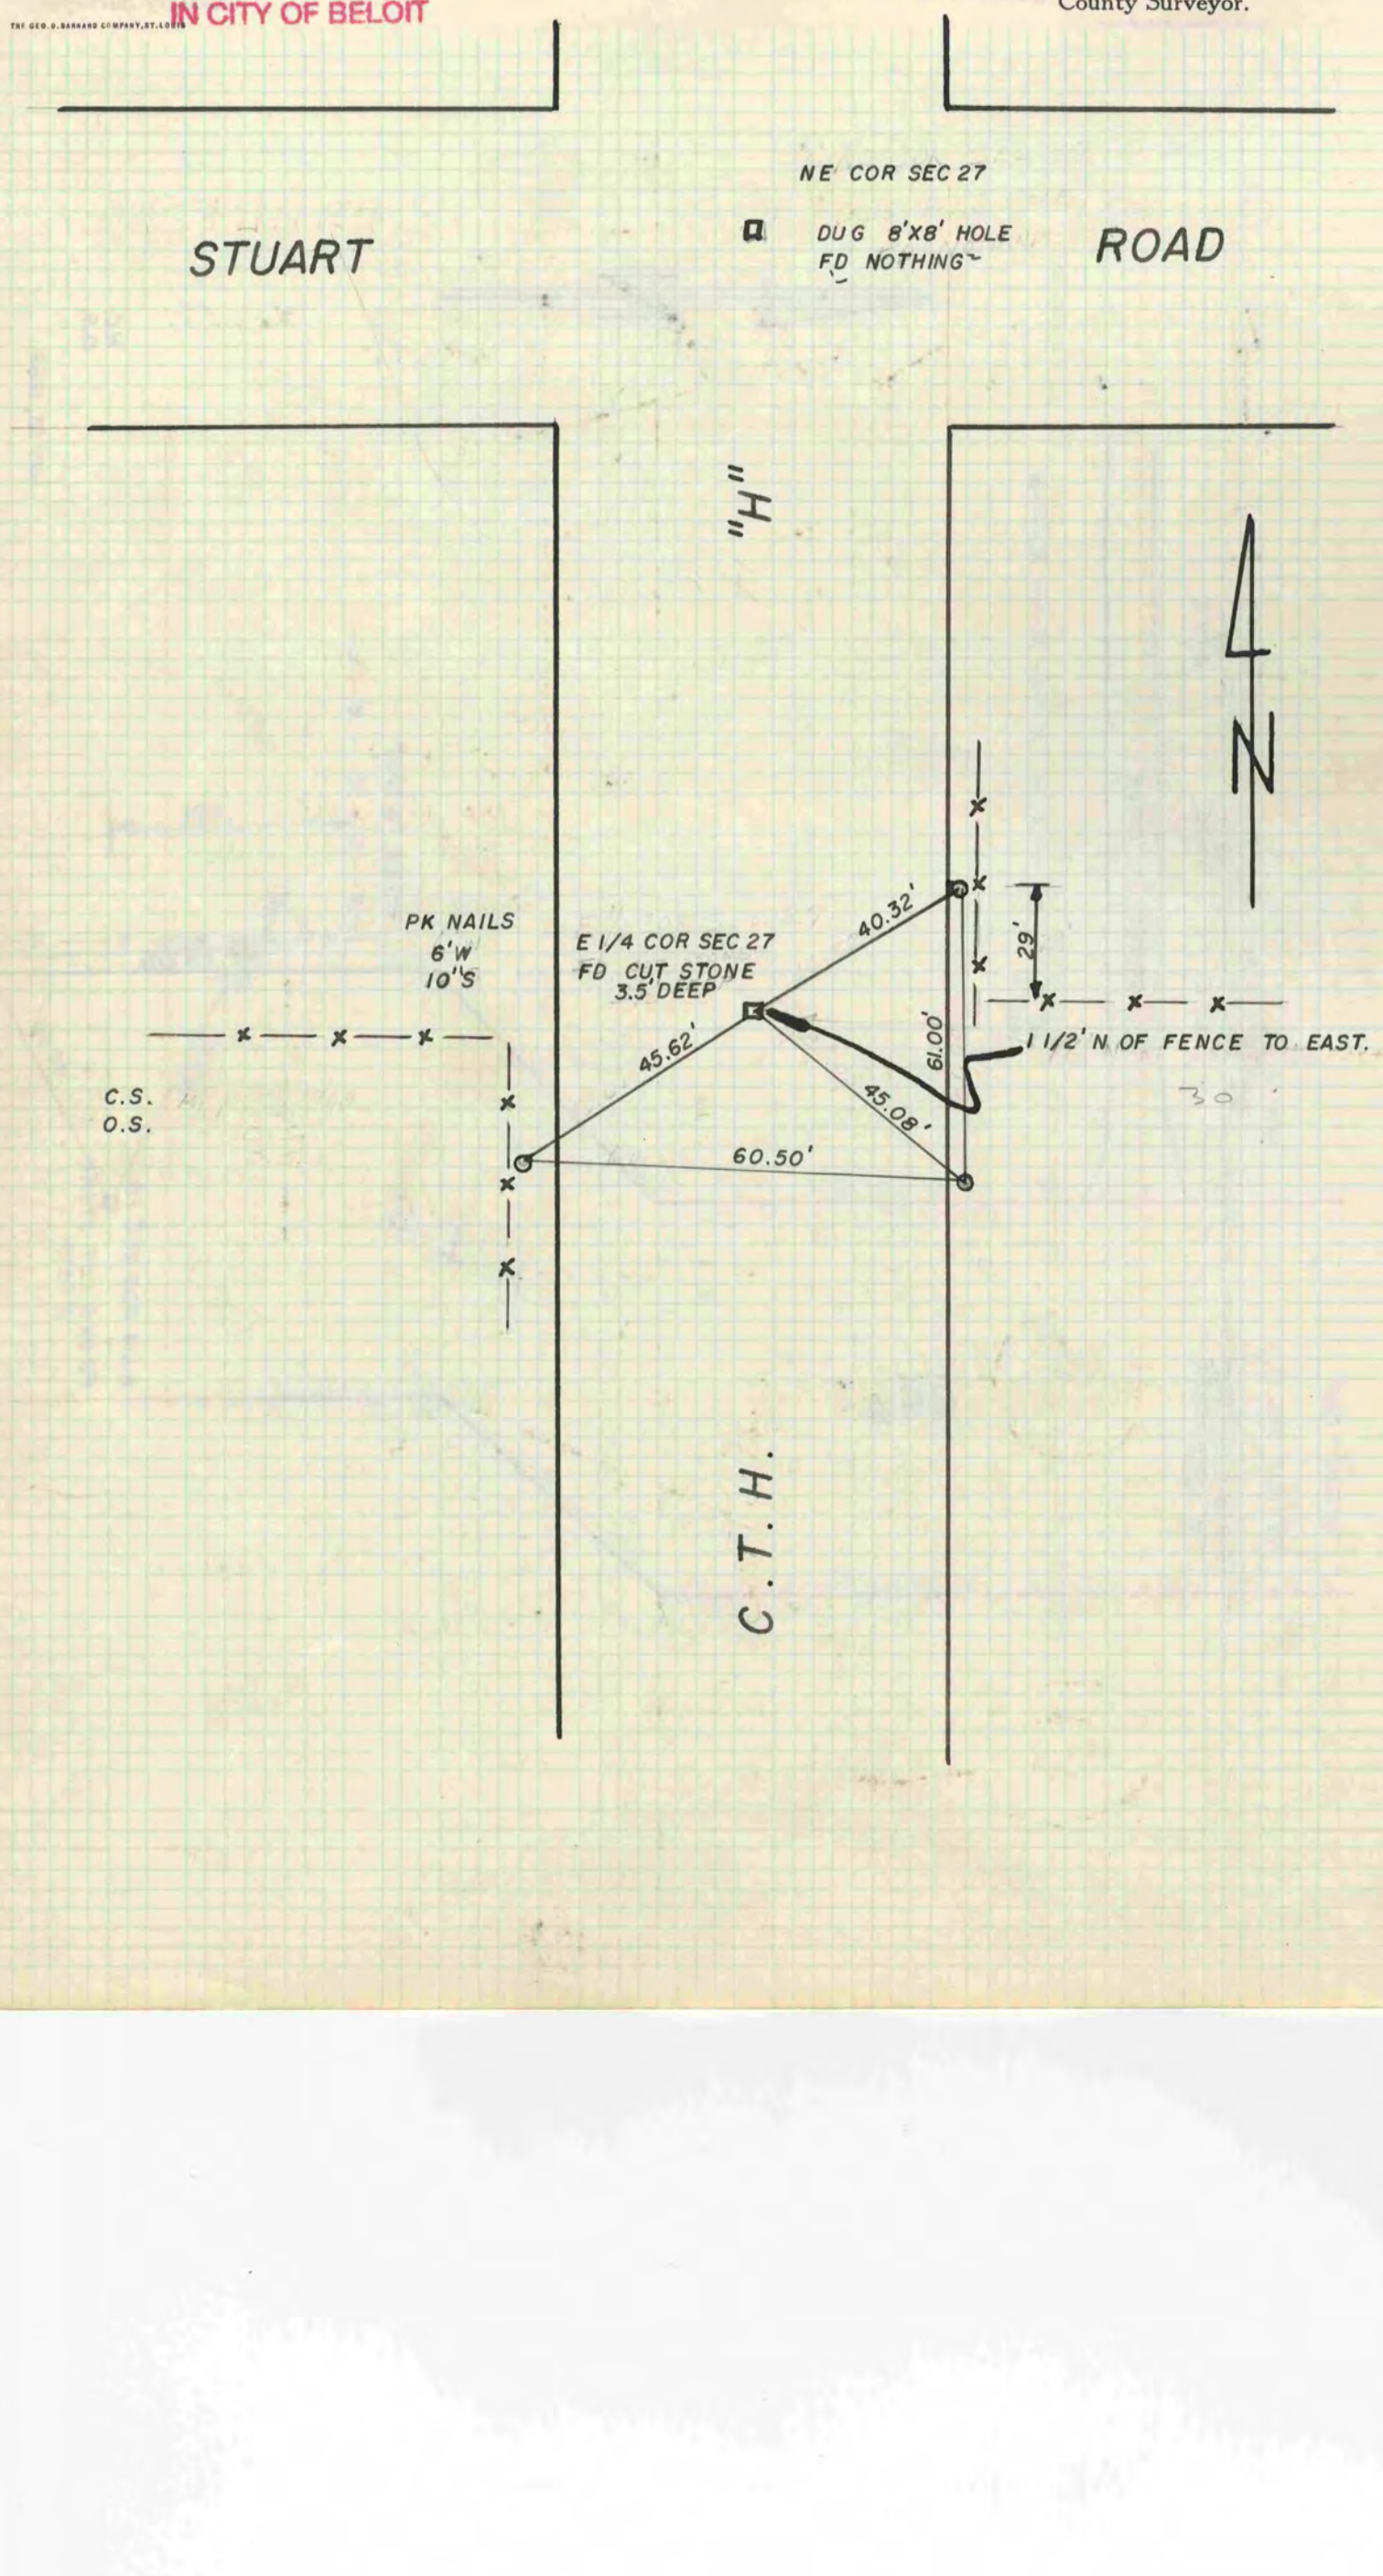
THE GEO. D. BARNARD COMPANY, ST. LOUIS