596

PLAT AND RECORD

Of a Survey on Section 29 T 4 R 11 E. of the 4 P. M. in Porter Township

Rock County, Wisconsin, made April the 5th 19 73

I hereby certify that the following is a correct record of said survey as made by me.

COUNTY BUILDING
IN CITY OF BELOIT

Hugh J. Lee
County Surveyor.
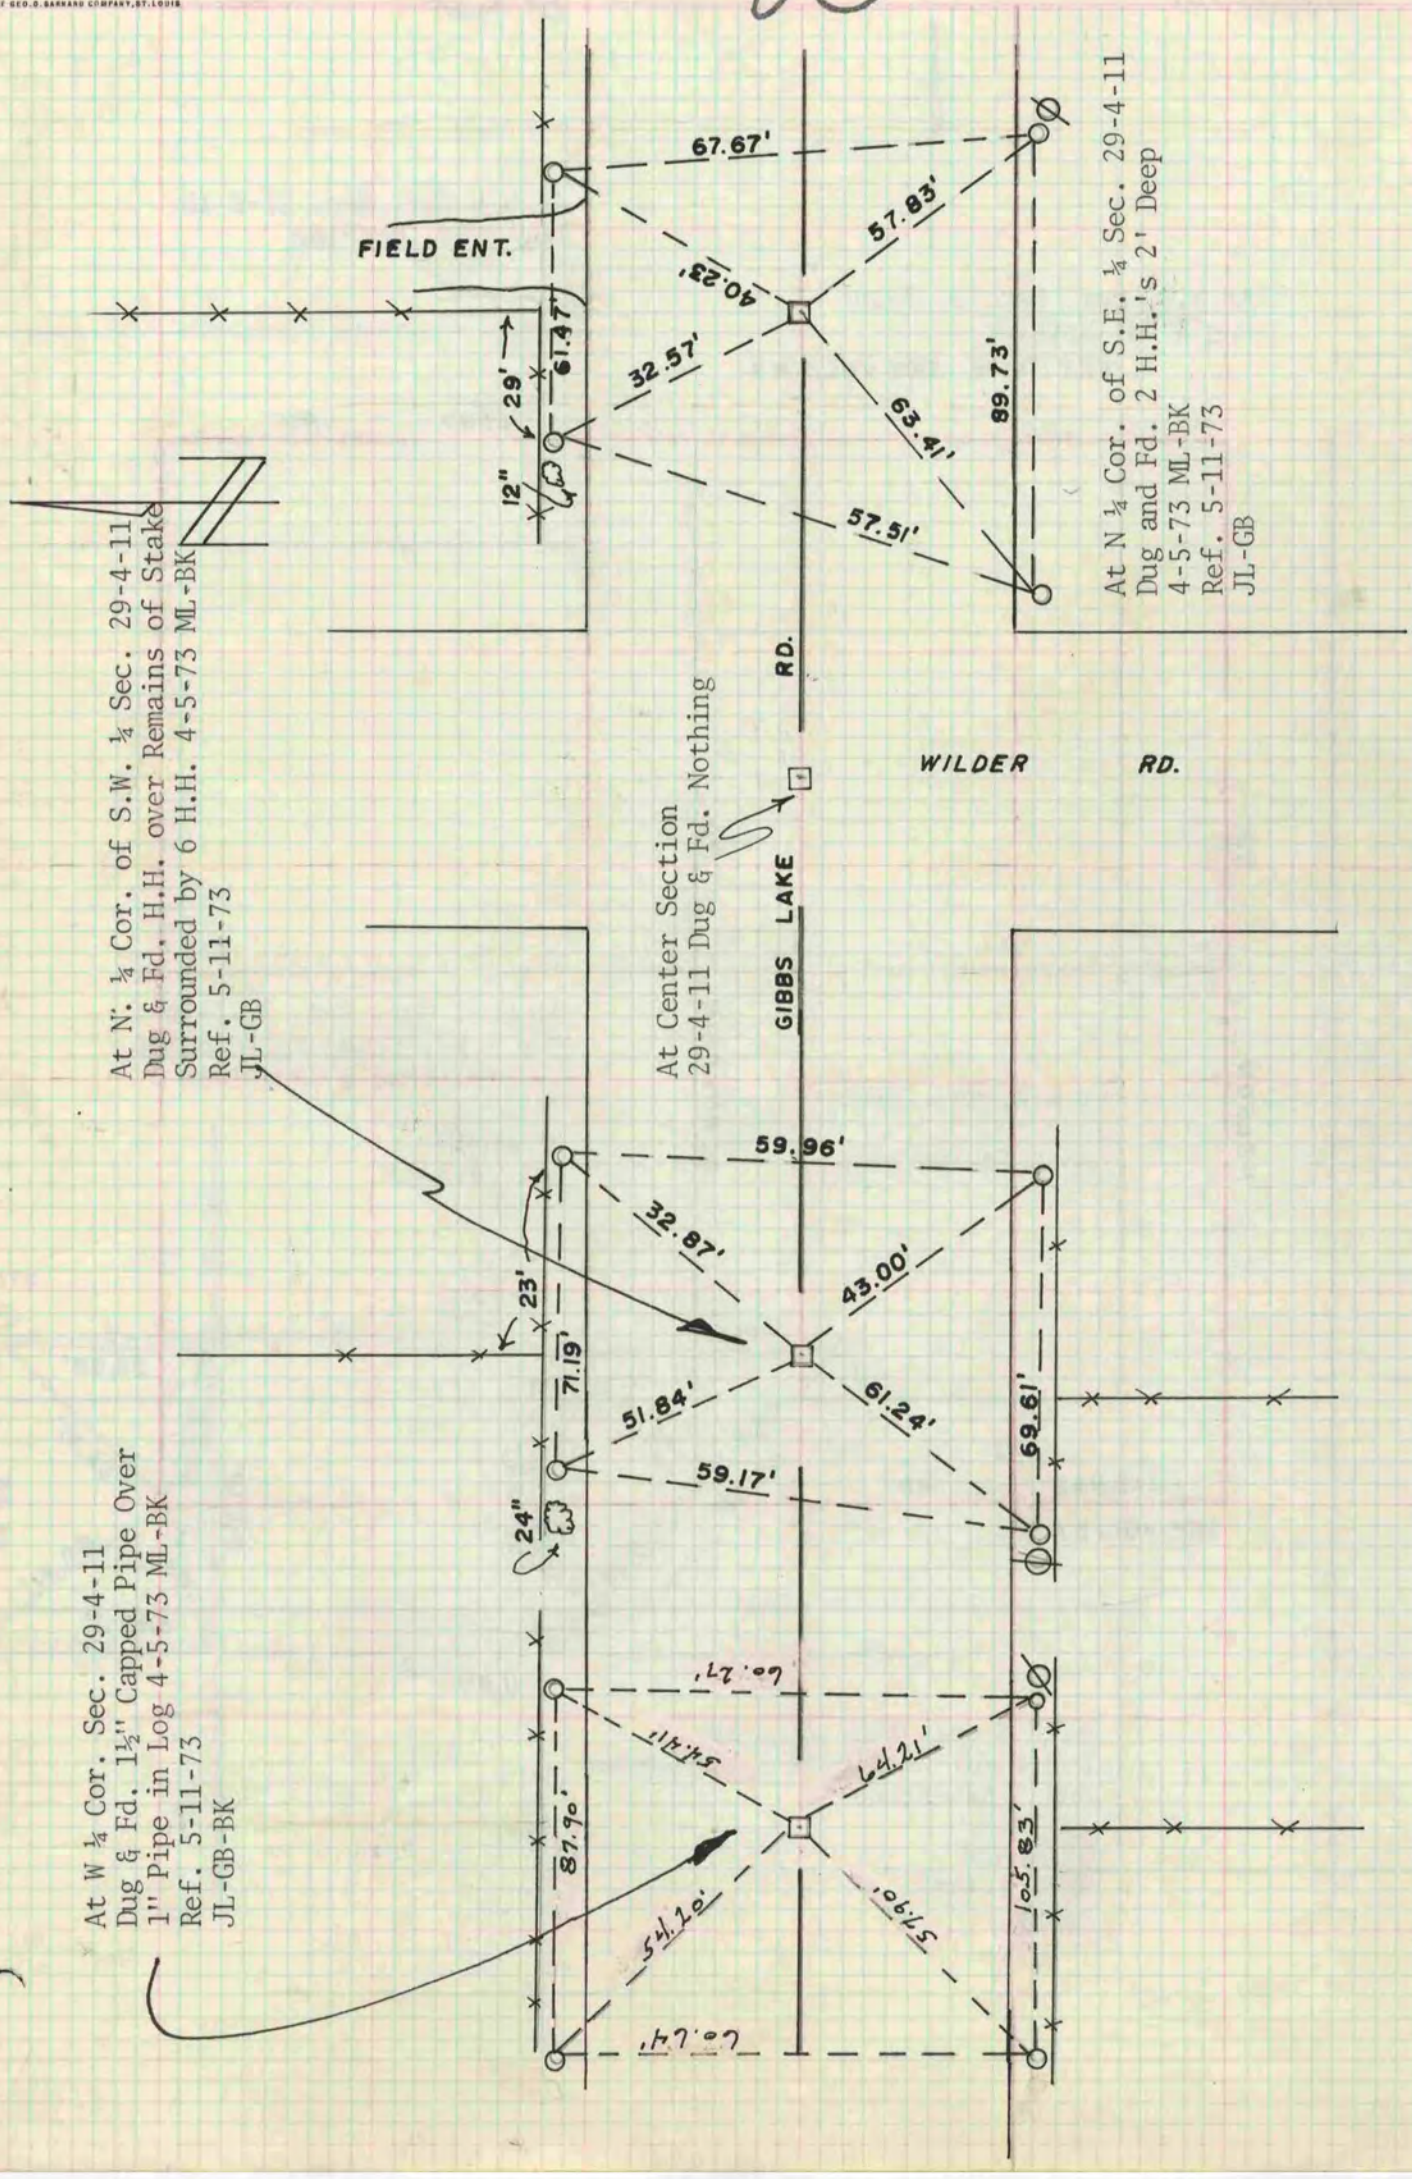
THE GEO. D. BARNARD COMPANY, ST. LOUIS