PLAT AND RECORD

Of a Survey on Section 28 T 2 R 14 E. of the 4 P. M. in Bradford Township

Rock County, Wisconsin, made March the 15, 16 & 17 1894

I hereby certify that the following is a correct record of said survey as made by me.

COUNTY BUILDING
IN CITY OF BELOIT
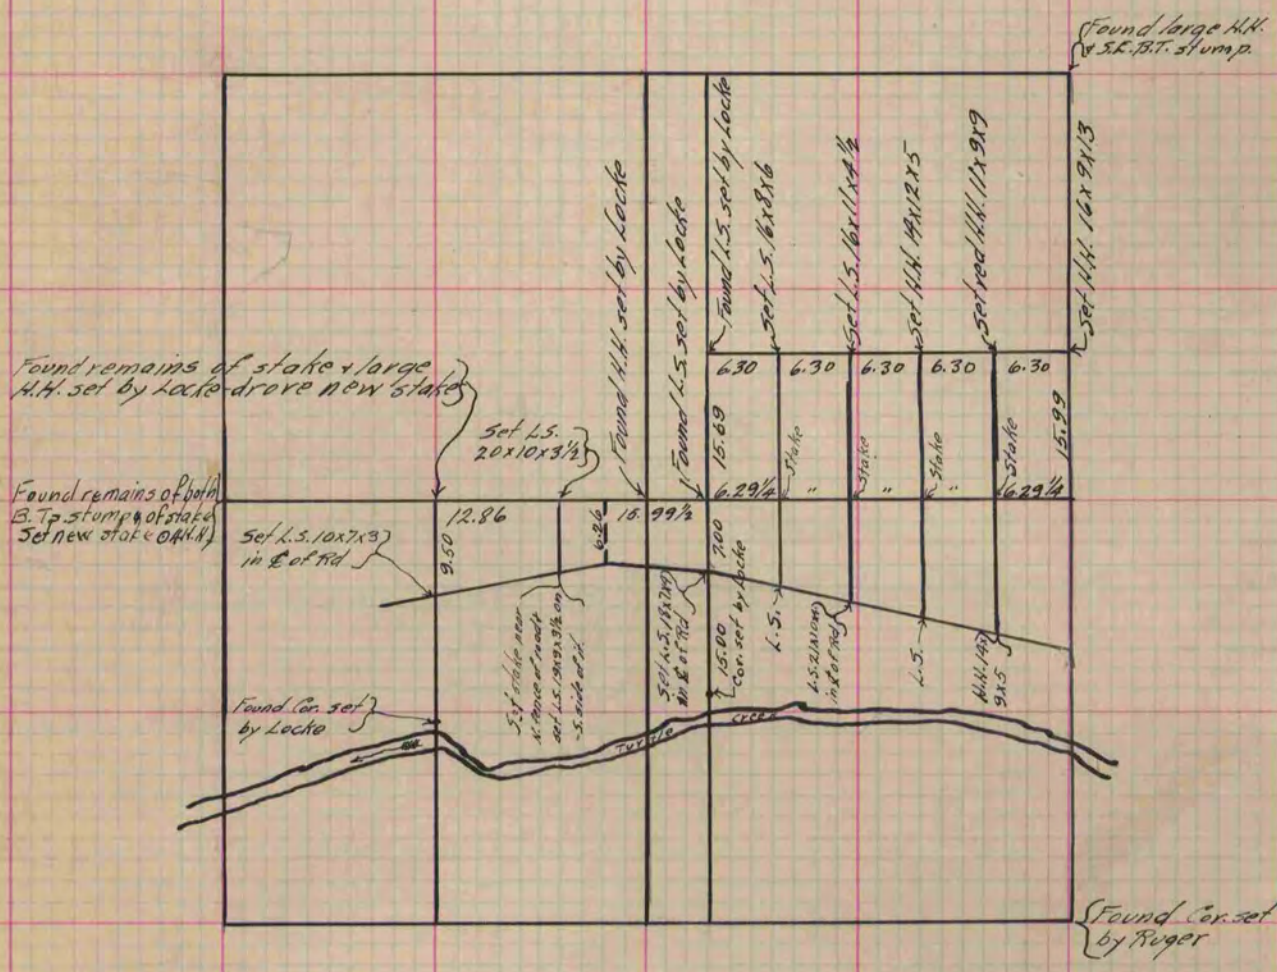
(Signed) O. G. Bleedorn
County Surveyor.