PLAT AND RECORD

Of a Survey on Section 33 T 4 R 13 E. of the 4 P. M. in MILTON Township

Rock County, Wisconsin, made OCTOBER the 18 1971

I hereby certify that the following is a correct record of said survey as made by me.

COUNTY BUILDING
IN CITY OF BELOIT

Hugh J Lee
County Surveyor.

THE GEO. O. BARNARD COMPANY, ST. LOUIS

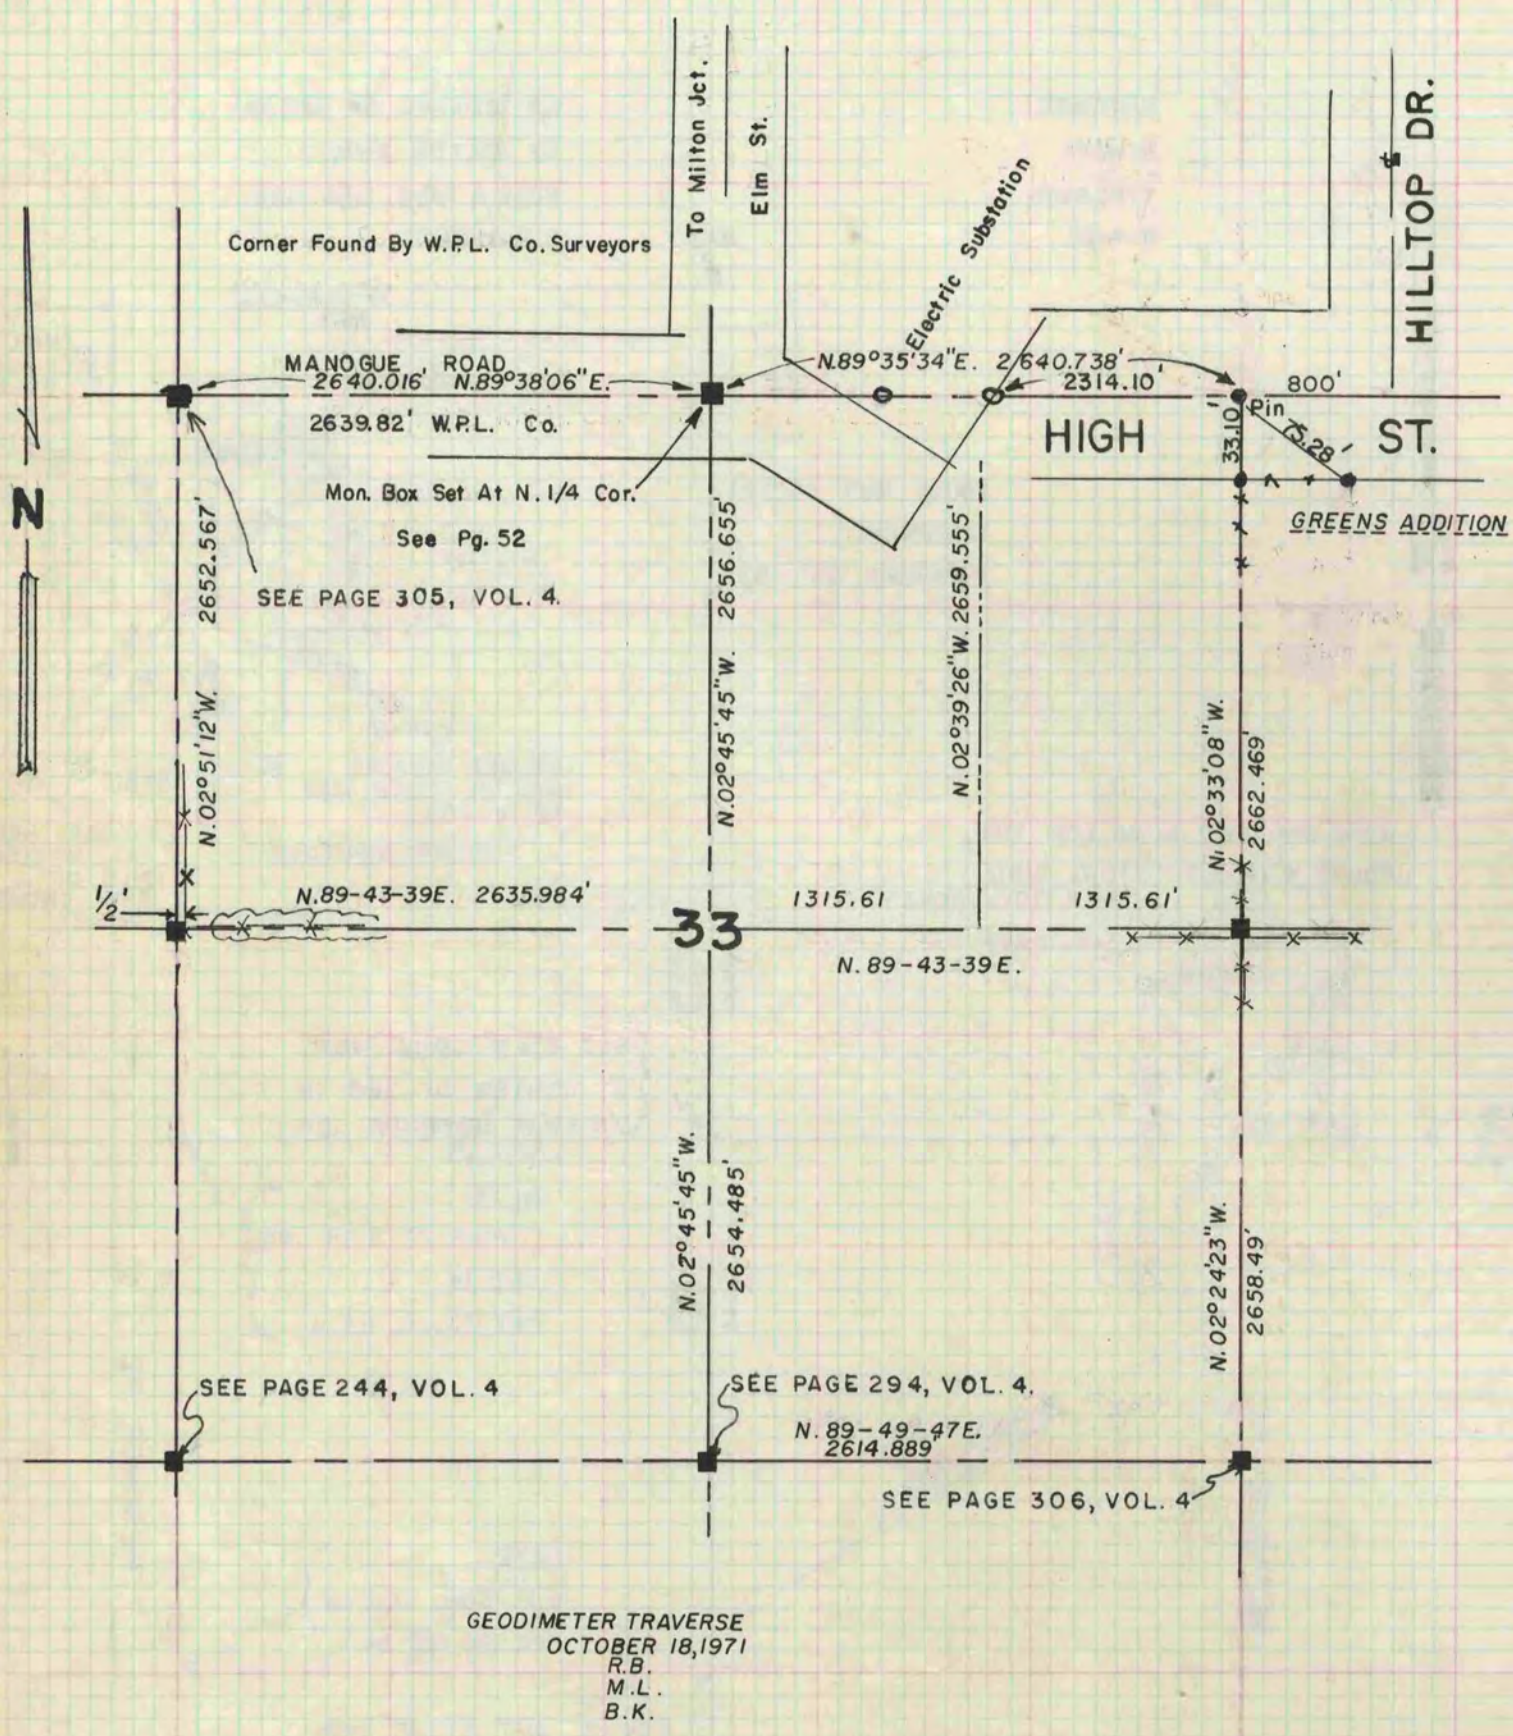

GEODIMETER TRAVERSE
OCTOBER 18,1971
R.B.
M.L.
B.K.