PLAT AND RECORD

Of a Survey on Section 11 T 2 R 10 E. of the 4 P. M. in Spring Valley Township

Rock County, Wisconsin, made May the 28, 29 & 30 1874

I hereby certify that the following is a correct record of said survey as made by me.

COUNTY BUILDING
IN CITY OF BELOIT

(Signed) Edward Ruger.
DMB
County Surveyor.

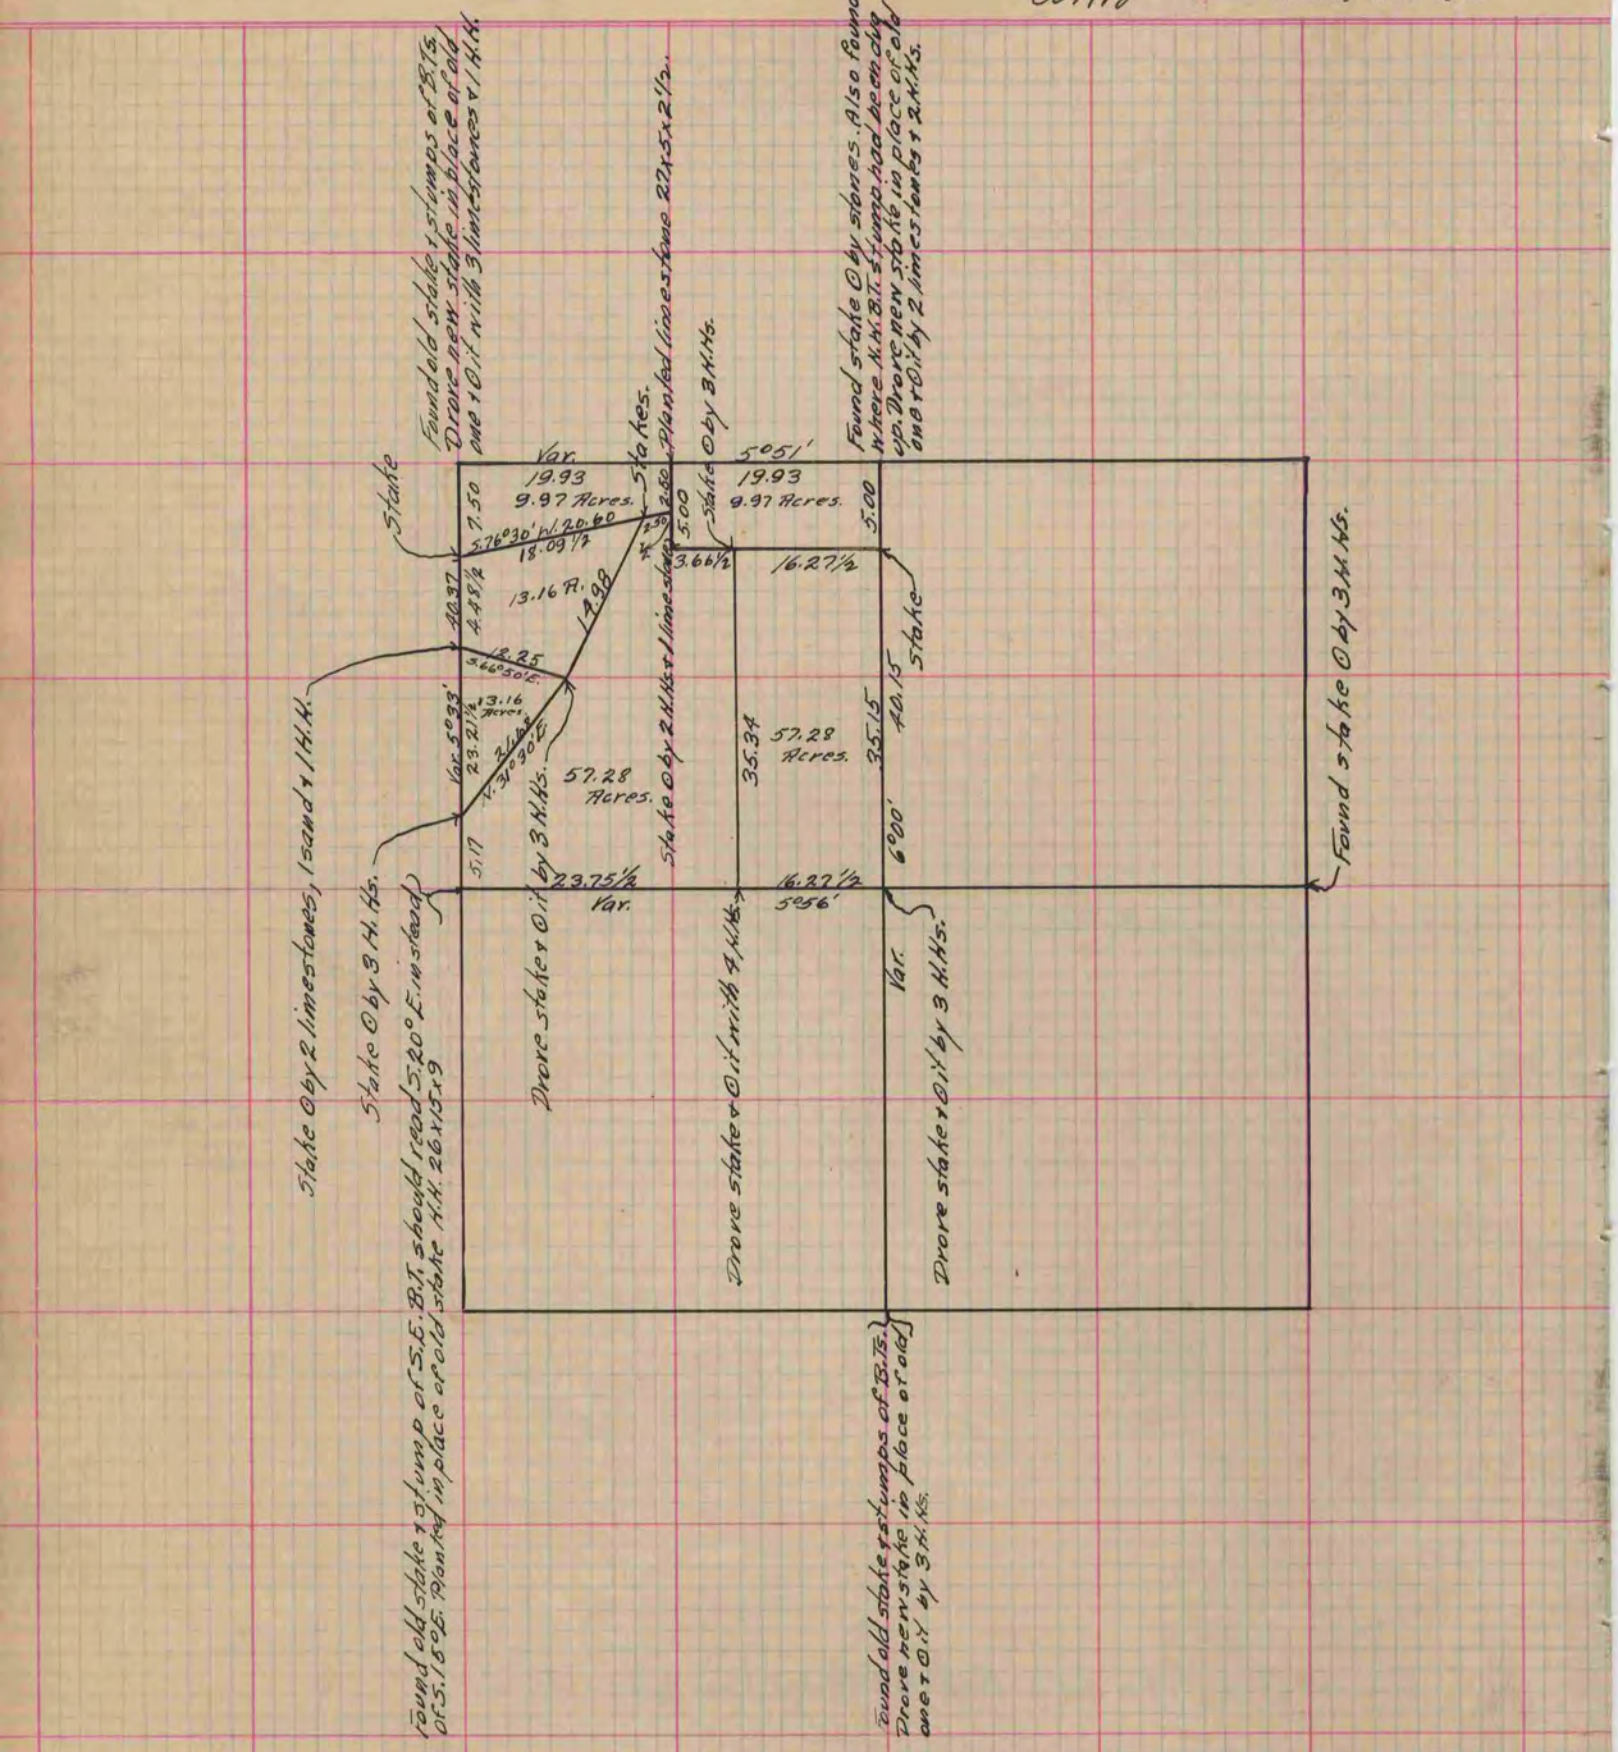

Copied from P. 97 Vol. 2. Original County Surveyor's Record.