PLAT AND RECORD

Of a Survey on Section 22 T 3 R 13 E. of the 4 P. M. in Harmony Township

Rock County, Wisconsin, made April the 17 1895

I hereby certify that the following is a correct record of said survey as made by me.

COUNTY BUILDING
IN CITY OF BELOIT

(Signed) P. F. Brown
County Surveyor.

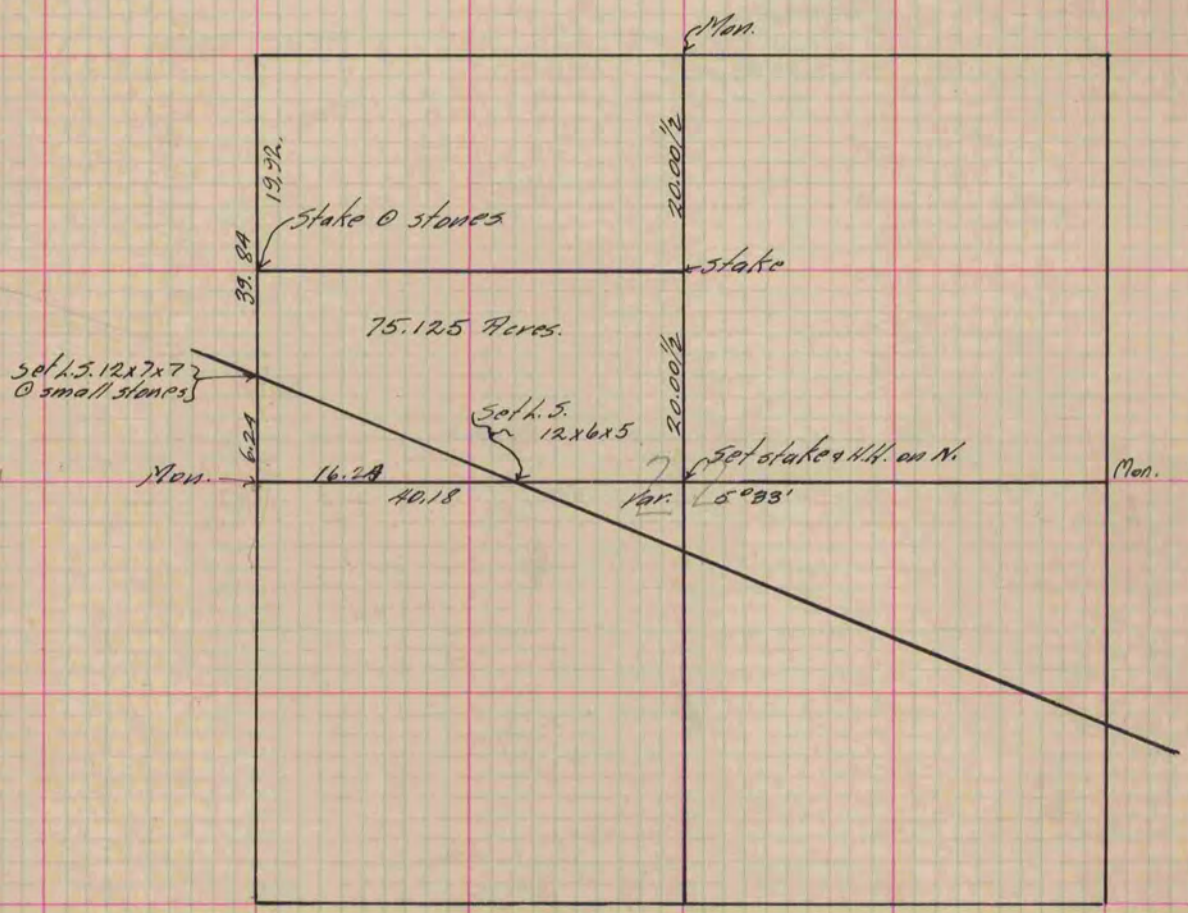

Copied from P. 378 Vol. 2 County Surveyor's Record