PLAT AND RECORD

Of a Survey on N.W.¼ of N.E.¼ Section 3 T 4 R 12 E. of the 4 P. M. in Fulton Township

Rock County, Wisconsin, made Aug. the 22 + 23 1892

I hereby certify that the following is a correct record of said survey as made by me.

COUNTY BUILDING
IN CITY OF BELOIT

(Signed) O. G. Bleedorn
RHB
County Surveyor.

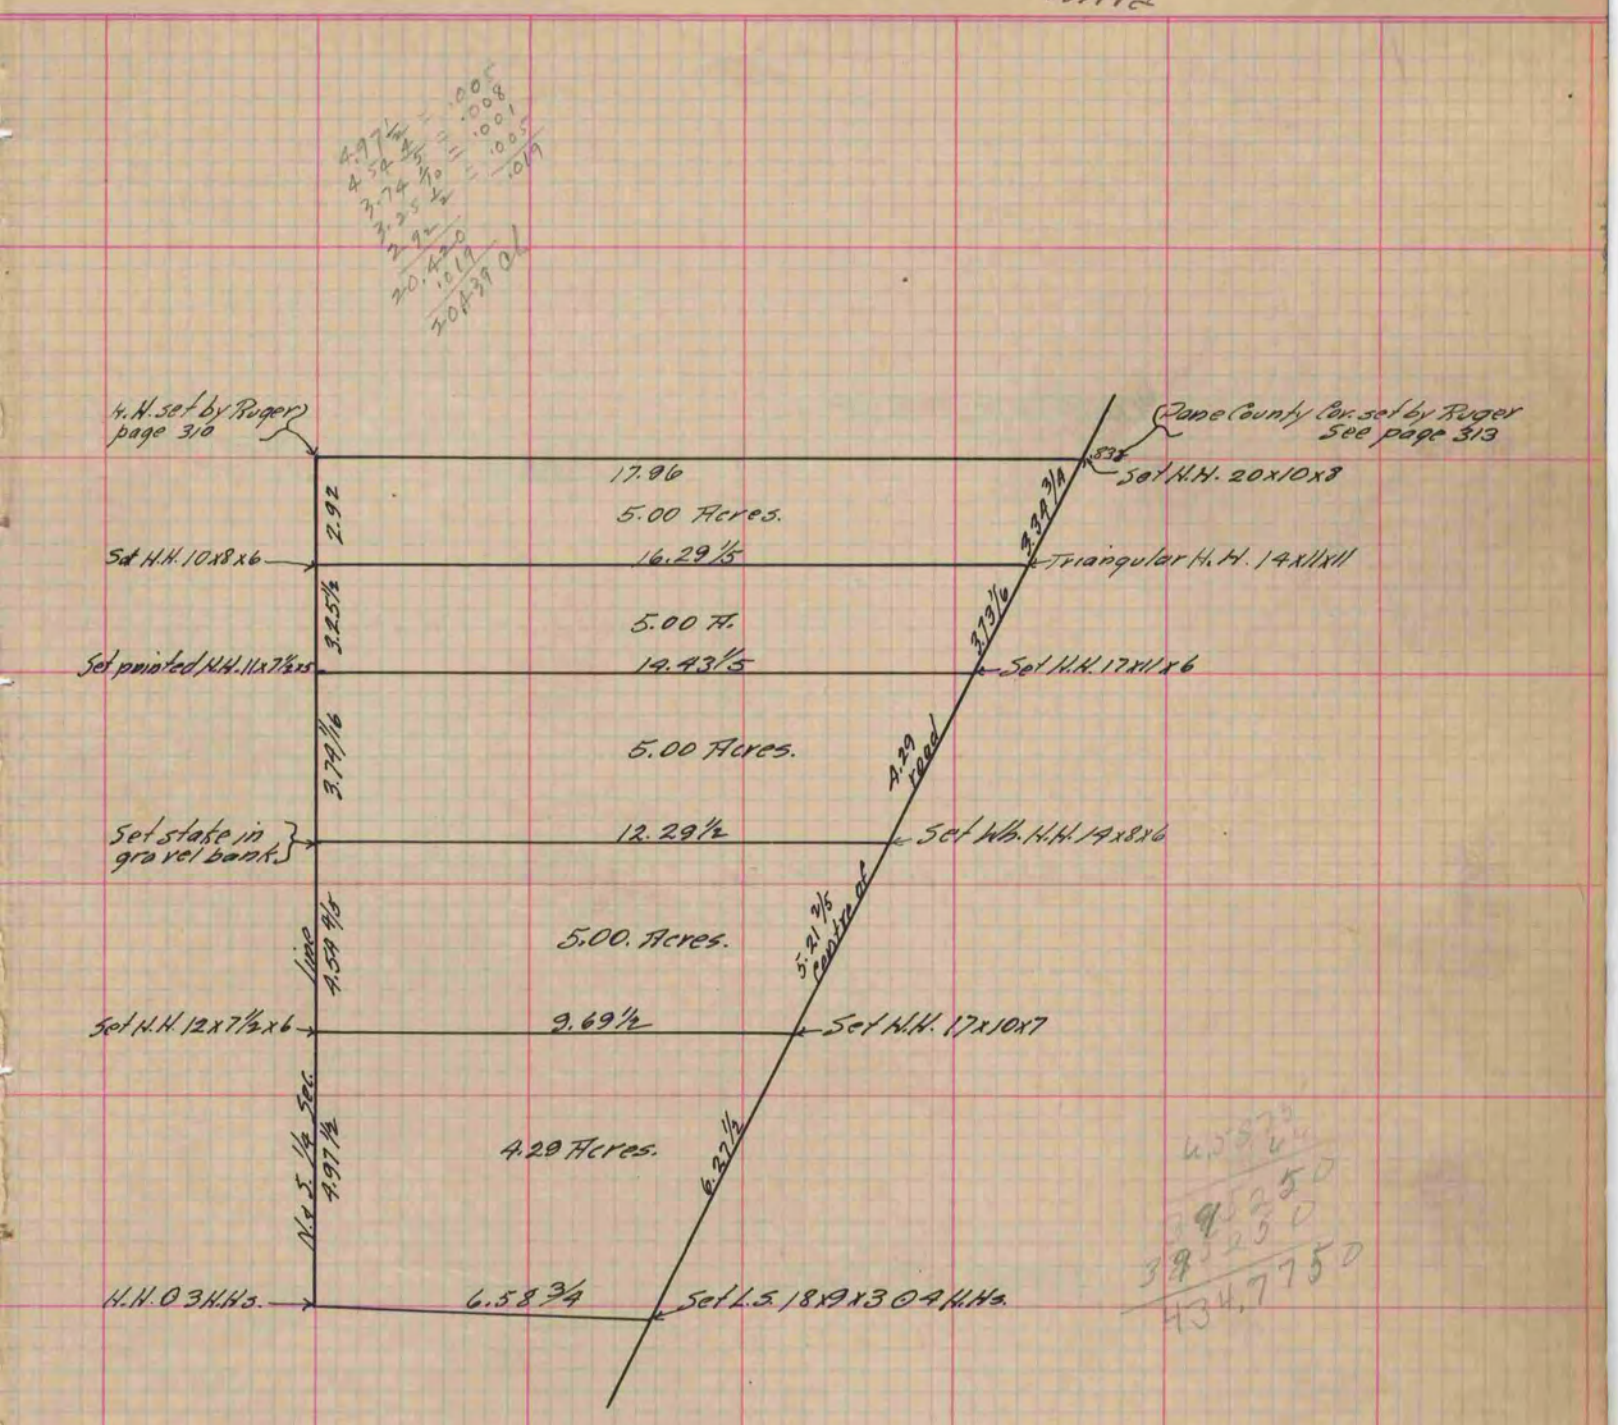

Copied from P. 368 Vol. 2 County Surveyor's Record.