294

PG X 300 JANESVILLE
REC 12/15/95 DAB

PLAT AND RECORD

COUNTY BUILDING
IN CITY OF BELOIT

Of a Survey on Section 19, 20 29 & 30 T 3N. R 14 E. of the 4 P. M. in Johnstown Township

Rock County, Wisconsin, made between July 1, ~~the~~ Dec. 18, 1936

I hereby certify that the following is a correct record of said survey as made by me.

B. J. Gunny
County Surveyor.
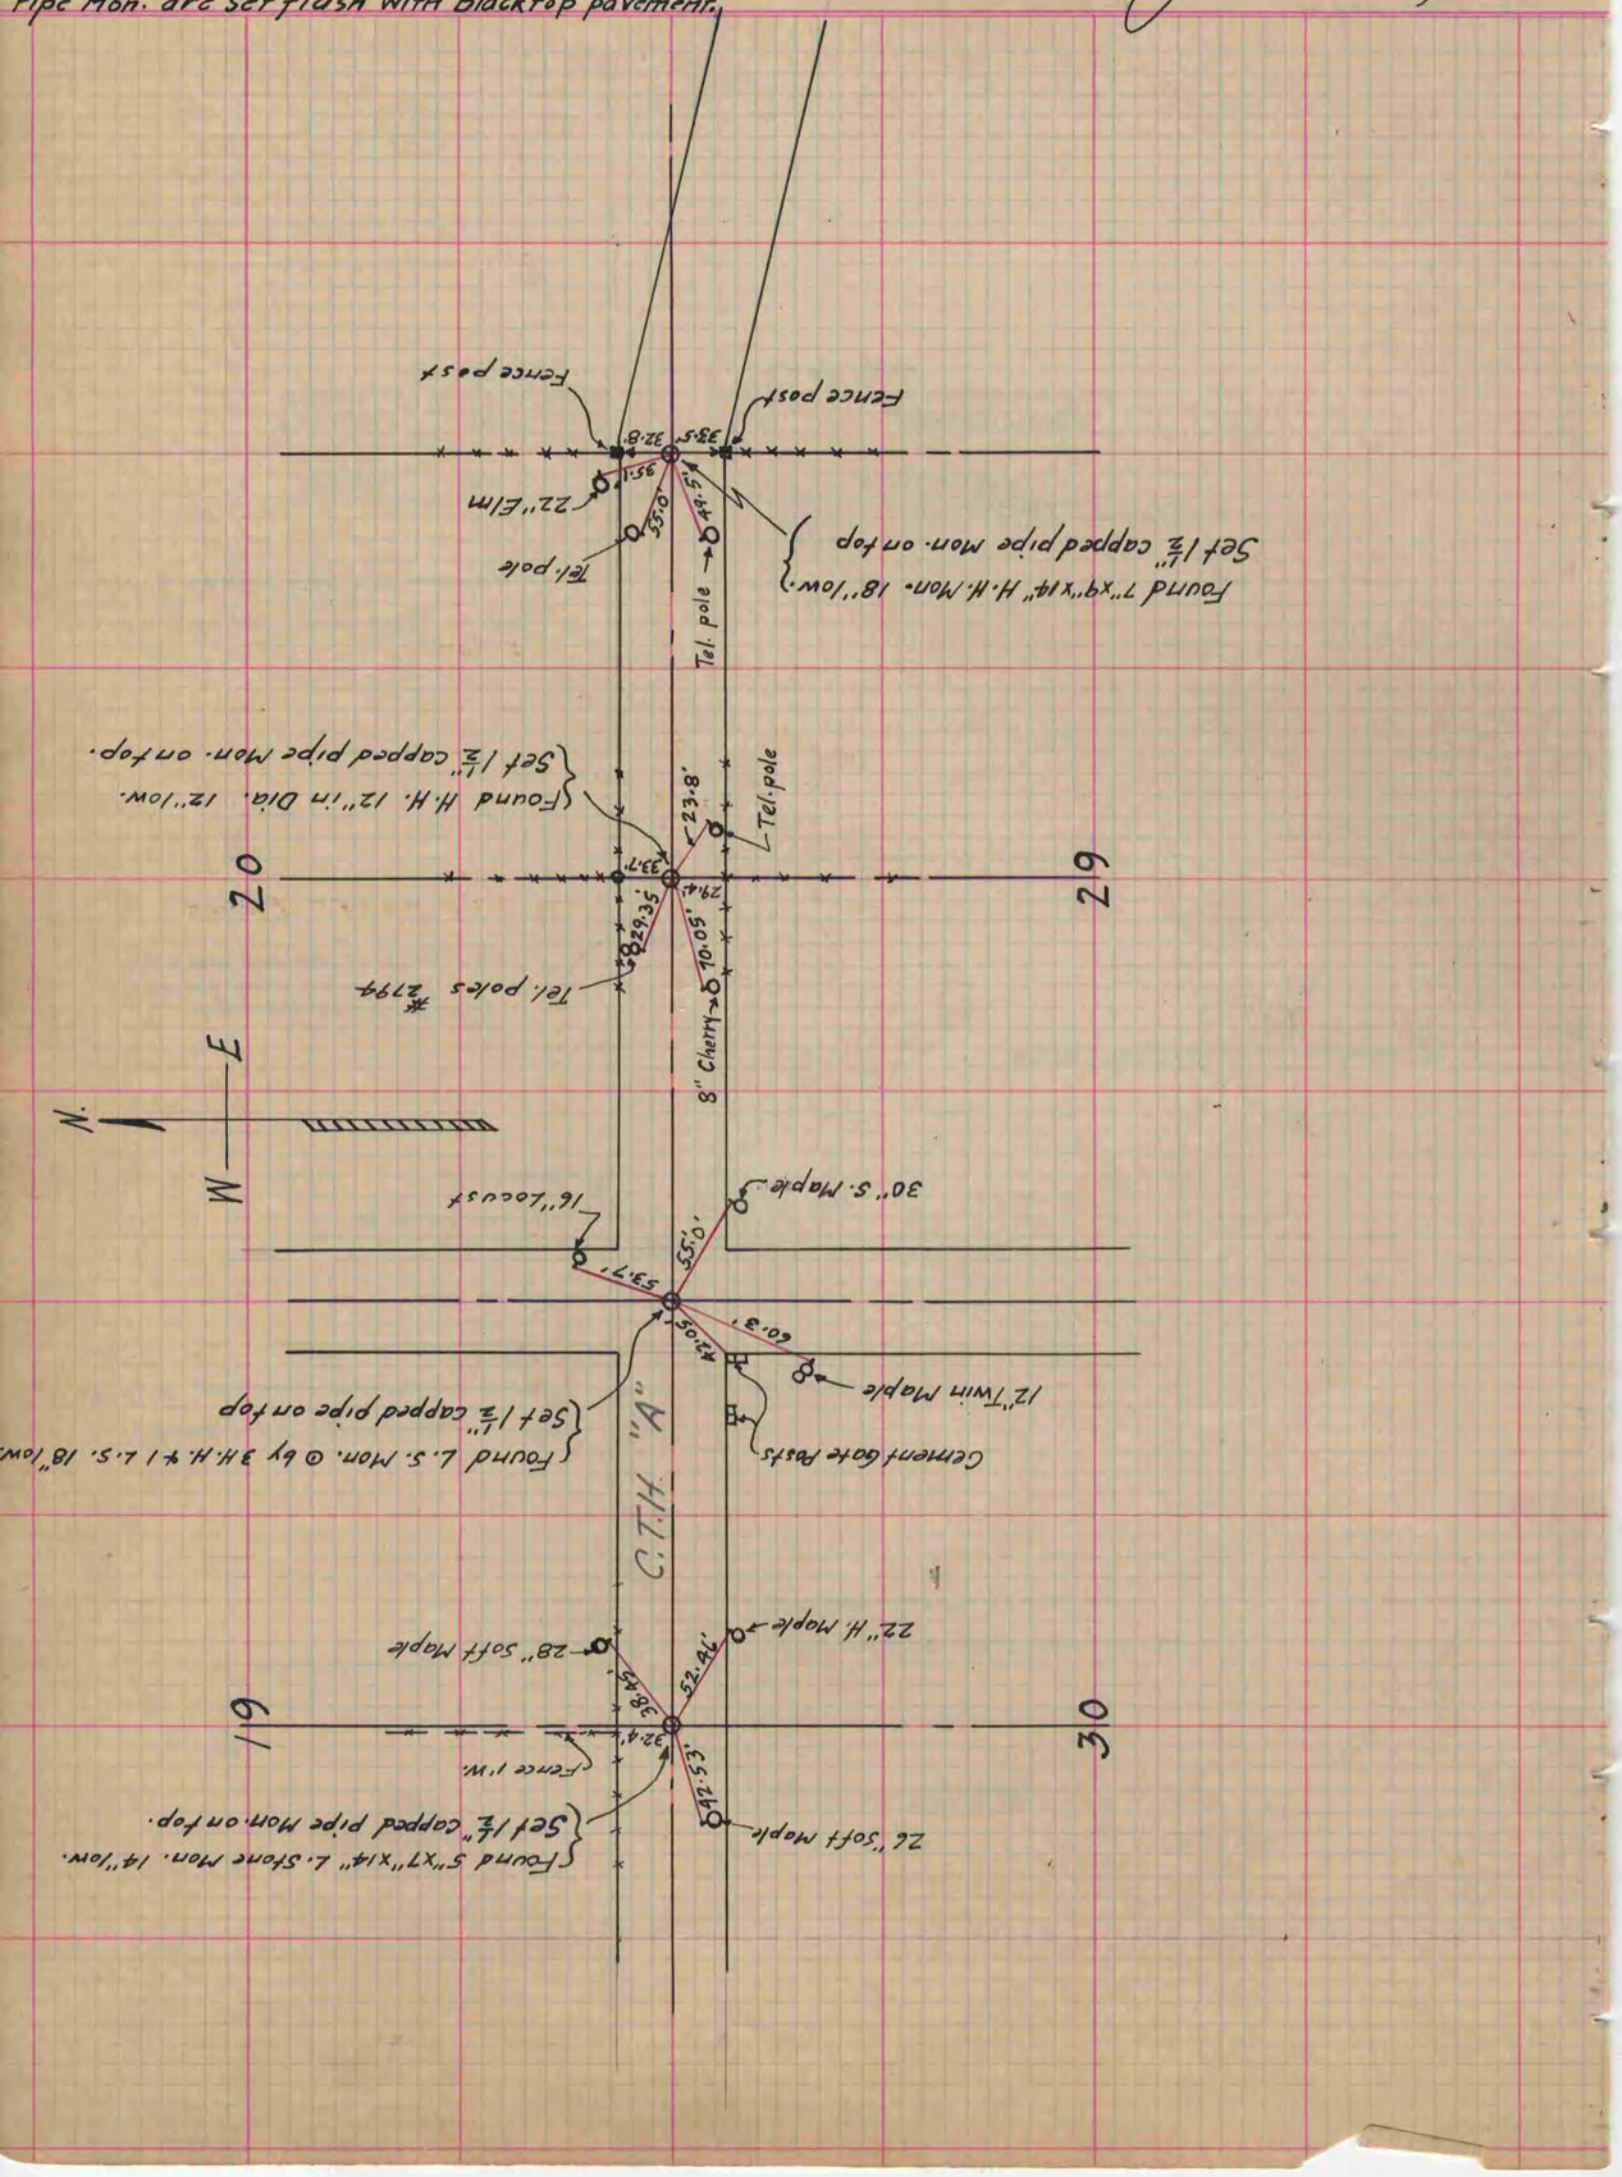
NOTE:
All references are to a 40d. spk. in Poles and Blazed trees, taken before Road was Blacktopped.
Pipe Mon. are set flush with Blacktop pavement.