PLAT AND RECORD

Of a Survey on Section 15 T 3 R 13 E. of the 4 P. M. in Harmony Township

Rock County, Wisconsin, made June the 9th & 13th 1866

I hereby certify that the following is a correct record of said survey as made by me.

(Signed) S.D. Locke

County Surveyor.

COUNTY BUILDING
IN CITY OF BELOIT

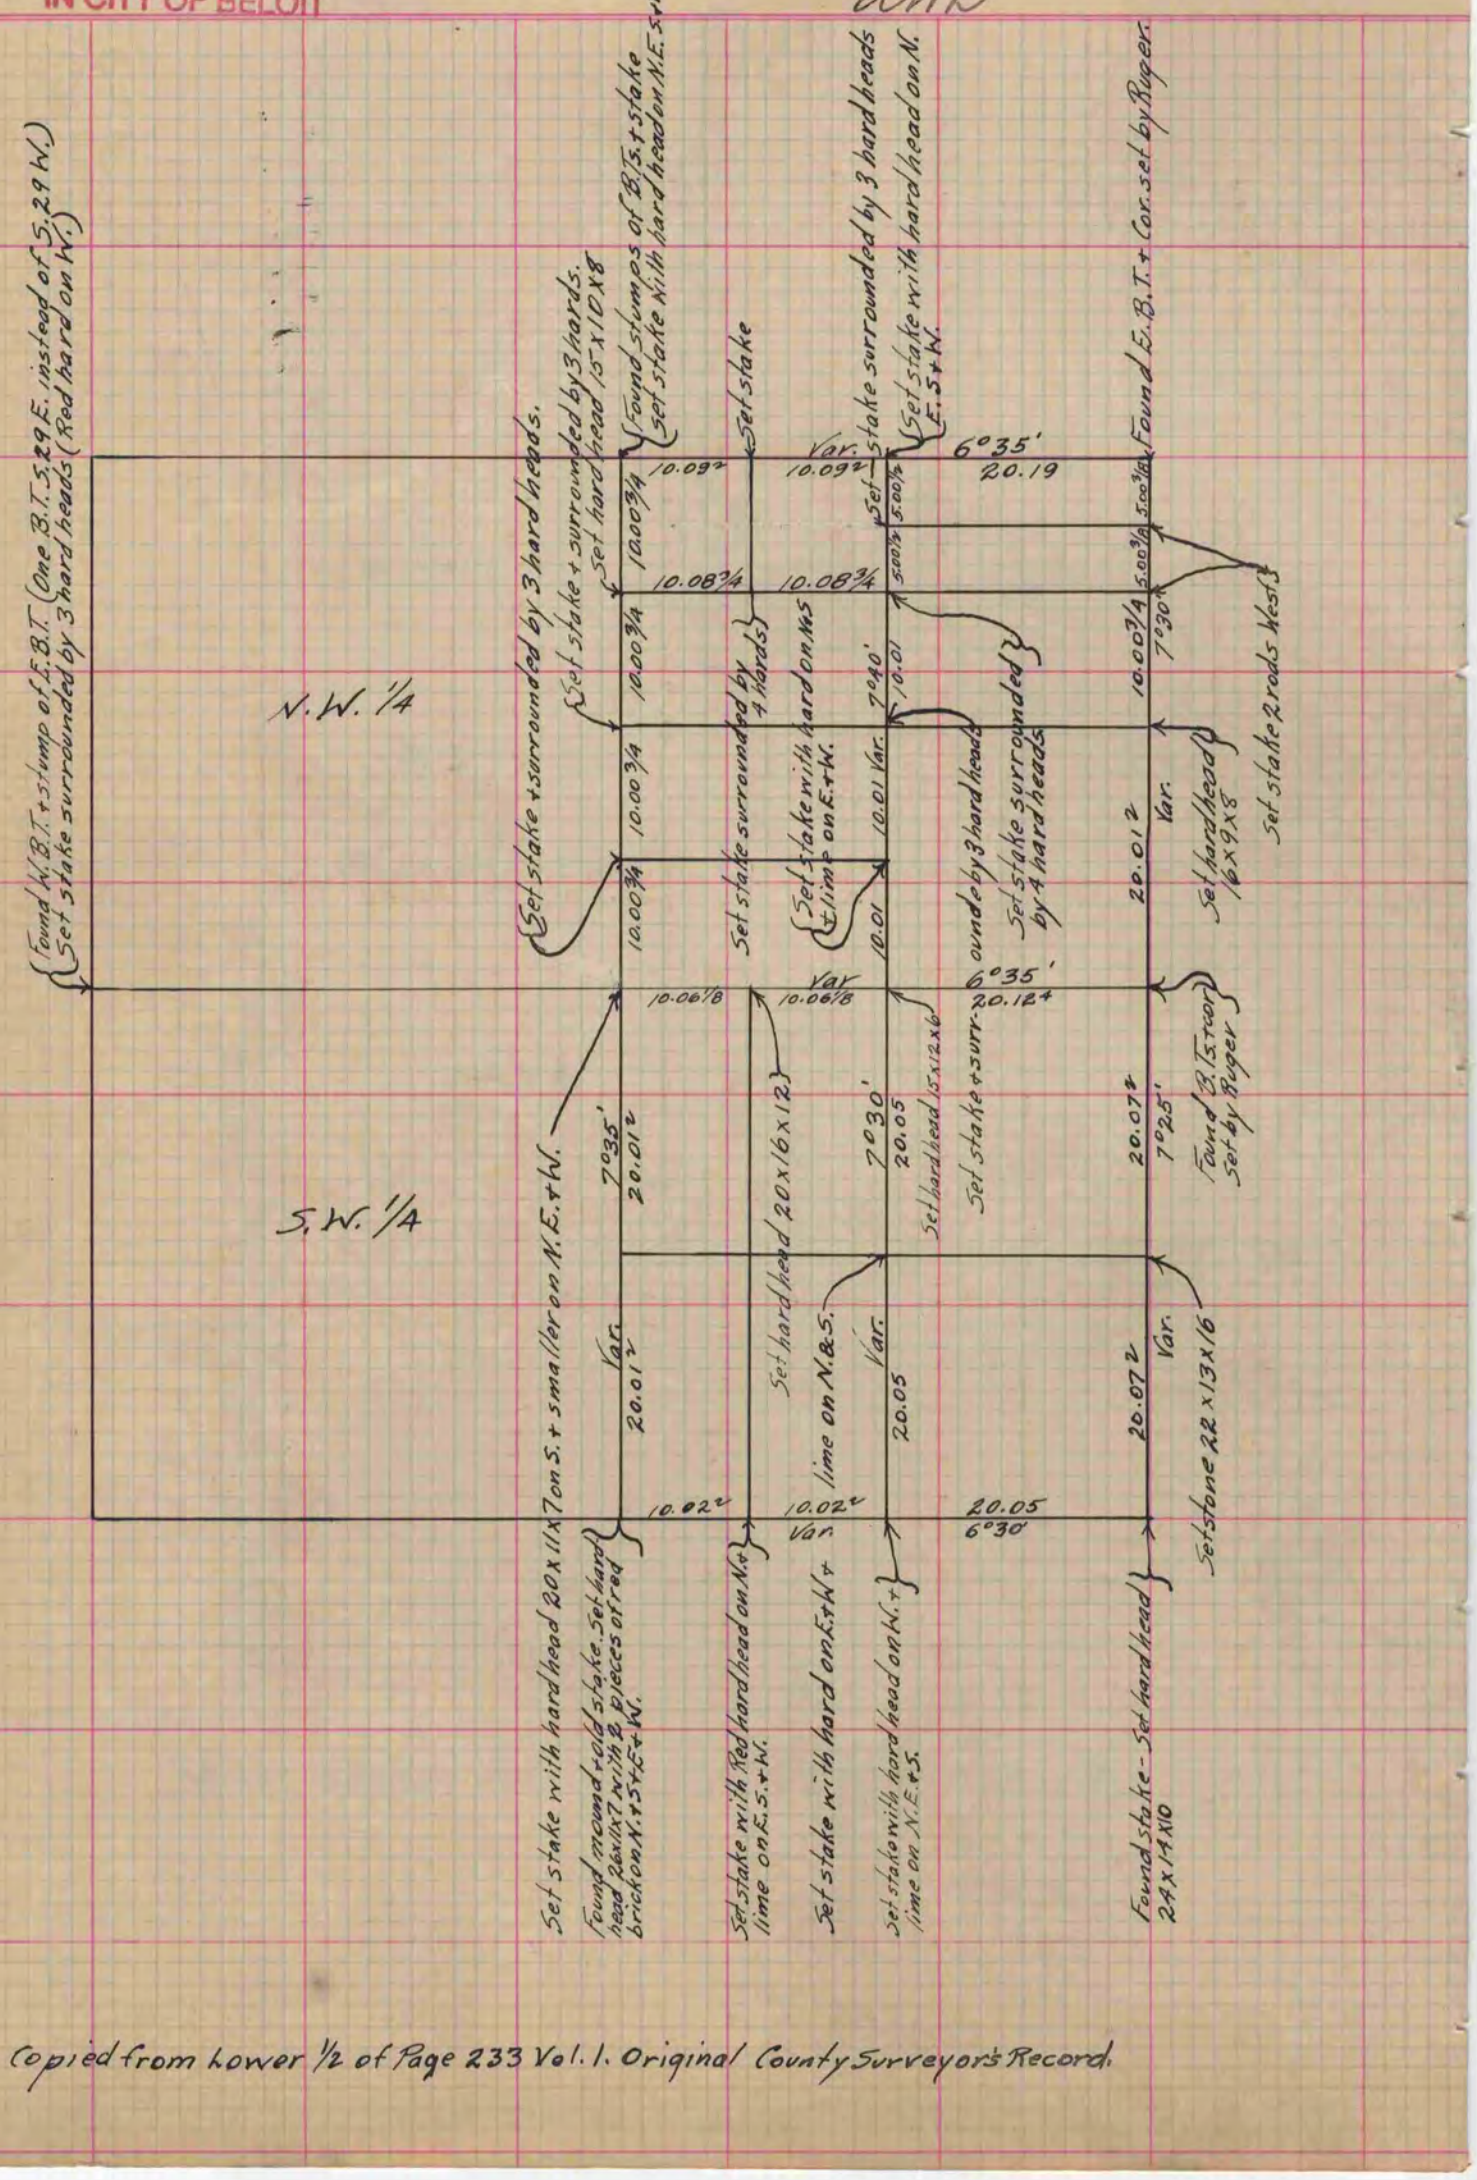

Copied from Lower 1/2 of Page 233 Vol. 1. Original County Surveyor's Record.