289

PLAT AND RECORD

PG 295 JANESVILLE
REC 12/15/75
DAB

COUNTY BUILDING
IN CITY OF BELOIT

Of a Survey on Section 19, 30, 31 T 2 N. R 13 E. of the 4 P. M. in La Prairie Township
" " " " 24, 25, 36 T. 2 N. R 12 E. " " " Rock "
Rock County, Wisconsin, made between July 1 ~~&~~ Dec. 18, 1936.

I hereby certify that the following is a correct record of said survey as made by me.

B. J. Bunny
County Surveyor
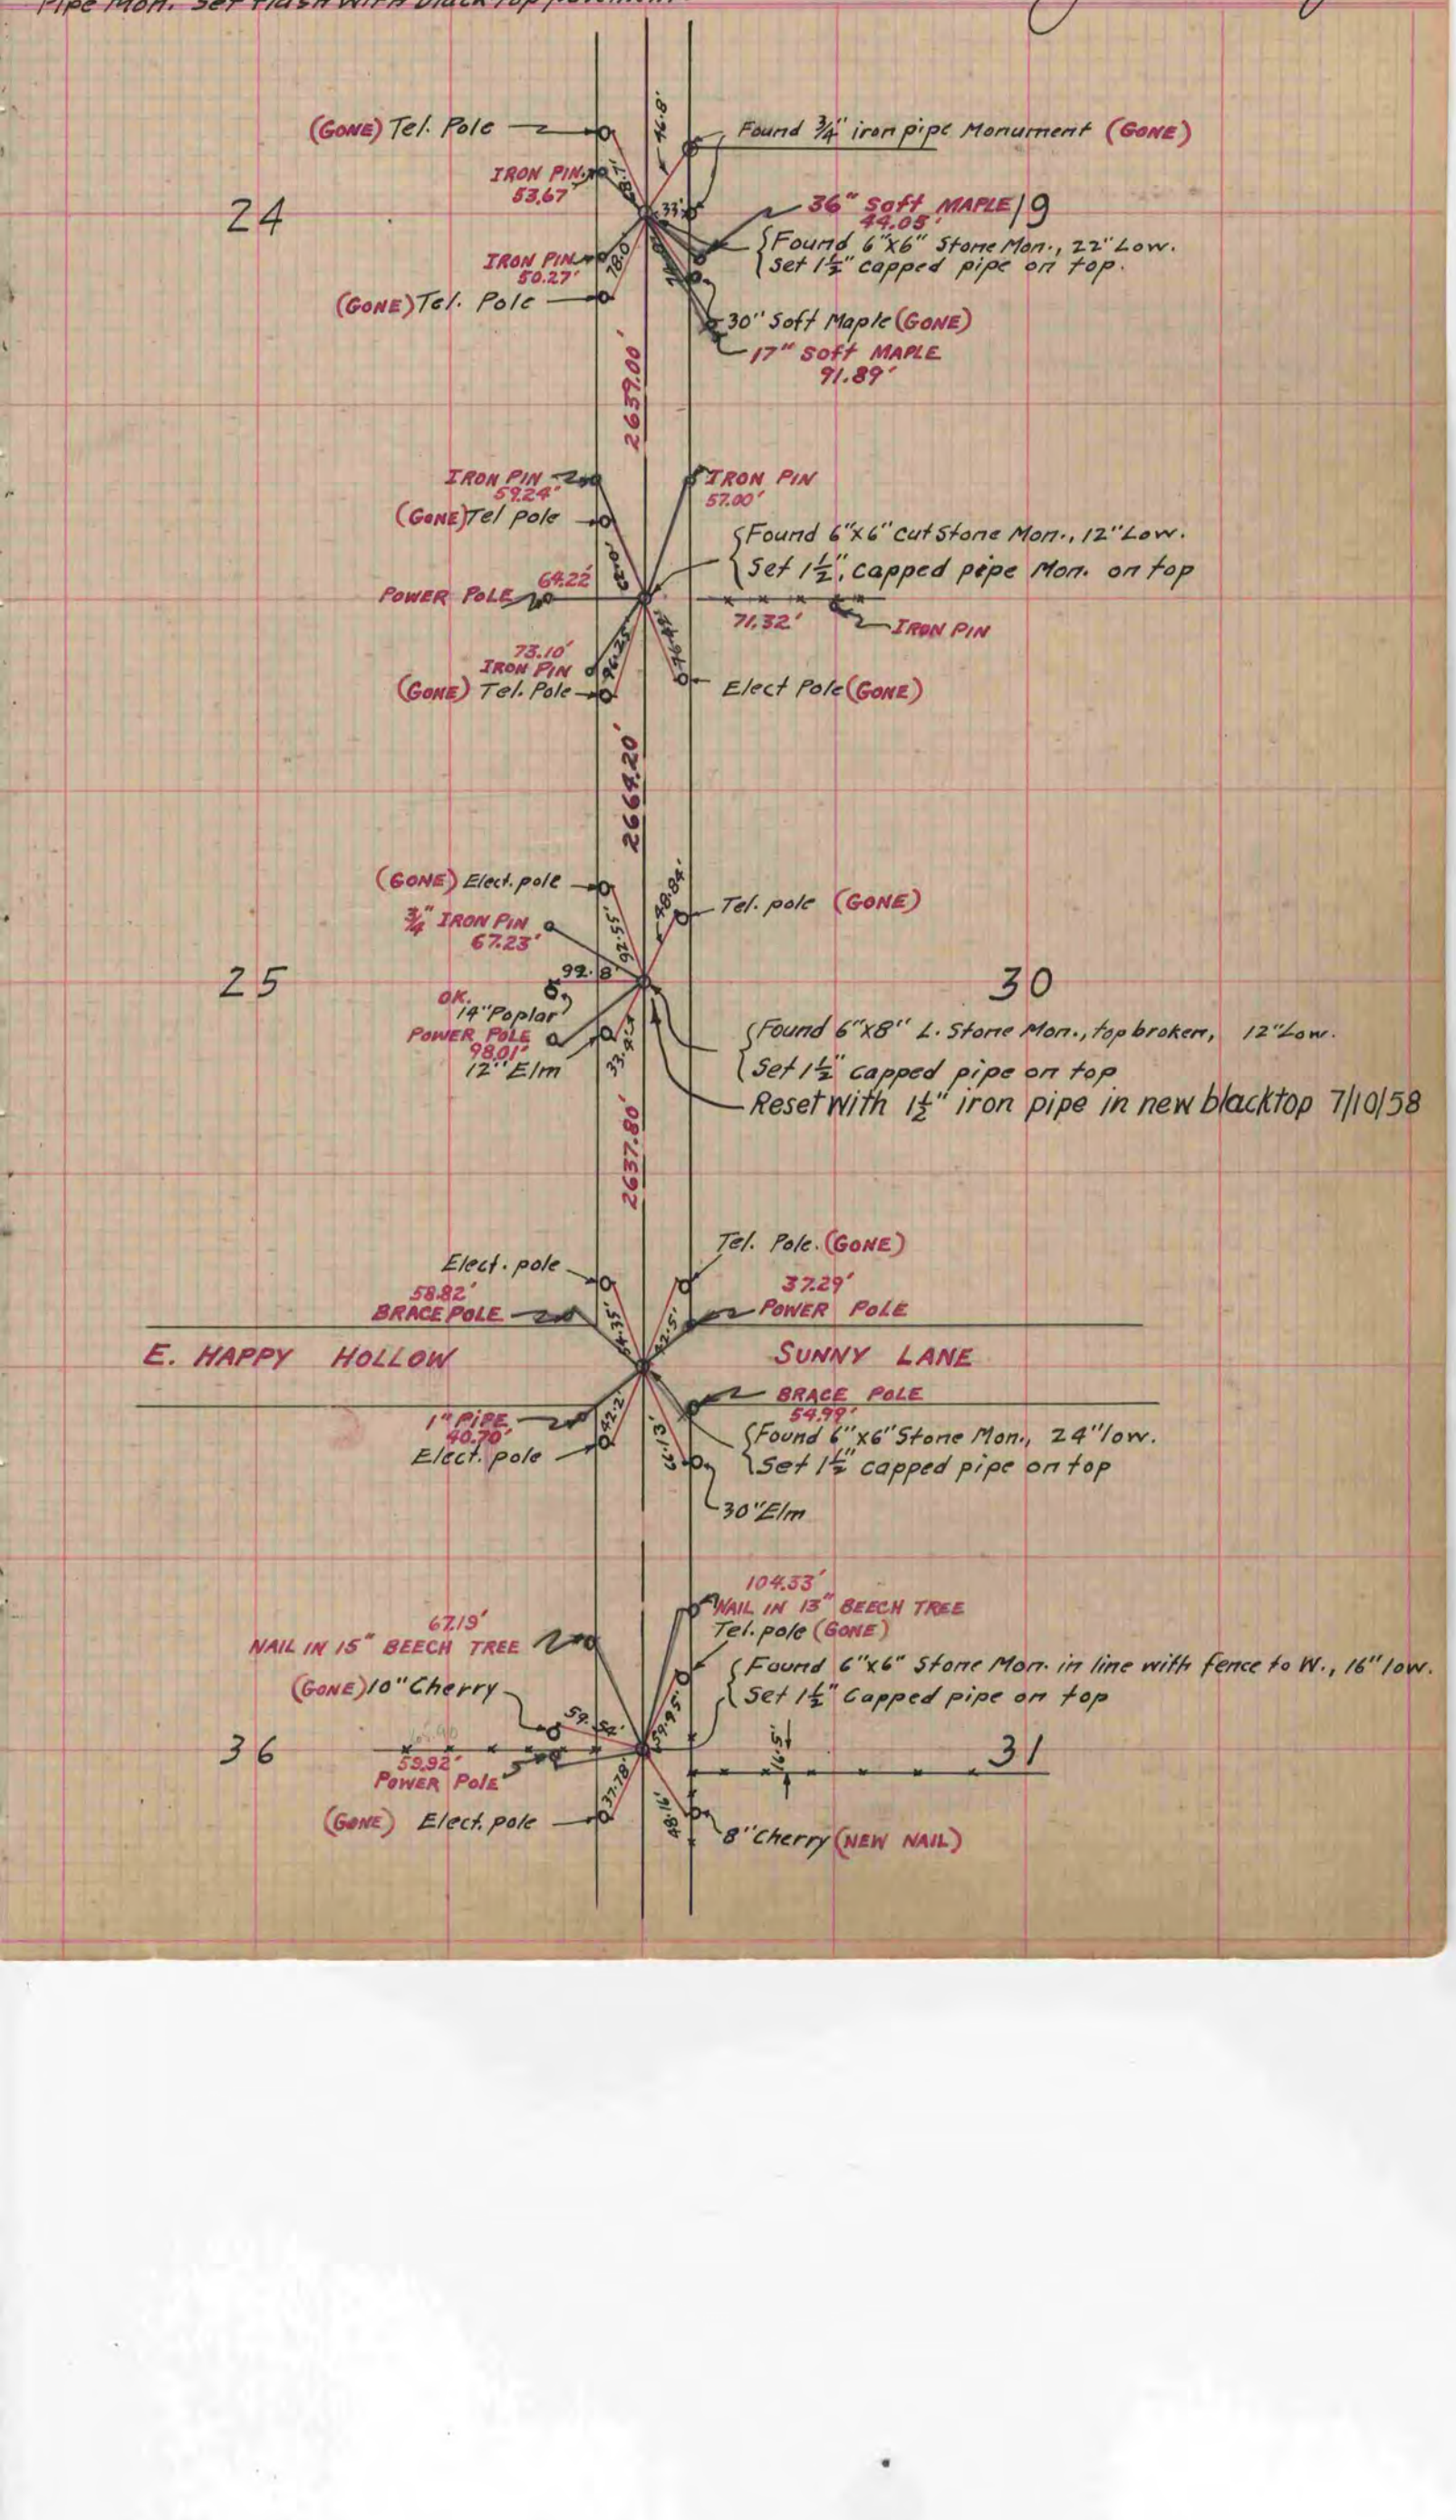
NOTE:
All references are to 40d. Spk. in Poles & blazed trees, taken before the Road was Blacktopped
Pipe Mon. set flush with Blacktop pavement.