172

PG ~~172~~ 190 JANESVILLE
REC 12/12/75 DAB

PLAT AND RECORD

Of a Survey on Section 25 & 26 T 1 N., R. 11 E. of the 4 P. M. in Newark Township

Rock County, Wisconsin, made November the 9 & 10 1932

I hereby certify that the following is a correct record of said survey as made by me.

COUNTY BUILDING
IN CITY OF BELOIT

B. J. Bunny
County Surveyor.
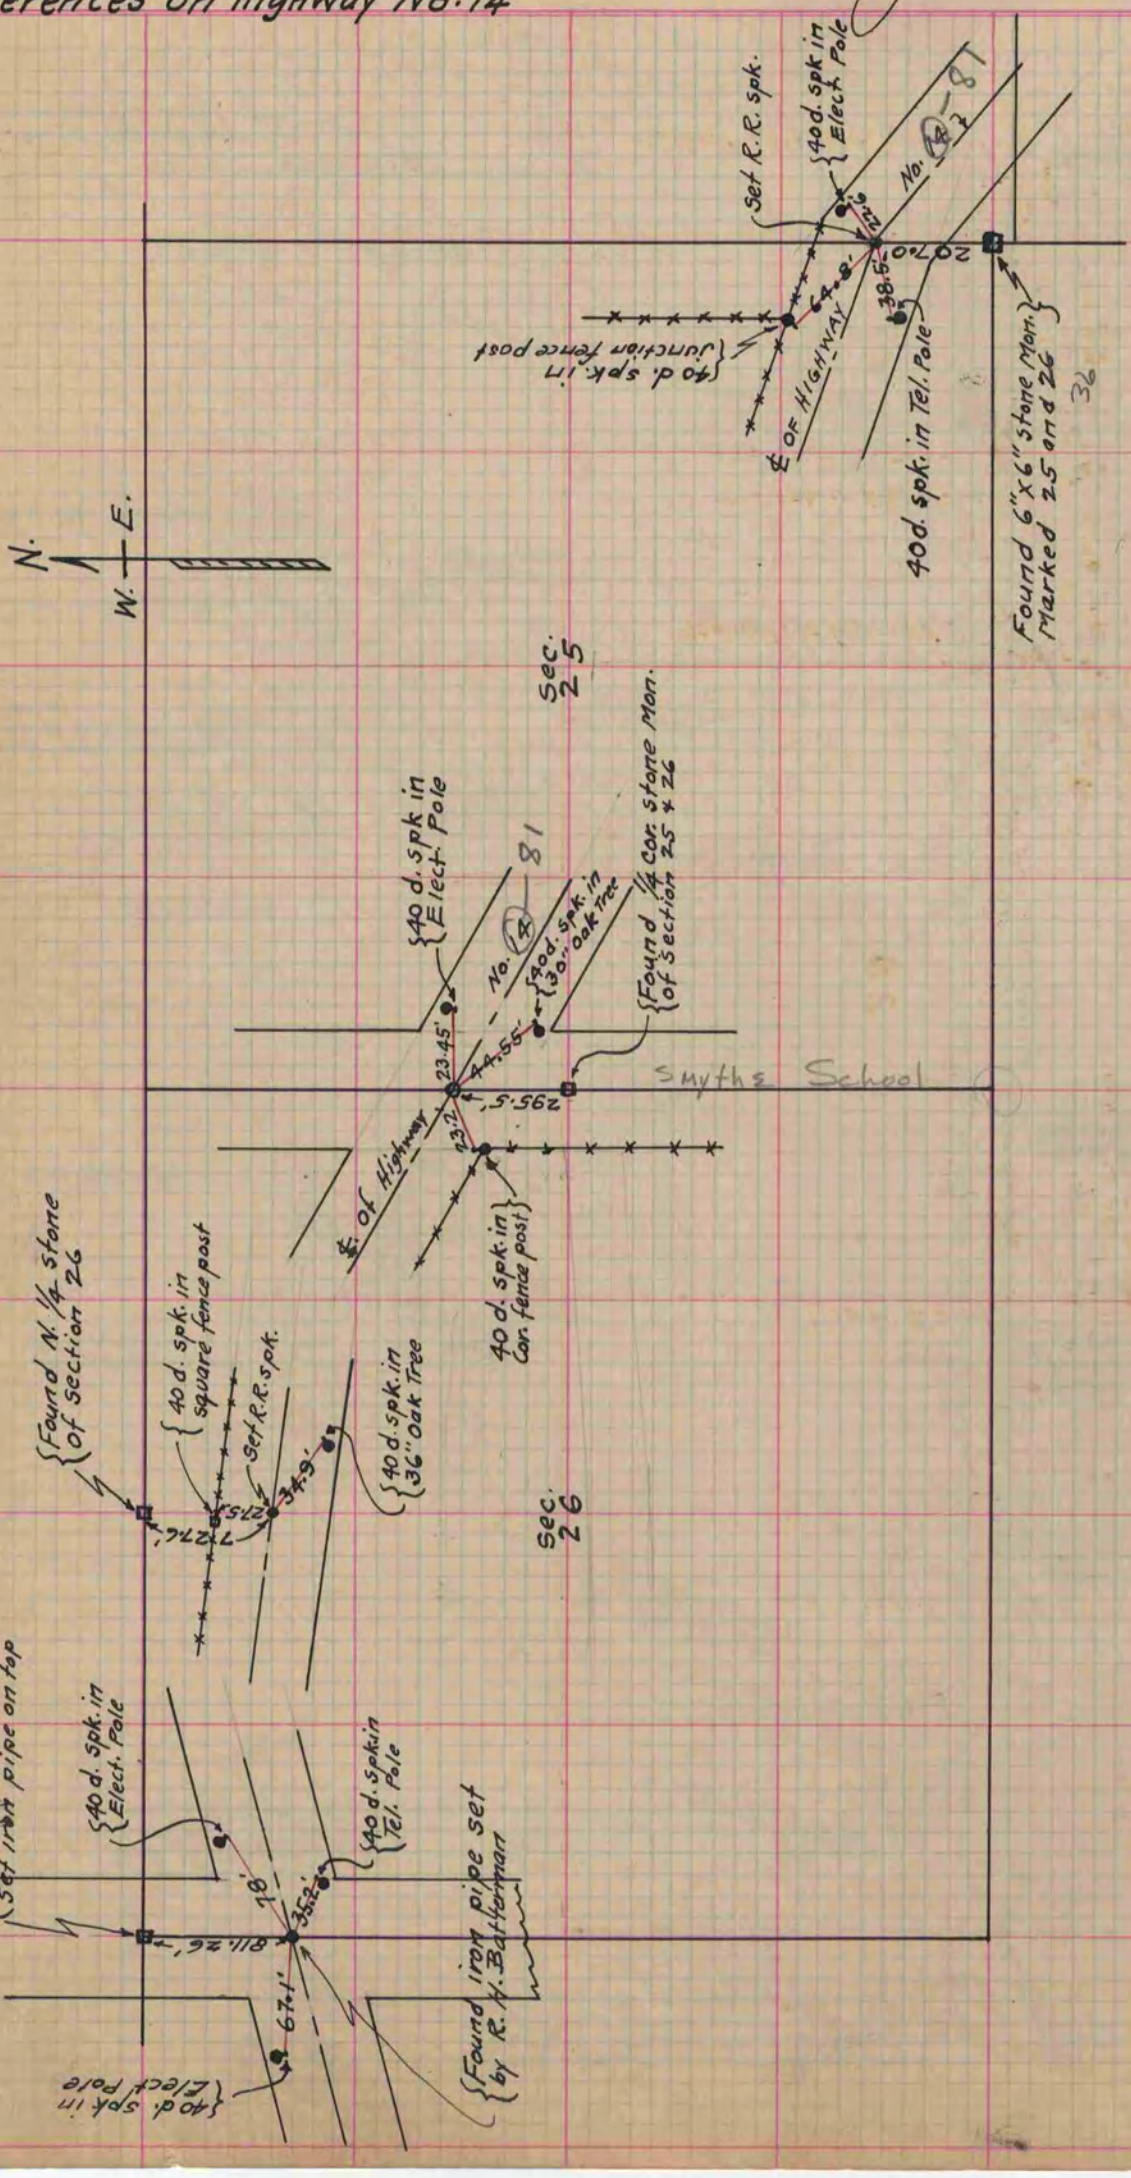
References on Highway No. 14