PLAT AND RECORD

Of a Survey on Sections 31 & 32 T 4 R 11 E. of the 4 P. M. in Porter Township

Rock County, Wisconsin, made April the 22, 23 & 24 1874

I hereby certify that the following is a correct record of said survey as made by me.

(Signed) Edward Ruger
ERR
County Surveyor.

COUNTY BUILDING
IN CITY OF BELOIT

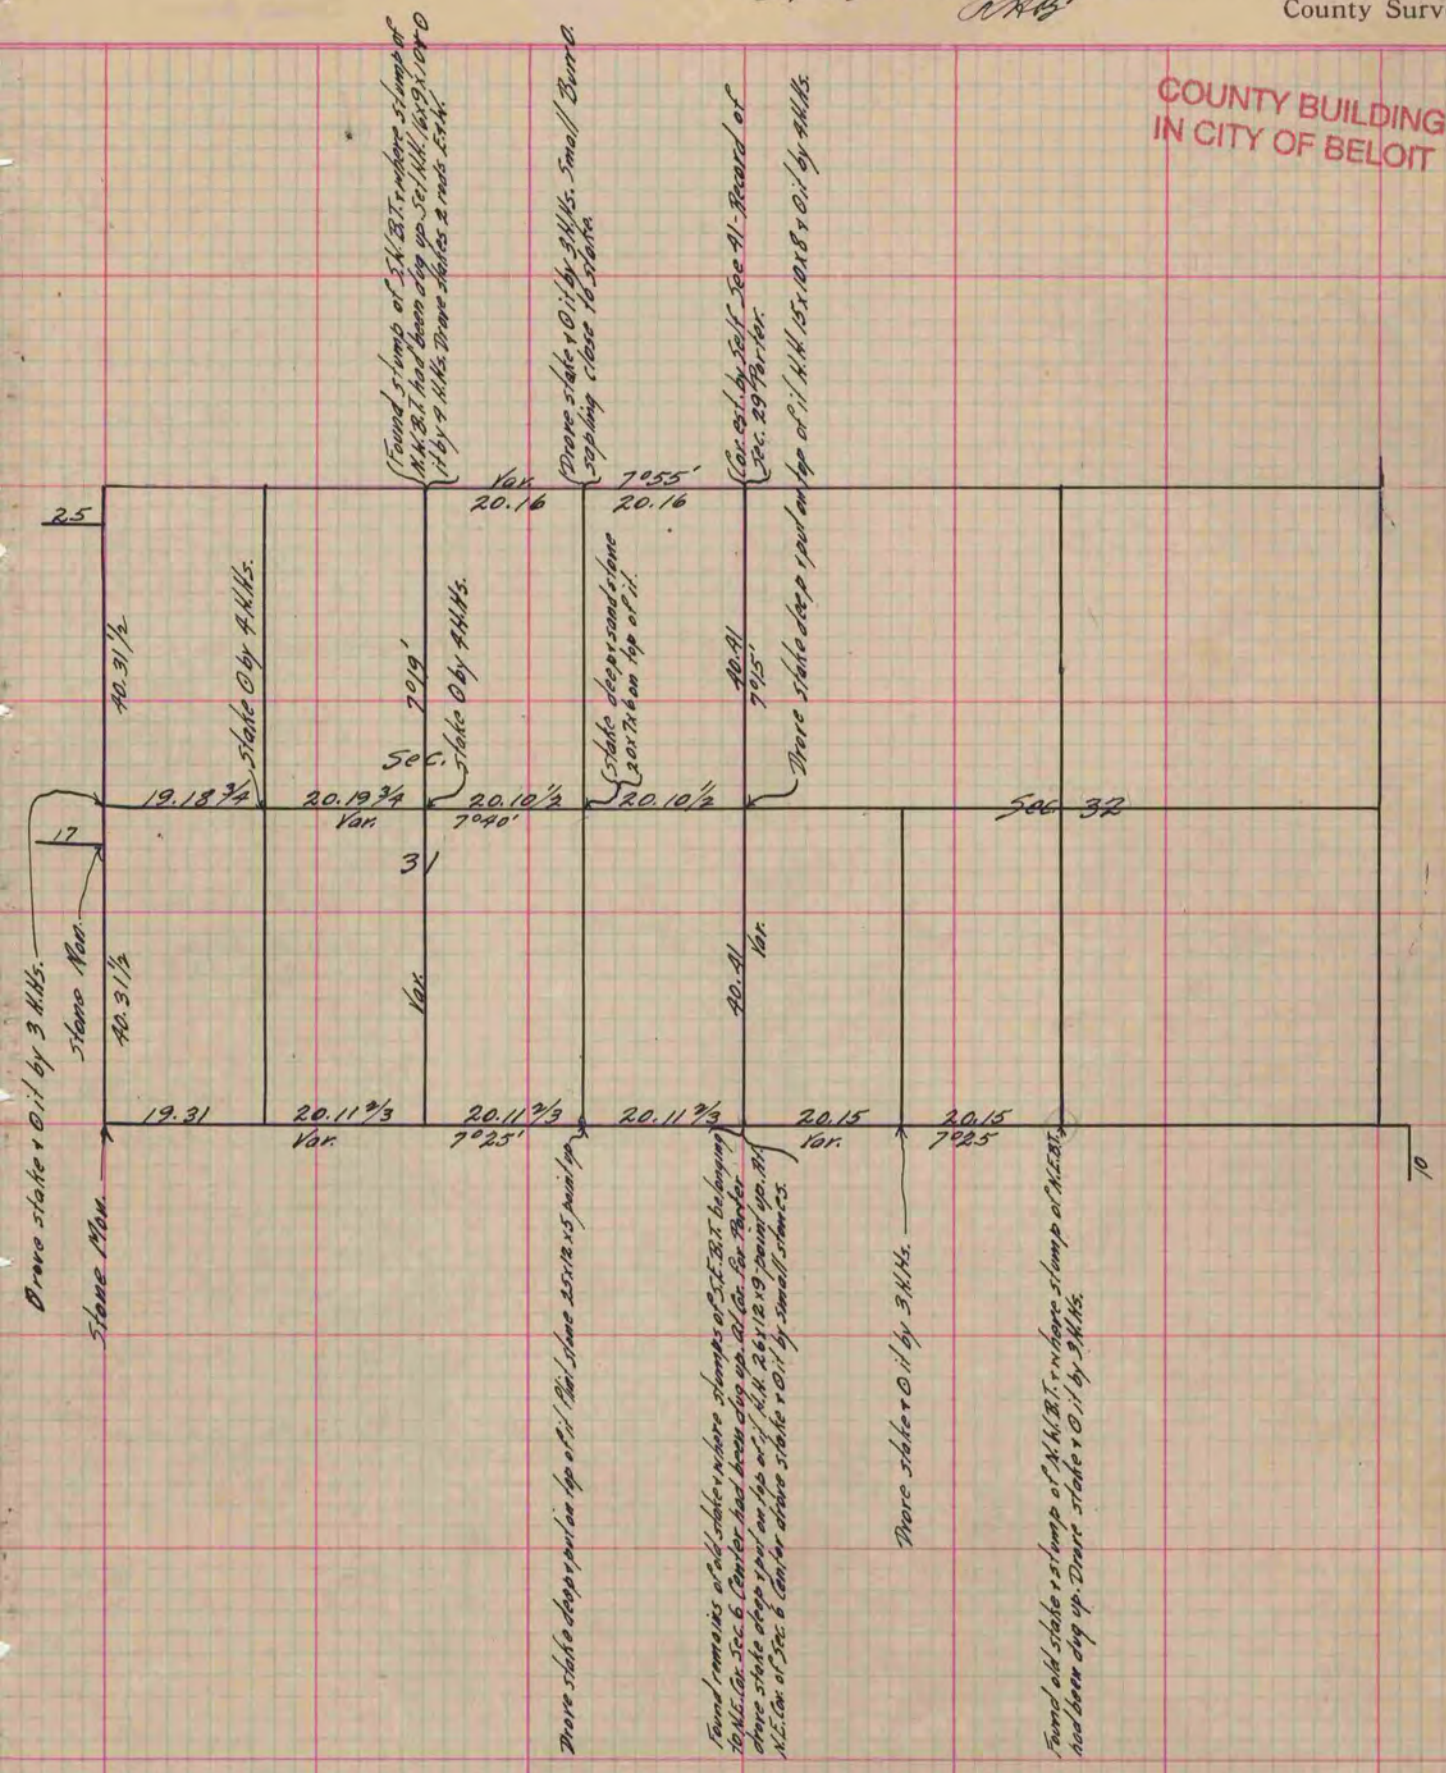

Copied from Page 121 Vol. 2 Original County Surveyor's Record.