259

PLAT AND RECORD

PG 265 # JANESVILLE
REC 12/15/75 DAB

Of a Survey on N.W. ¼ Section 26 T 4N. R 13 E. of the 4 P. M. in Milton Township

Rock County, Wisconsin, made July the 8th 12 1935.

I hereby certify that the following is a correct record of said survey as made by me.

COUNTY BUILDING
IN CITY OF BELOIT
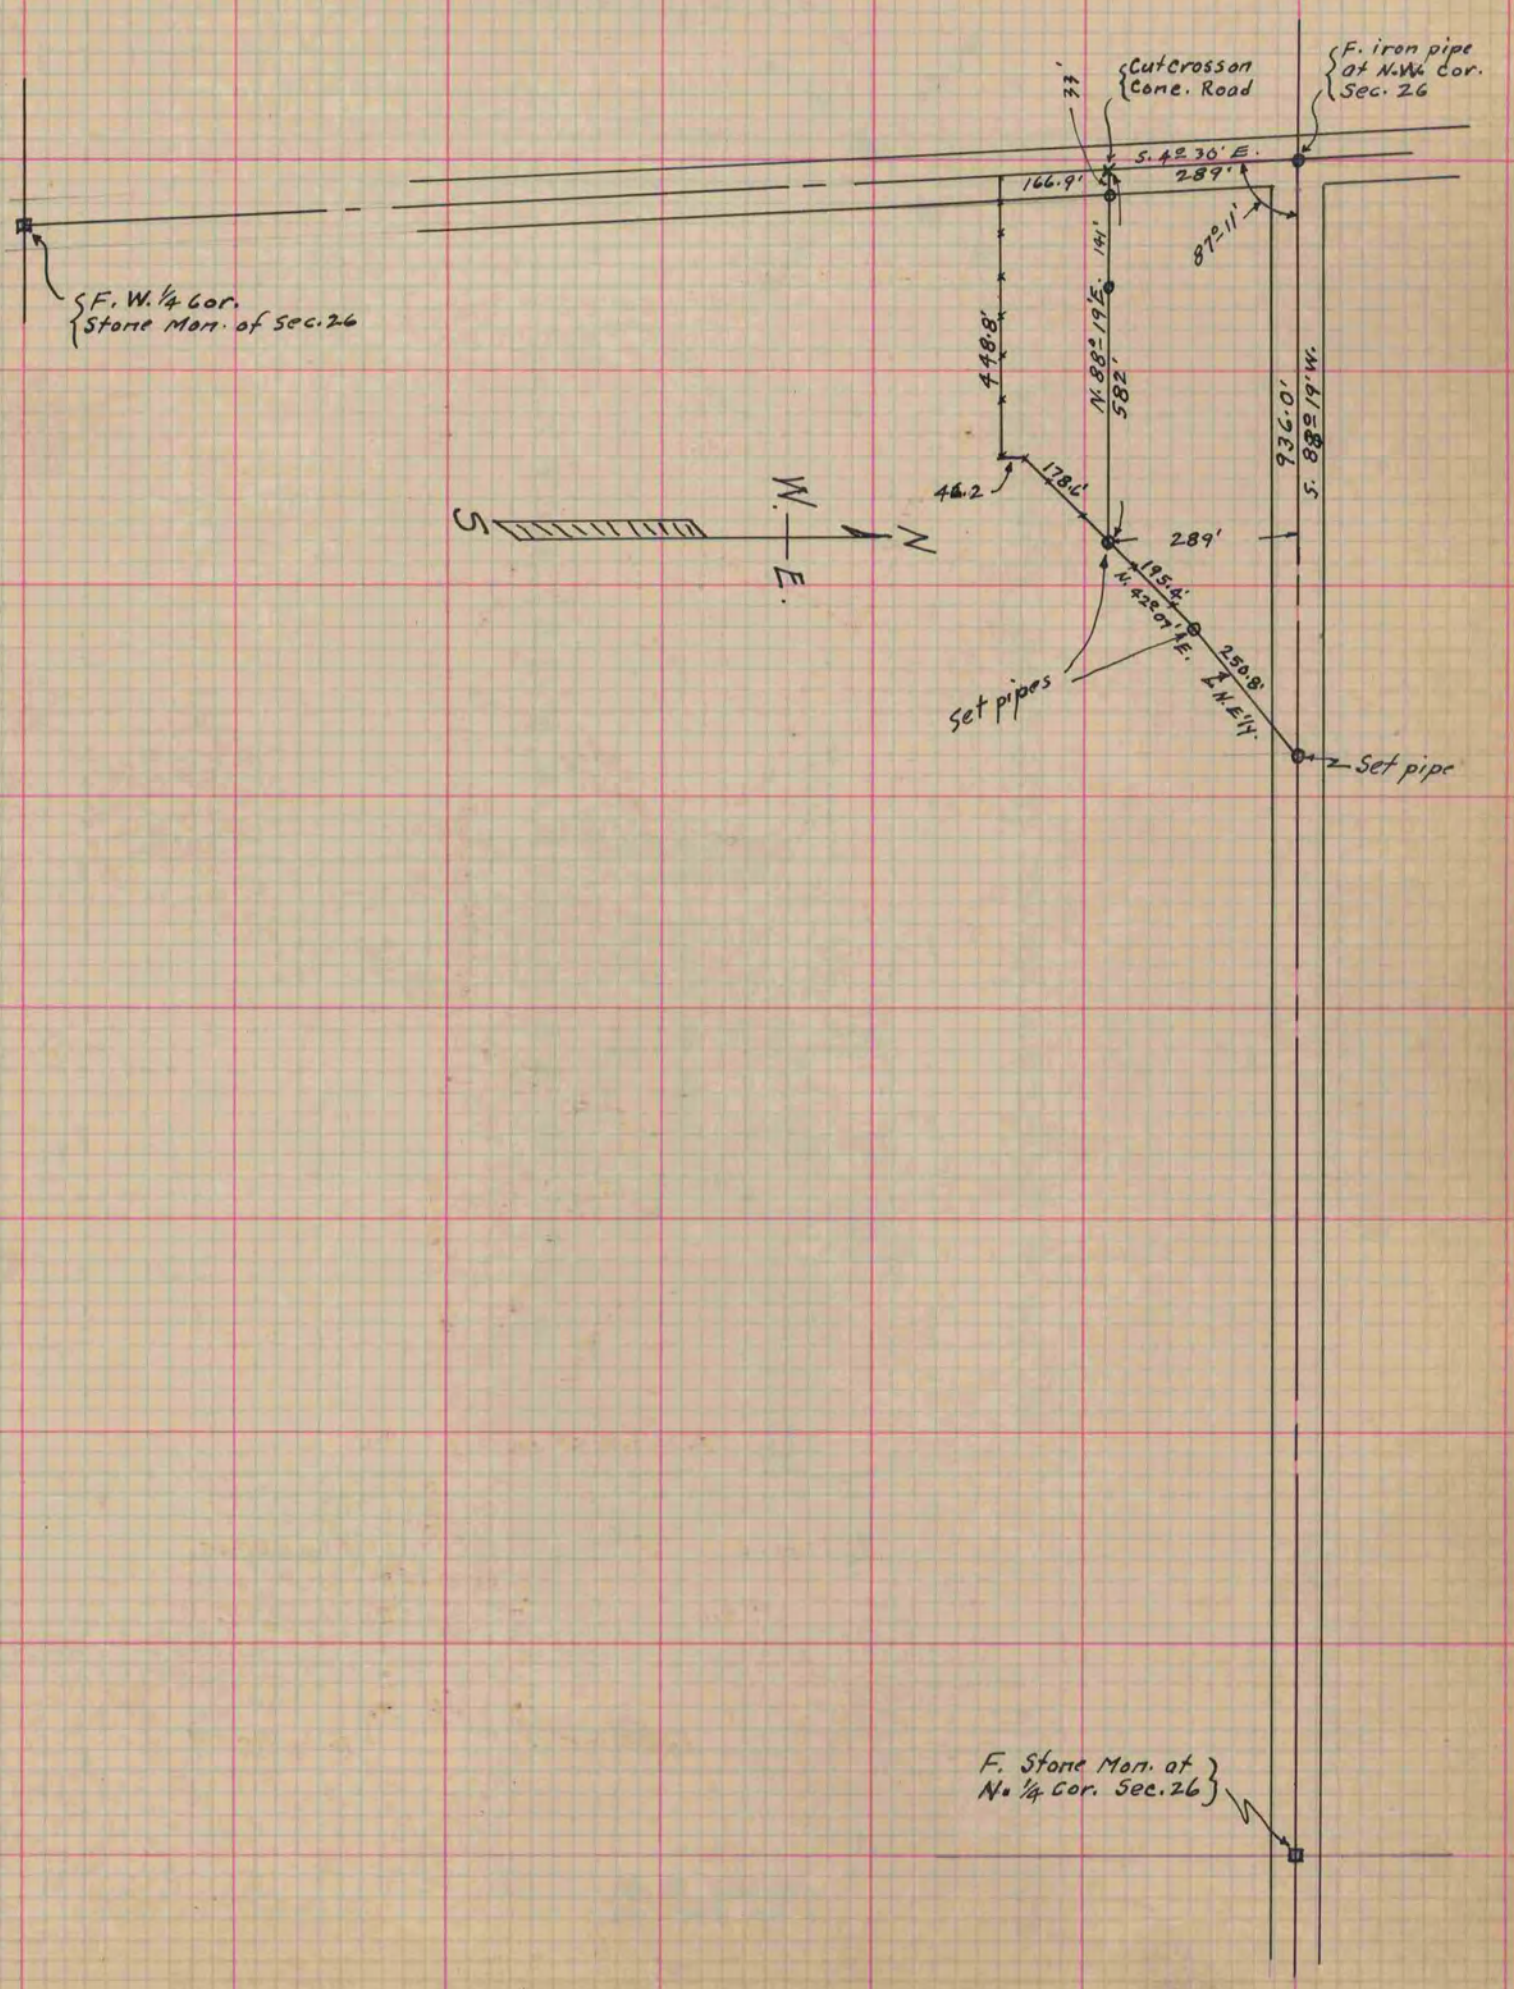
B. J. Sunny
County Surveyor.