PLAT AND RECORD

527

Of a Survey on Section 1 T 1 R 12 E. of the 4 P. M. in BELOIT Township

Rock County, Wisconsin, made Jan., Feb. the March 1958

I hereby certify that the following is a correct record of said survey as made by me.

COUNTY BUILDING
IN CITY OF BELOIT
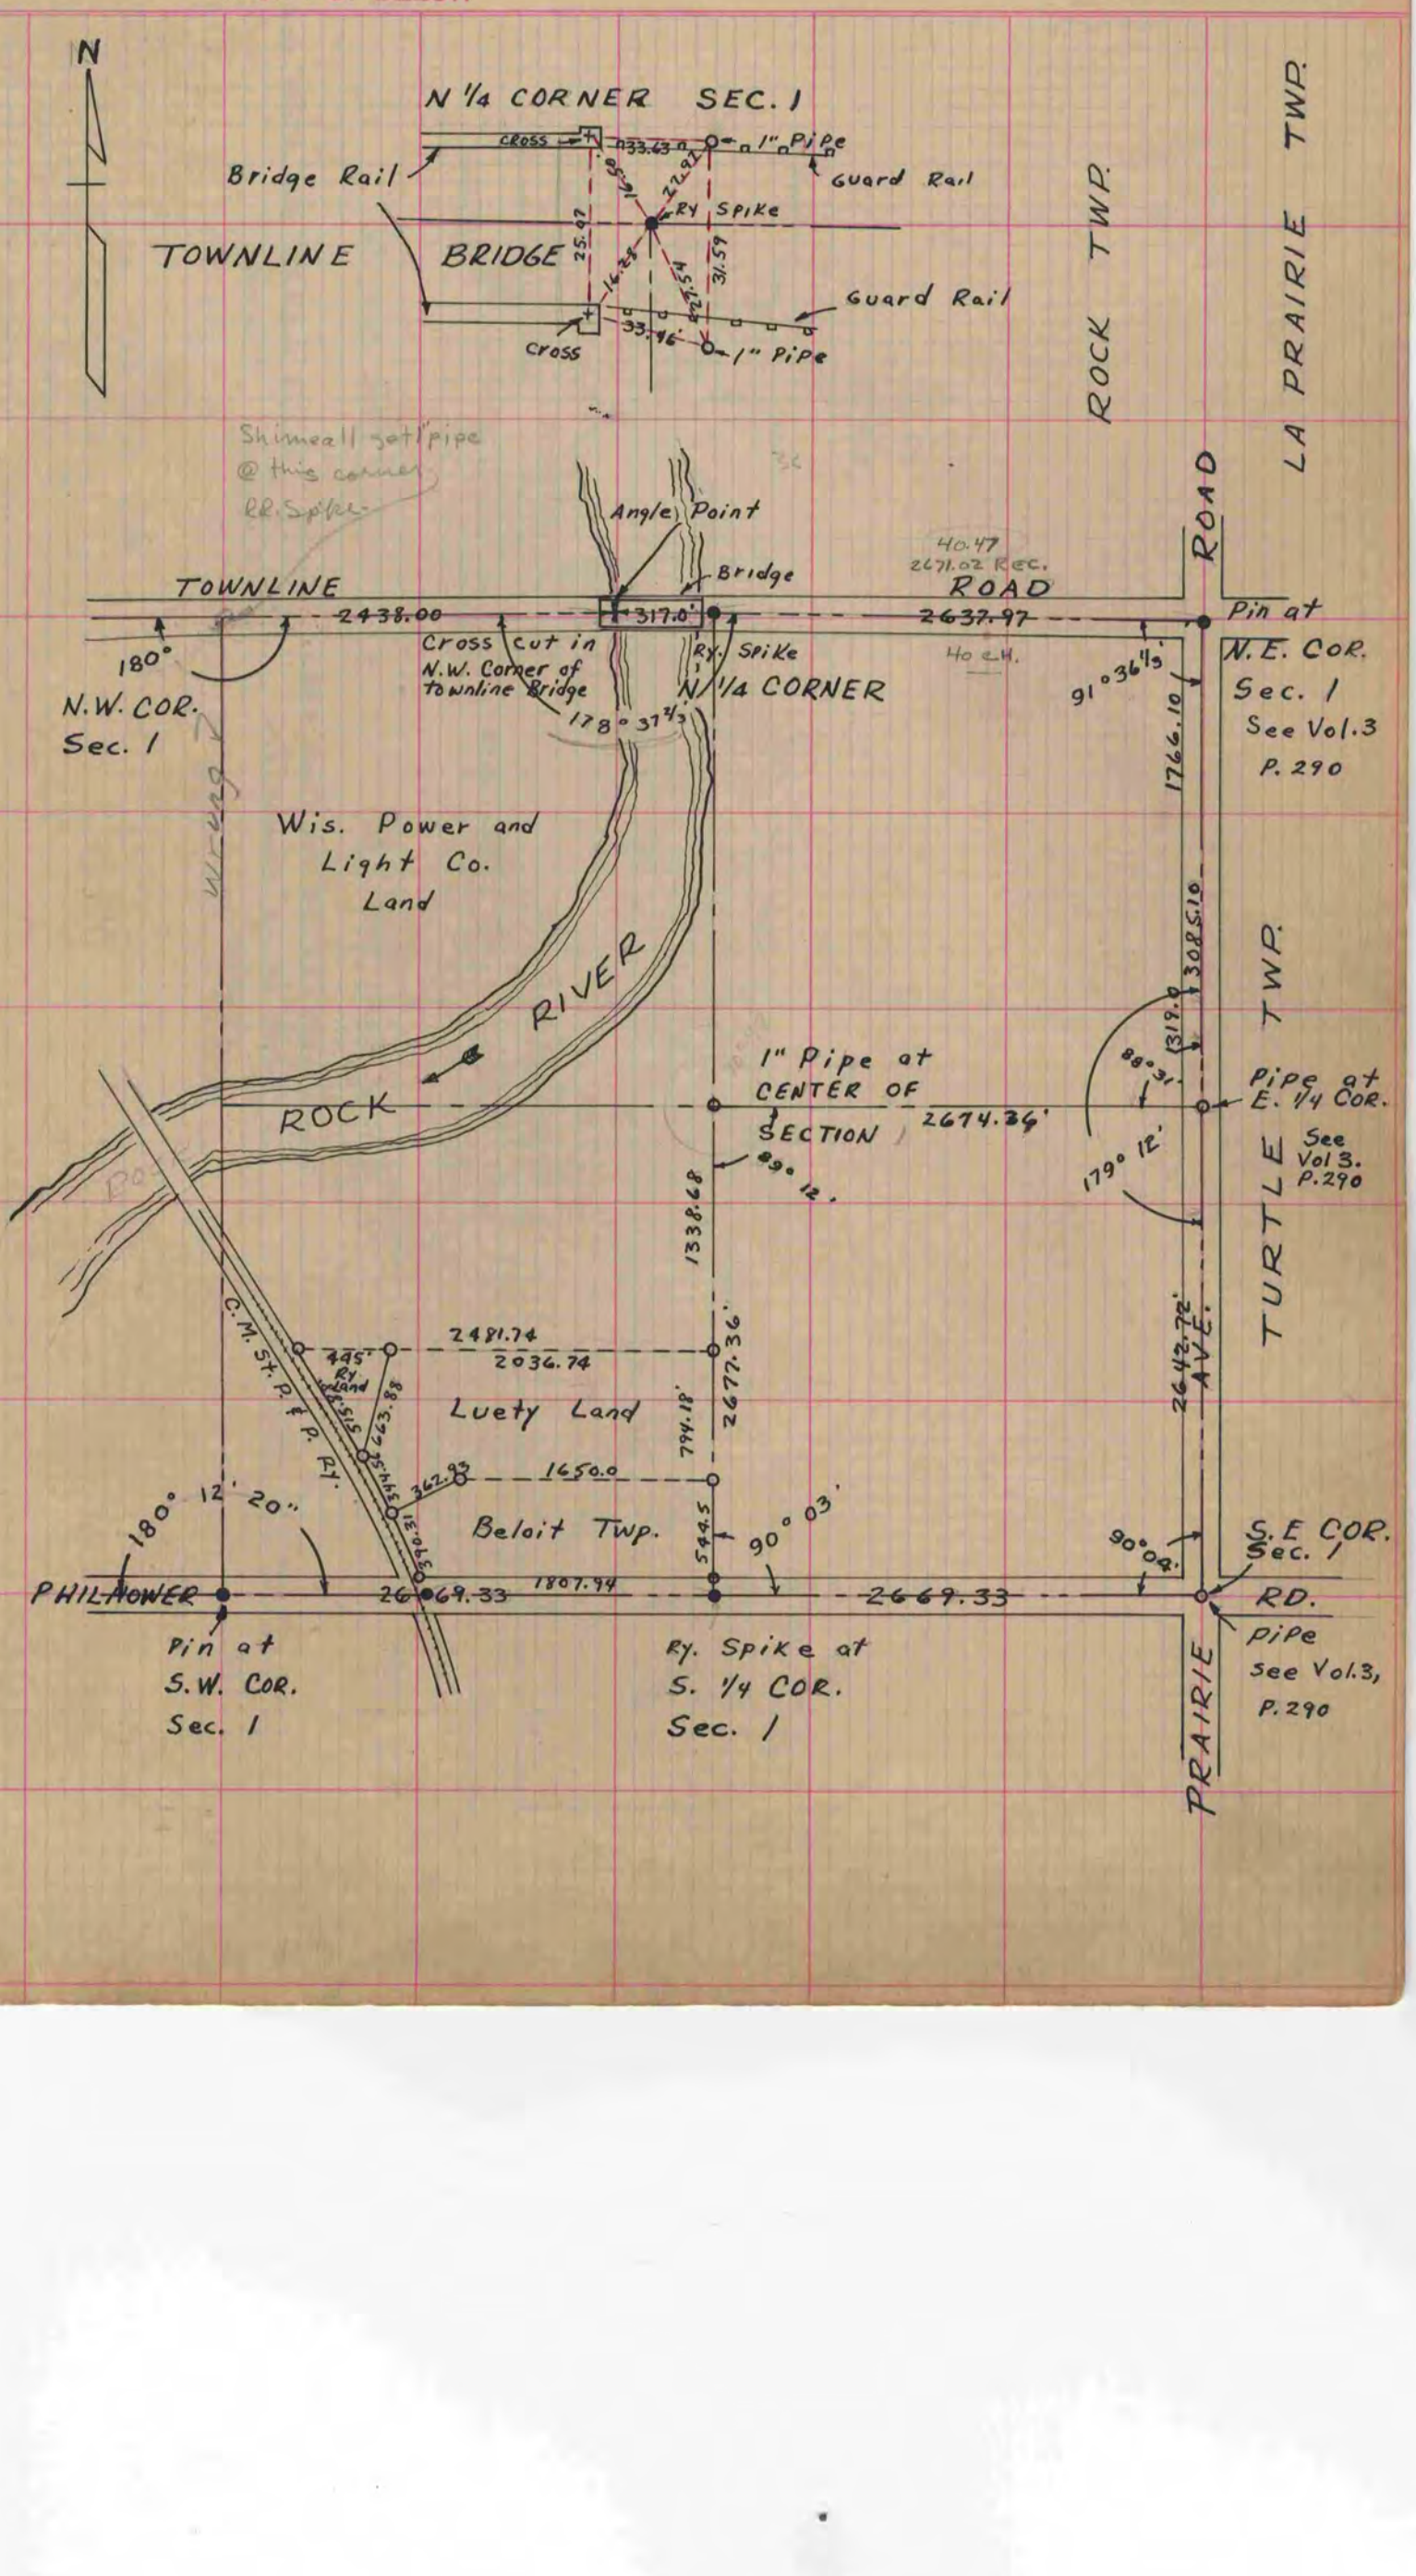
County Surveyor.