572

PLAT AND RECORD

Of a Survey on Section 6 & 7 T 4 N R 13 E. of the 4 P. M. in MILTON Township

Rock County, Wisconsin, made MARCH the 1958

I hereby certify that the following is a correct record of said survey as made by me.

COUNTY BUILDING
IN CITY OF BELOIT
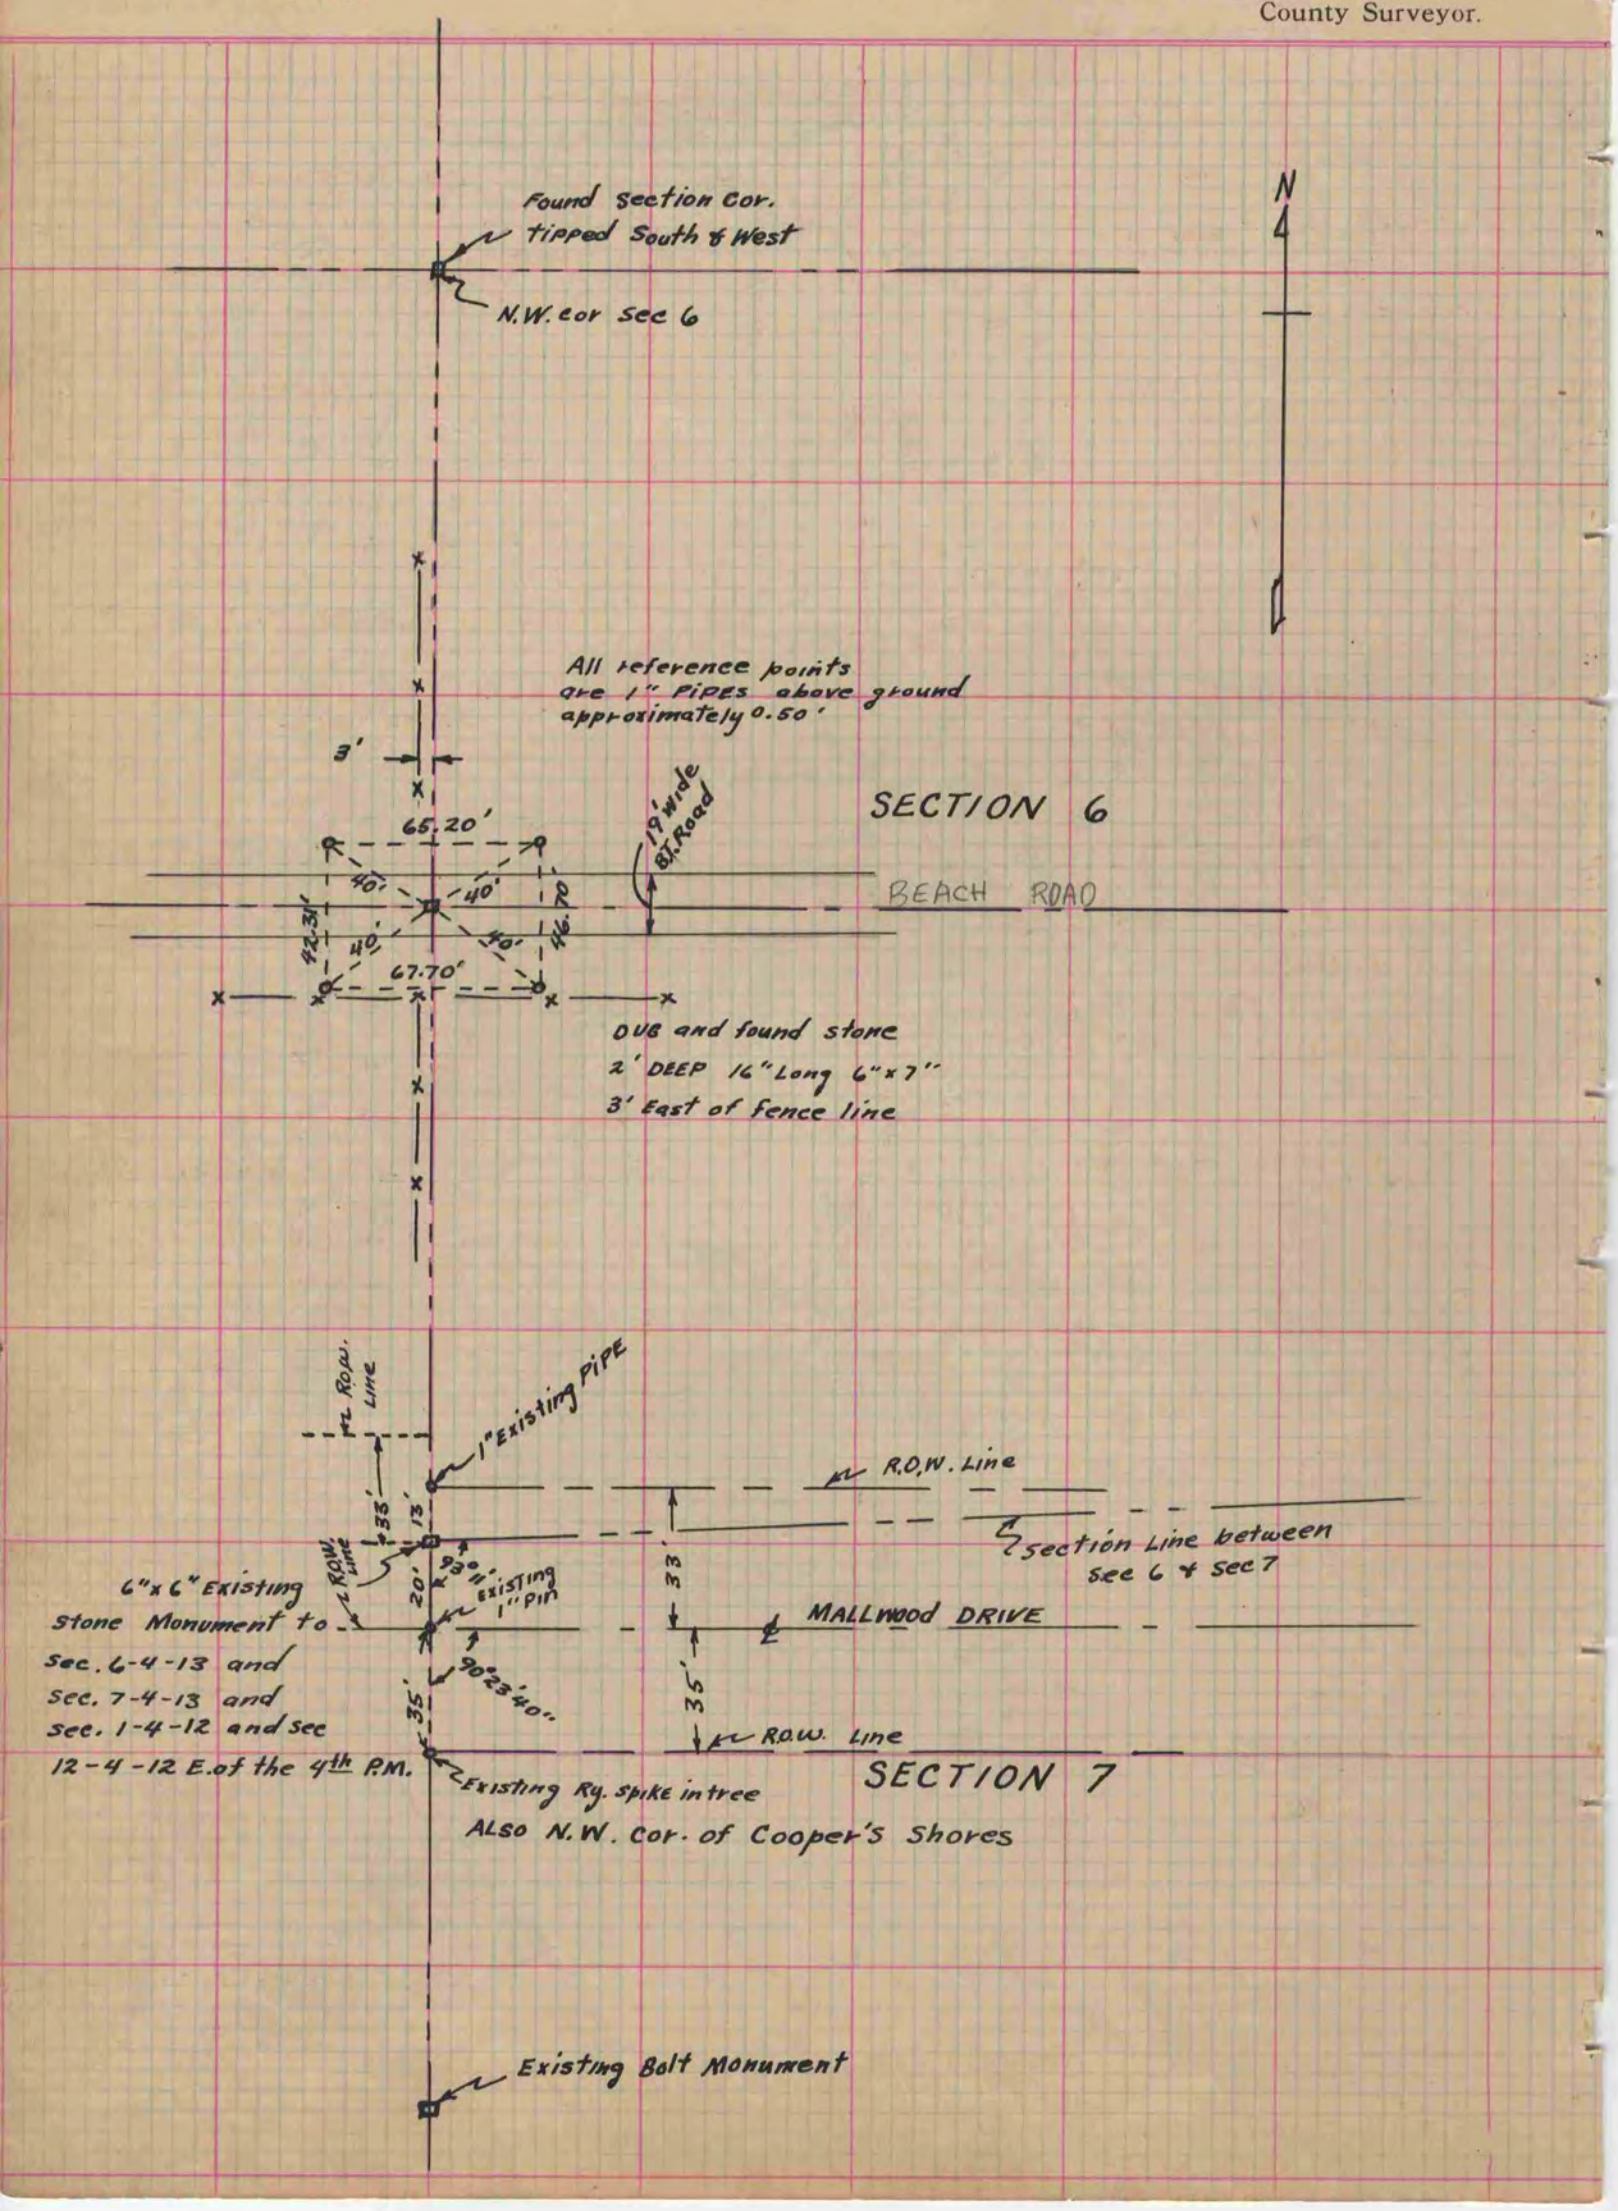
County Surveyor.