COUNTY BUILDING
IN CITY OF BELOIT

PLAT AND RECORD

Of a Survey on Section 1,2 T 4 R 14 E. of the 4 P. M. in LIMA Township

Rock County, Wisconsin, made SEPT. the 1st. 1959

I hereby certify that the following is a correct record of said survey as made by me.

R. H. Batterman Jr.
County Surveyor.
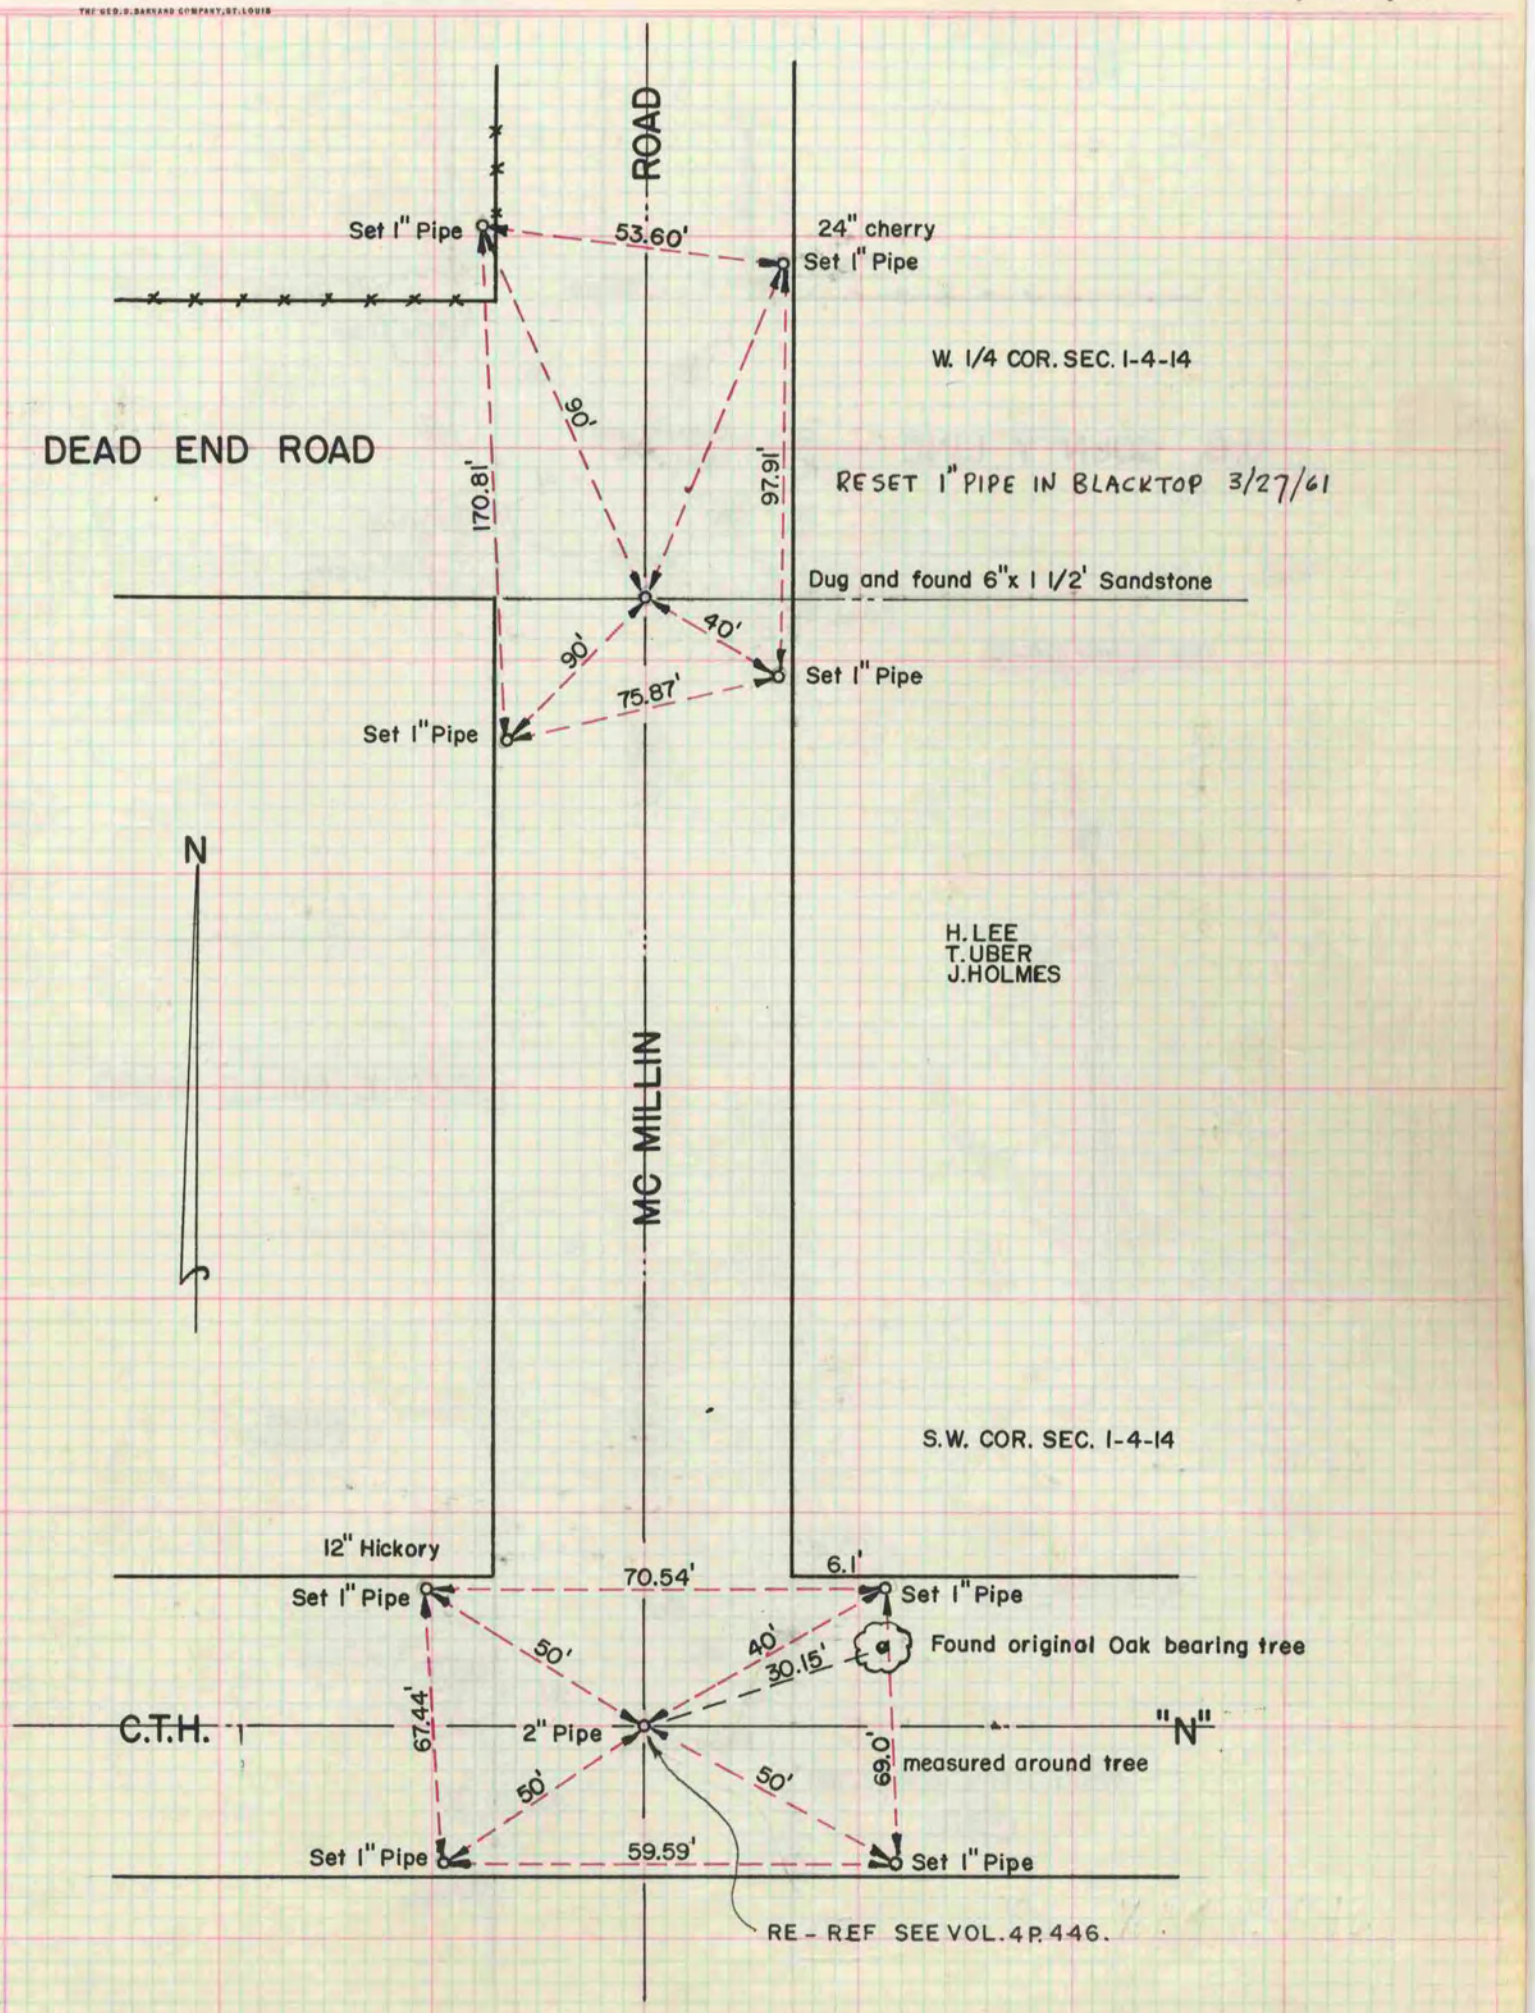
THE GEO. D. BARNARD COMPANY, ST. LOUIS