PLAT AND RECORD

417

PC 427 JANESVILLE
REC 12/16/75 DAB

Lot #1 Croft's Add. to Edgerton, Wis.

Of a Survey on Section 10 (N.W. 1/4) T 4 R 12 E. of the 4 P. M. in Fulton Township

Rock County, Wisconsin, made May 17 to June 30 the 1939

I hereby certify that the following is a correct record of said survey as made by me.

COUNTY BUILDING
I CITY OF BELOIT
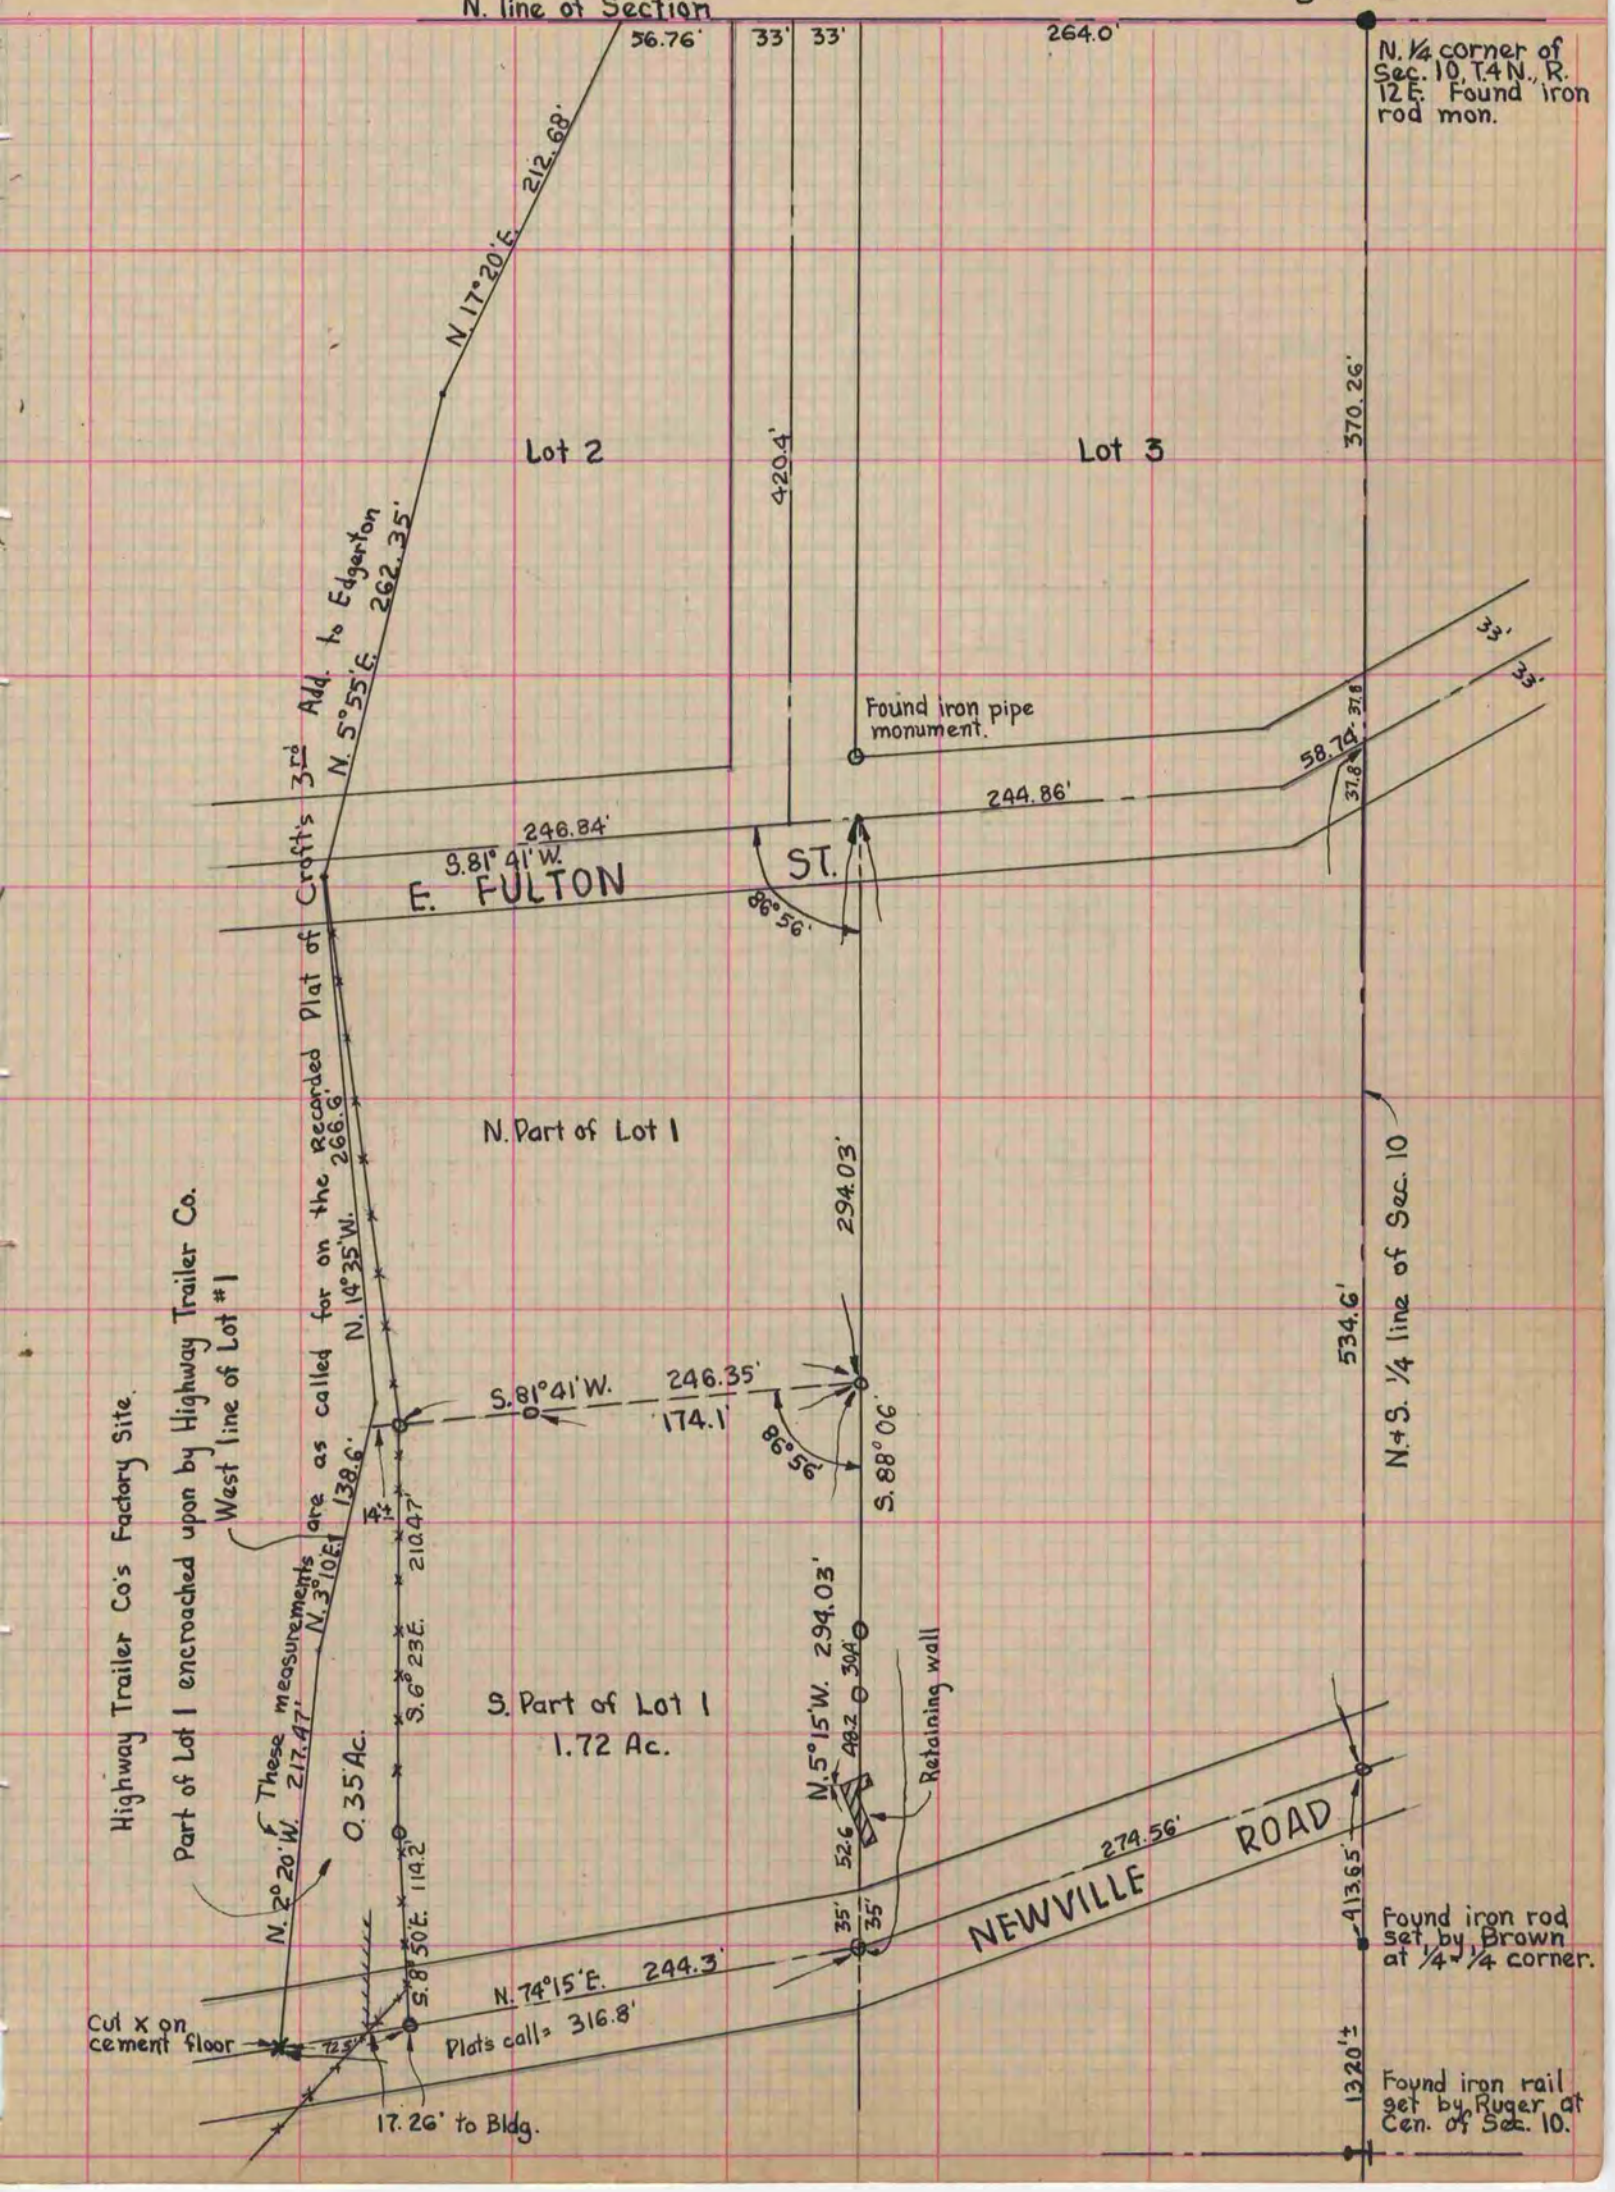
(Signed) B. J. Sunny
County Surveyor.