PLAT AND RECORD

Of a Survey on Section 24 T 3 N R 12 E. of the 4 P. M. in JANESVILLE Township

Rock County, Wisconsin, made October the 24 1958

I hereby certify that the following is a correct record of said survey as made by me.

County Surveyor.
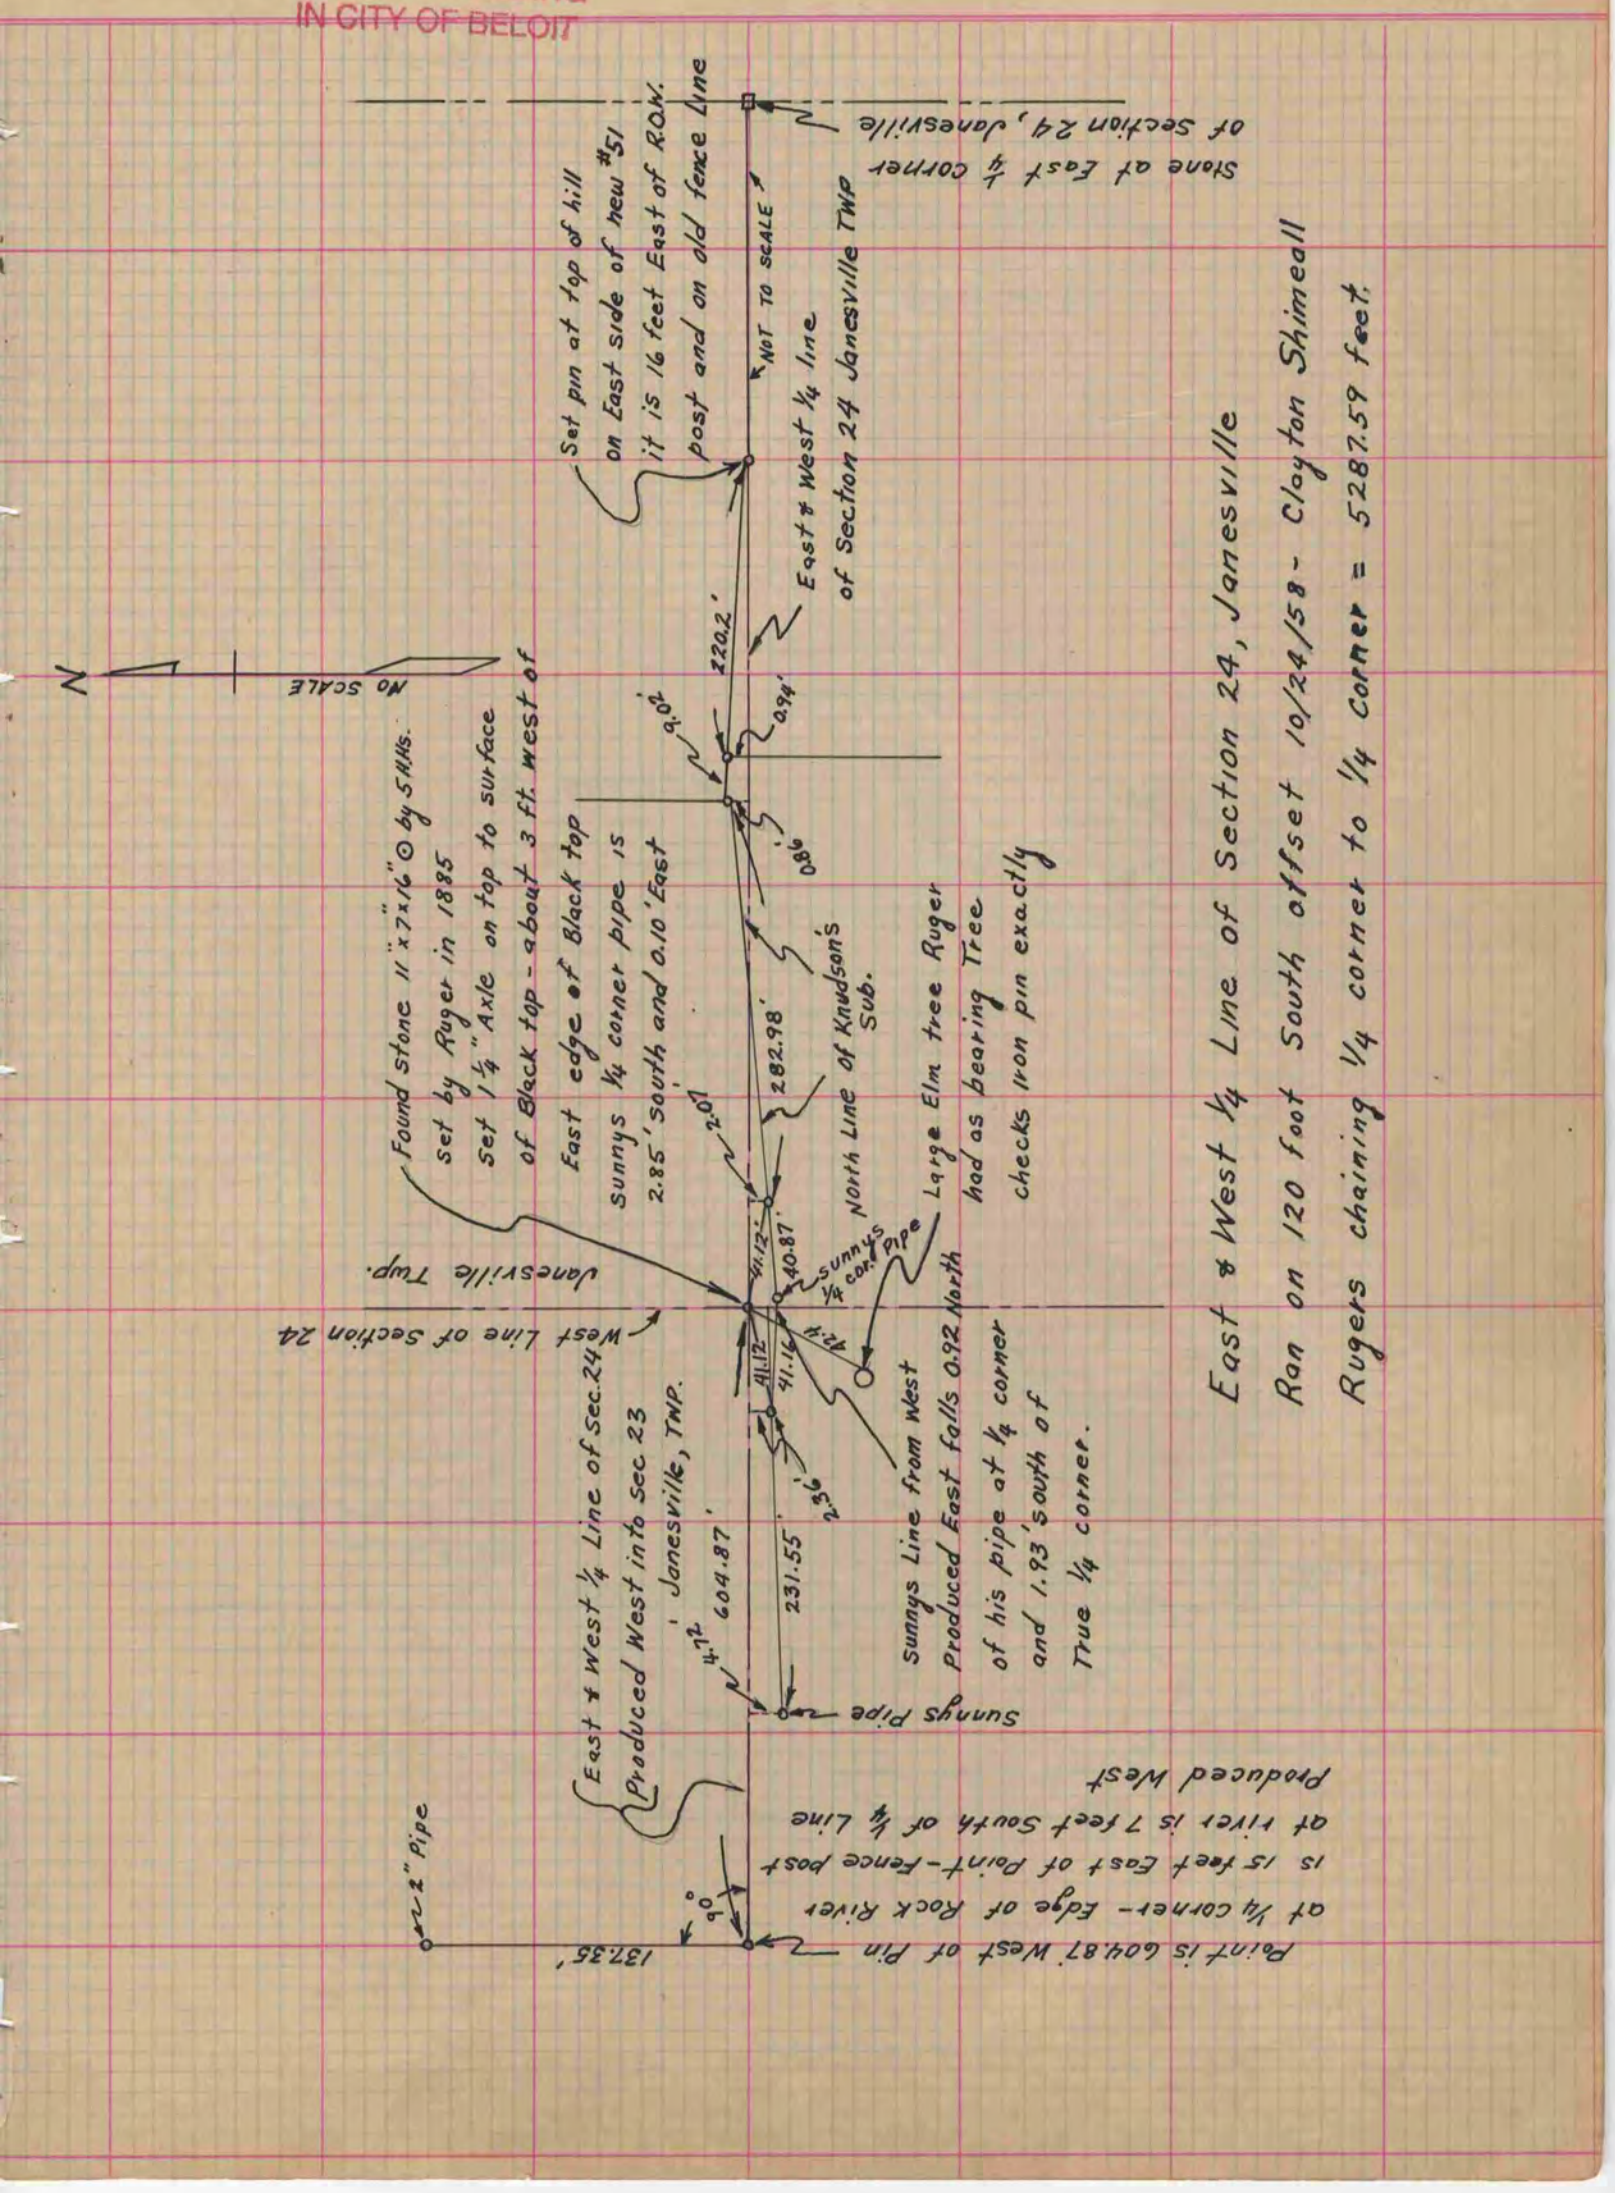
COUNTY BUILDING
IN CITY OF BELOIT