PLAT AND RECORD

207

Of a Survey on Section 11 T 1 R 13 E. of the 4 P. M. in Turtle Township

Rock County, Wisconsin, made May the 19th 1864

I hereby certify that the following is a correct record of said survey as made by me.

COUNTY BUILDING
IN CITY OF BELOIT

(Signed) S. D. Locke
RCHB
County Surveyor.

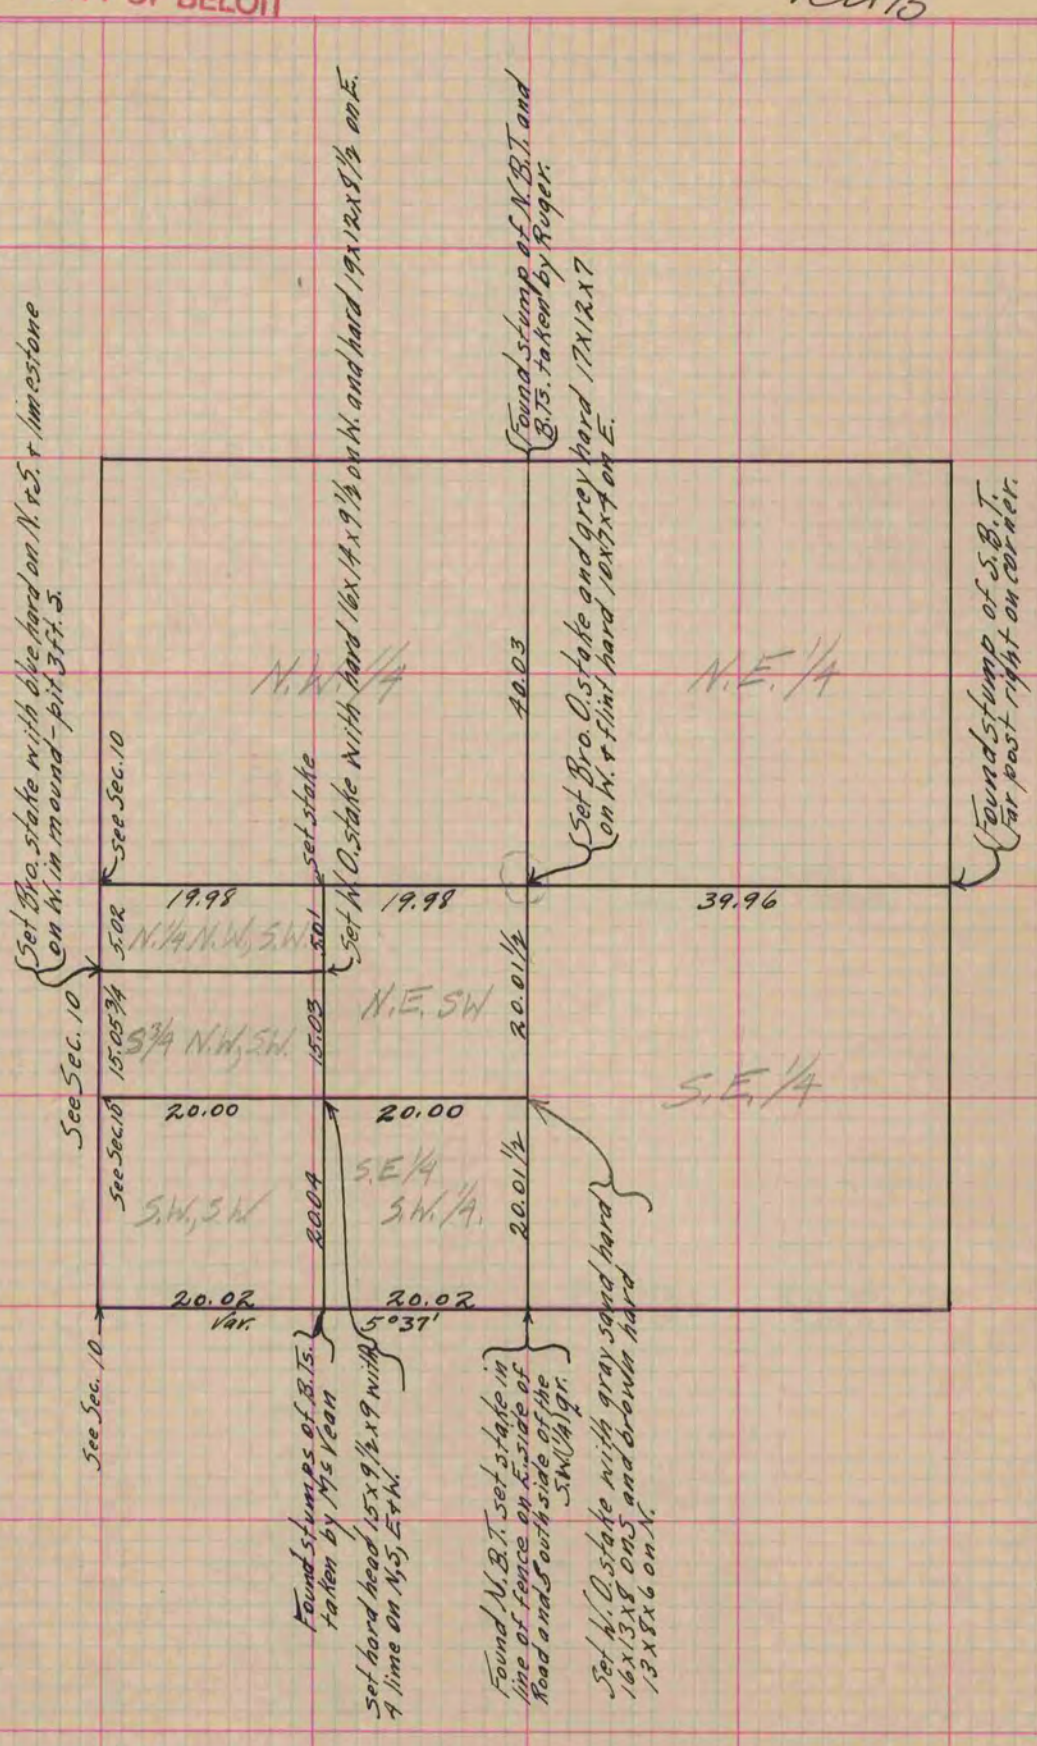

Copied from Upper ½ of Page 204 Vol. 1. Original County Surveyor's Record.