# PLAT AND RECORD

Of a Survey on Section 3 T 3 R 14 E. of the 4 P. M. in Johnstown Township

Rock County, Wisconsin, made May the 30 & 31 1864

I hereby certify that the following is a correct record of said survey as made by me.

(Signed) S. D. Locke
RHB
County Surveyor.

COUNTY BUILDING
IN CITY OF BELOIT

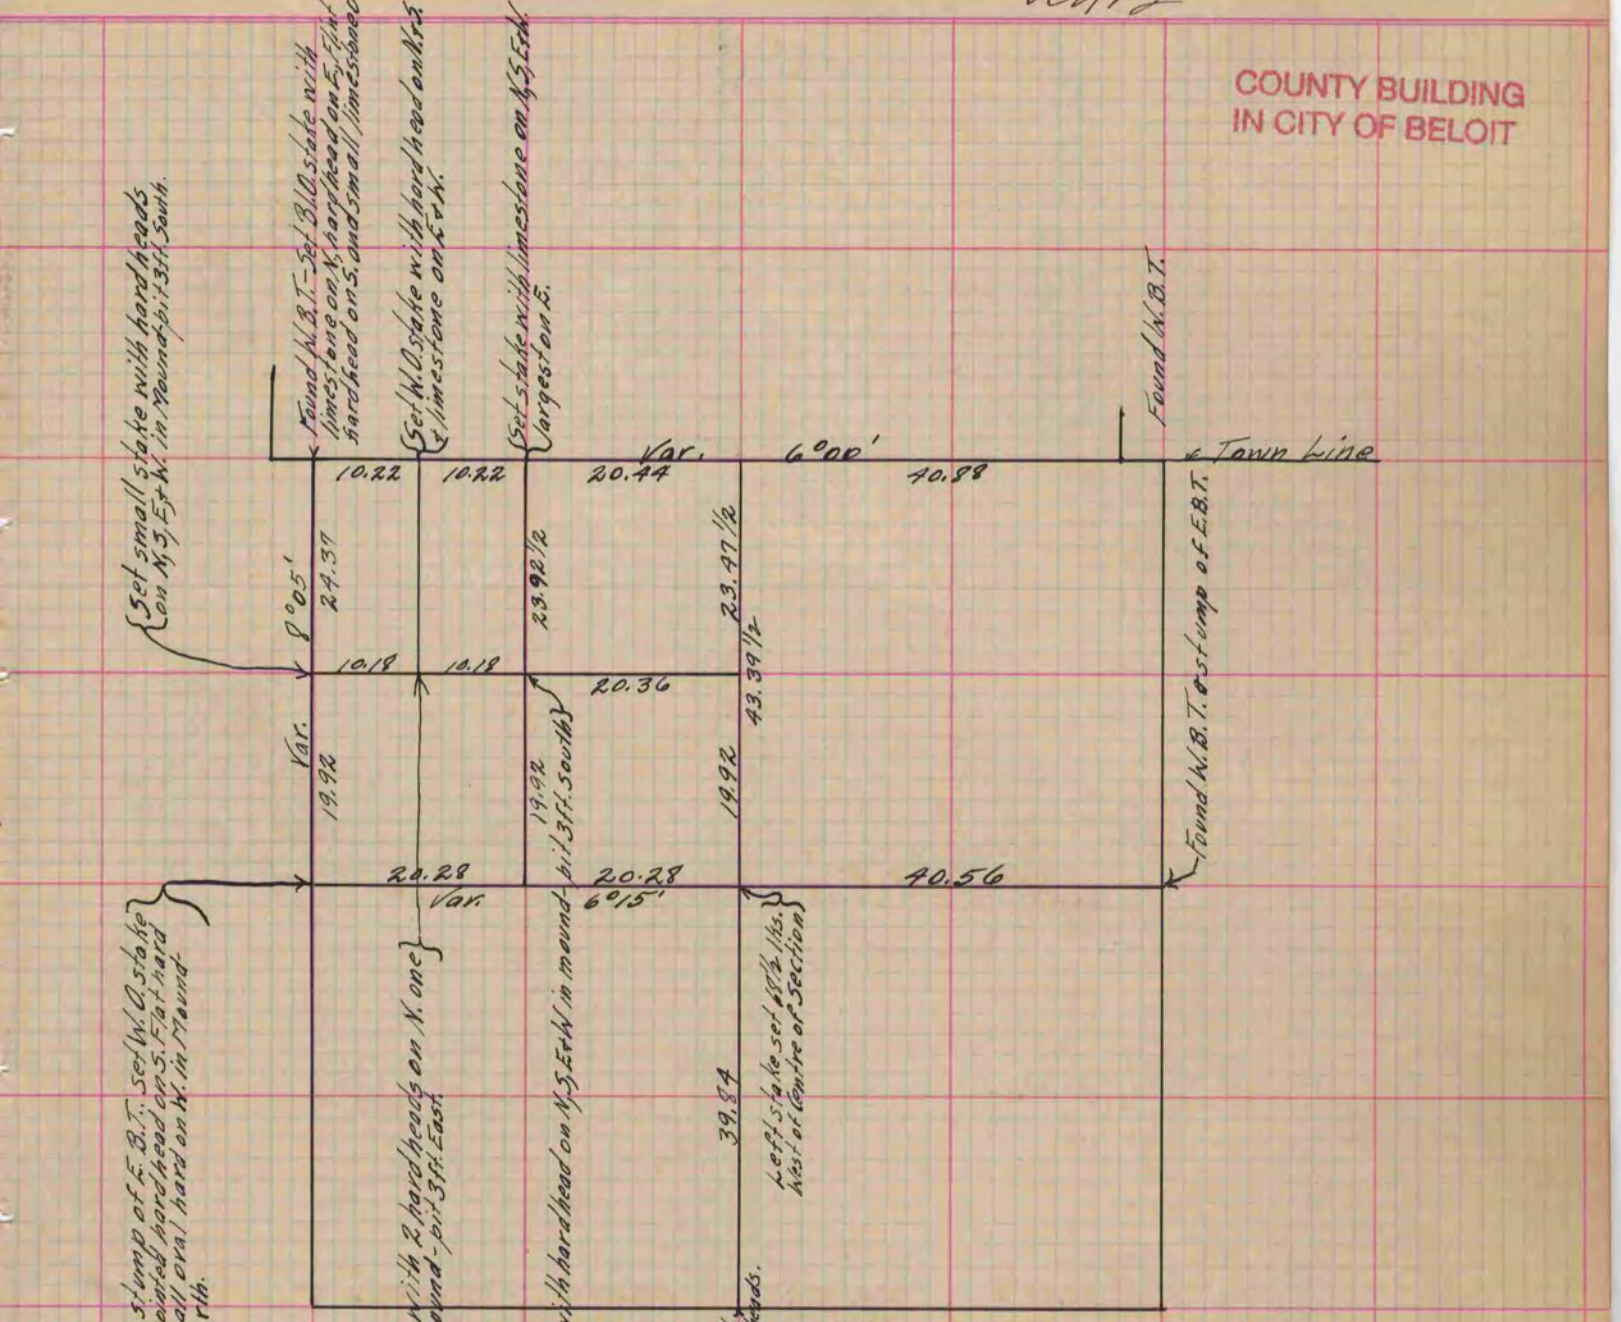


Copied from Page 205 (Upper half) Vol. 1. Original County Surveyors Record.