PLAT AND RECORD

Of a Survey on Section 14 T 2 R 12 E. of the 4 P. M. in Rock Township

Rock County, Wisconsin, made September the 9th 1867

I hereby certify that the following is a correct record of said survey as made by me.

COUNTY BUILDING
IN CITY OF BELOIT

(Signed) S.D. Locke
RMB
County Surveyor.

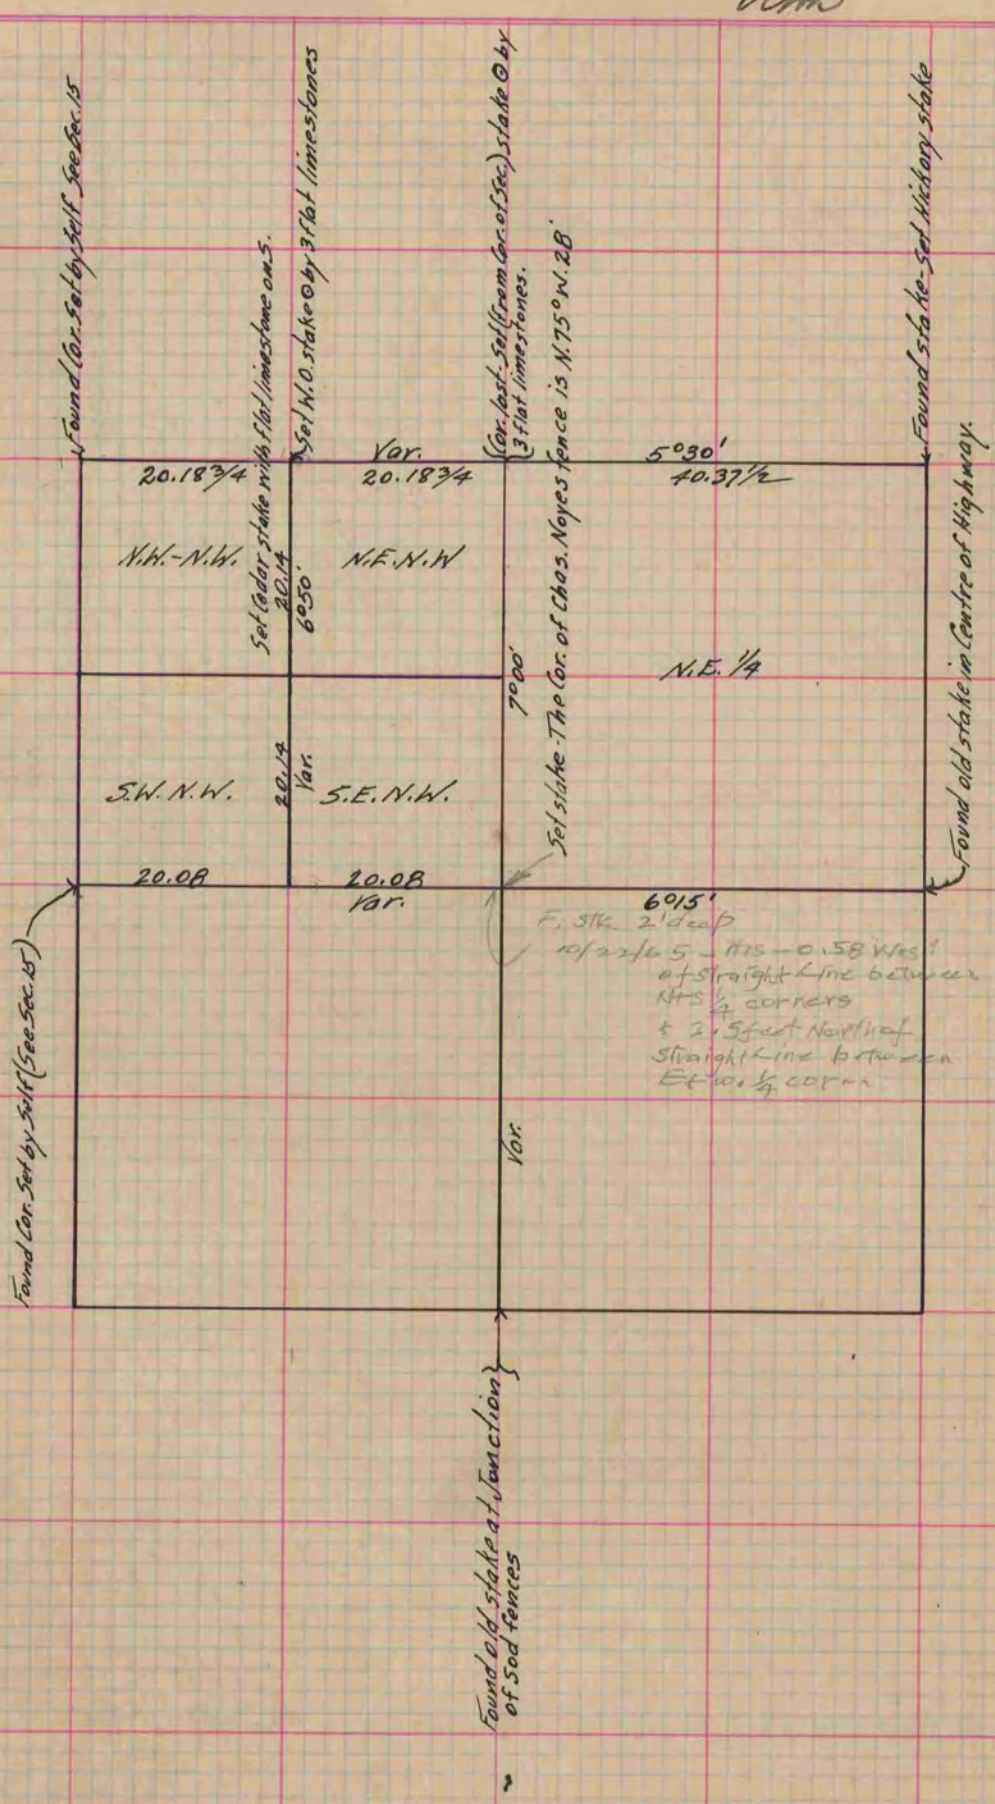

Copied from Page 249 Vol. 1. Original County Surveyor's Record.