PLAT AND RECORD

219

PG 225 JANESVILLE
REC 12/15/75
DAB

Of a Survey on ~~Section~~ N.E.¼ Section 9 T 4 N. R 12 E. of the 4 P. M. in FULTON Township

Rock County, Wisconsin, made May the 11 1933.

I hereby certify that the following is a correct record of said survey as made by me.

COUNTY BUILDING
IN CITY OF BELOIT
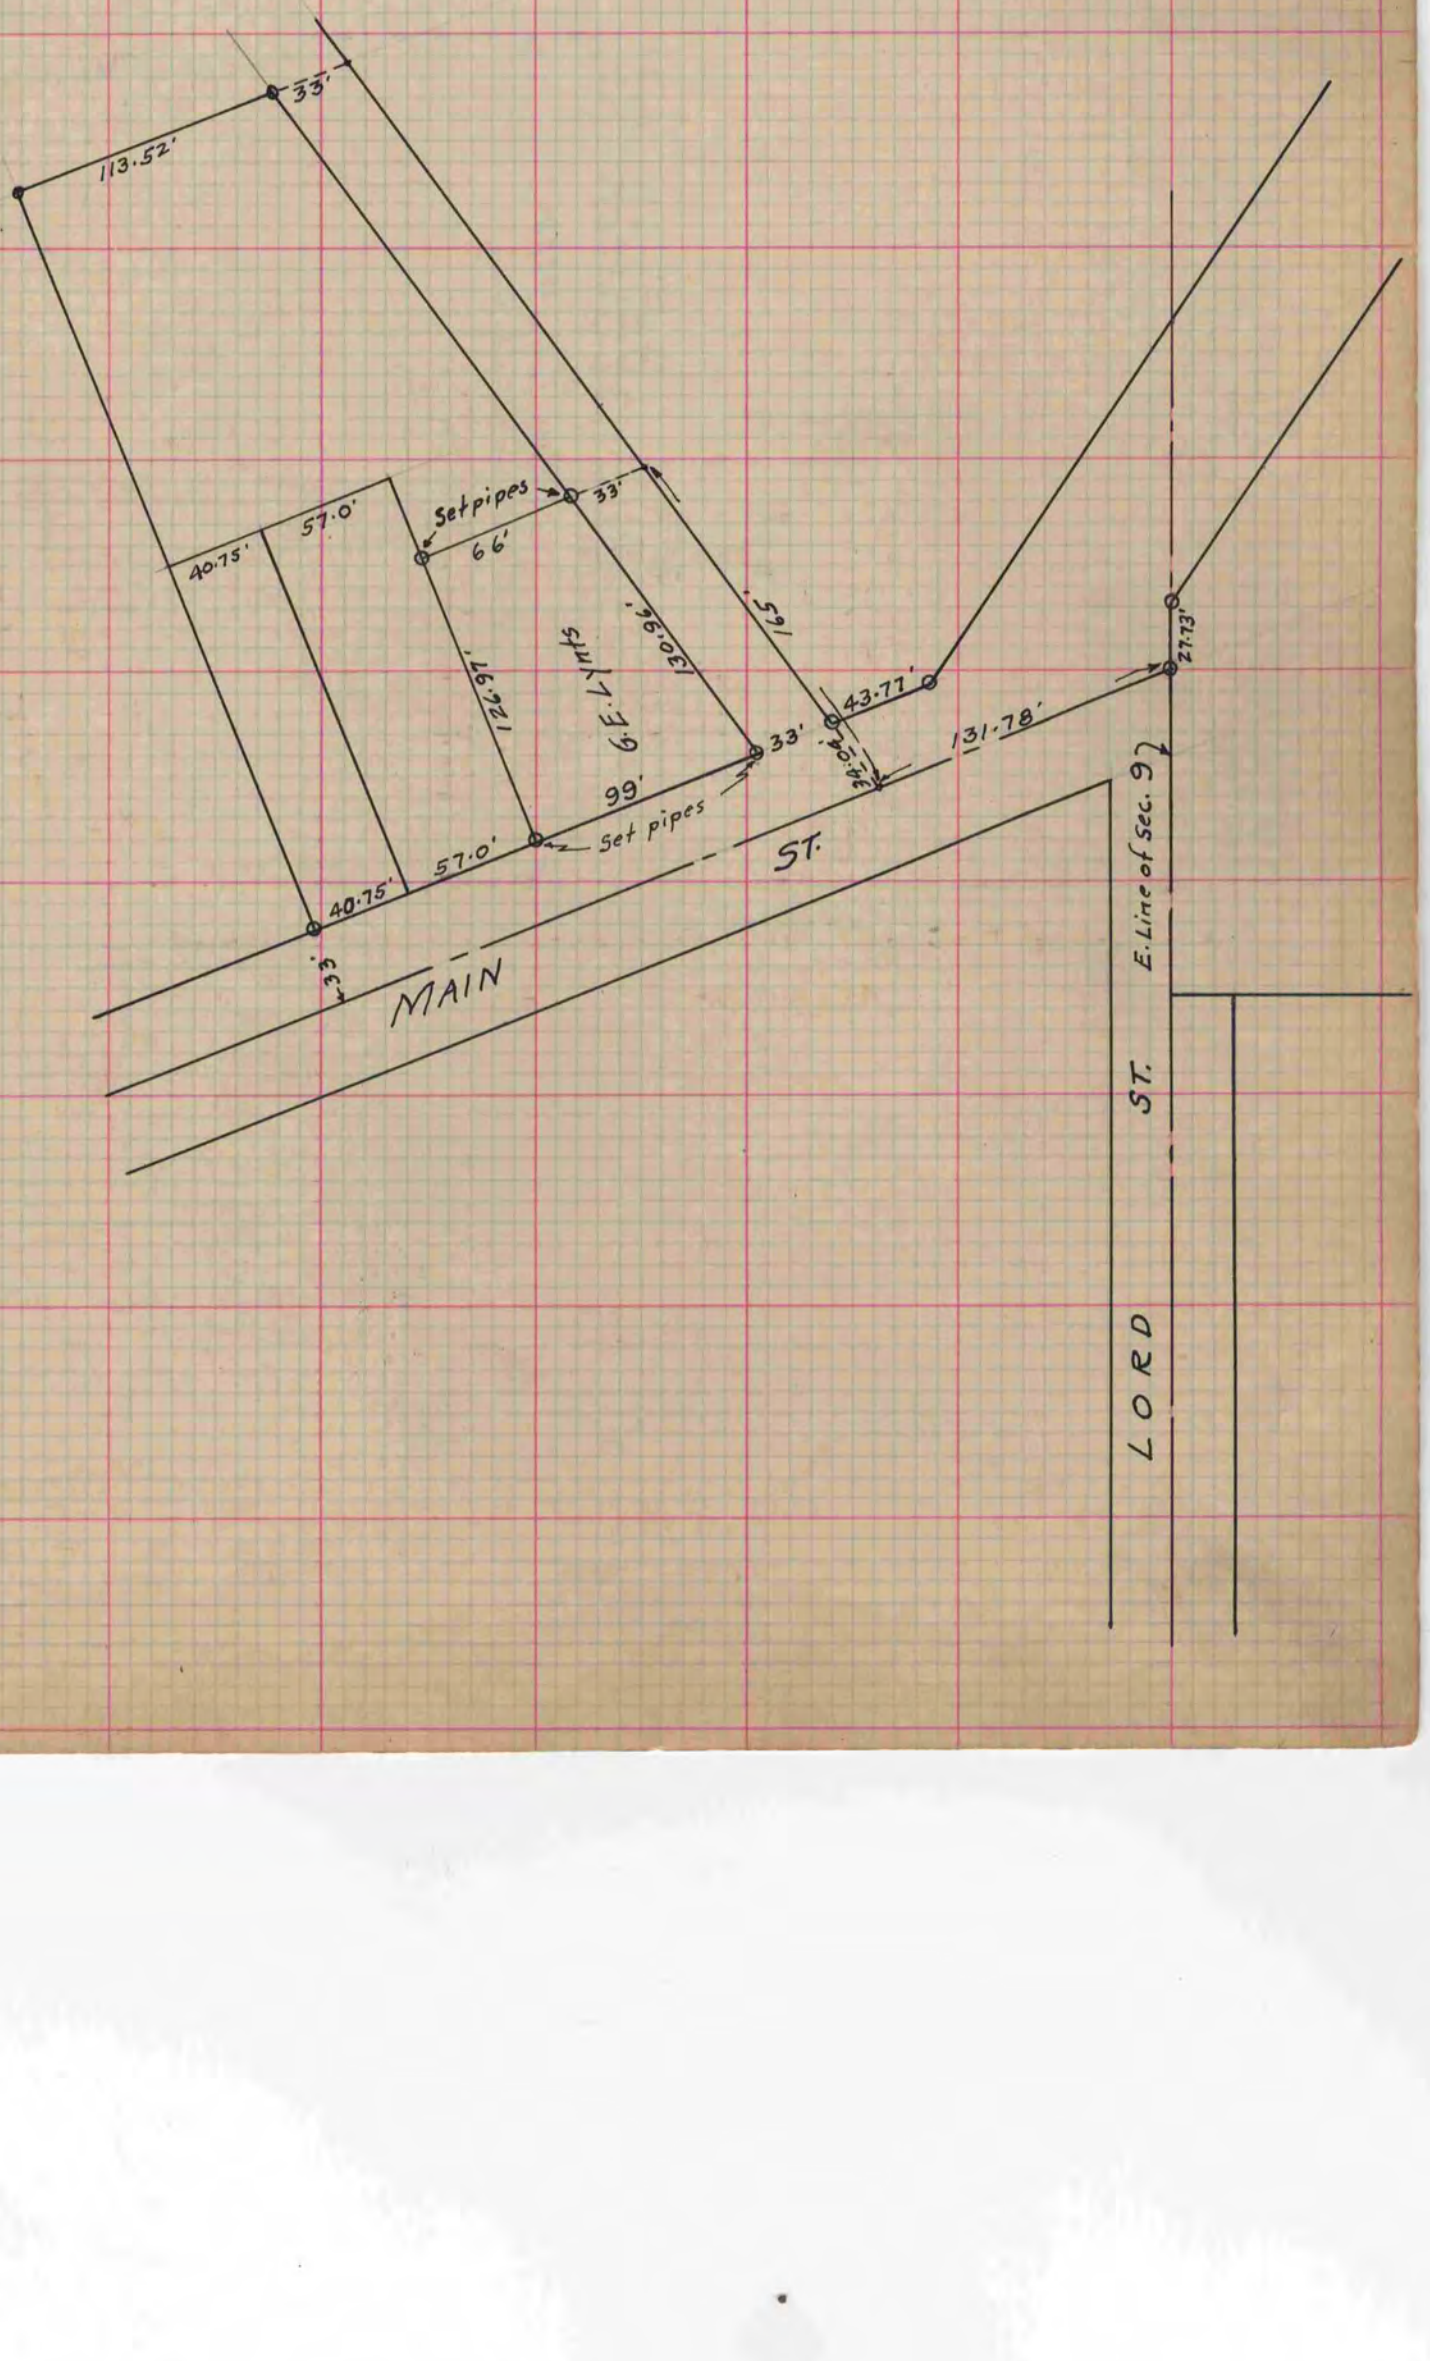
B. J. Sweeney
County Surveyor.