148

PLAT AND RECORD

Of a Survey on Section S.E.¼ 36 T 1 R 12 E. of the 4 P. M. in Beloit Township

Rock County, Wisconsin, made July the 21, 22 & 24 1874

I hereby certify that the following is a correct record of said survey as made by me.

(Signed) Edmund Ruger
R.R.B.
County Surveyor.

COUNTY BUILDING
IN CITY OF BELOIT

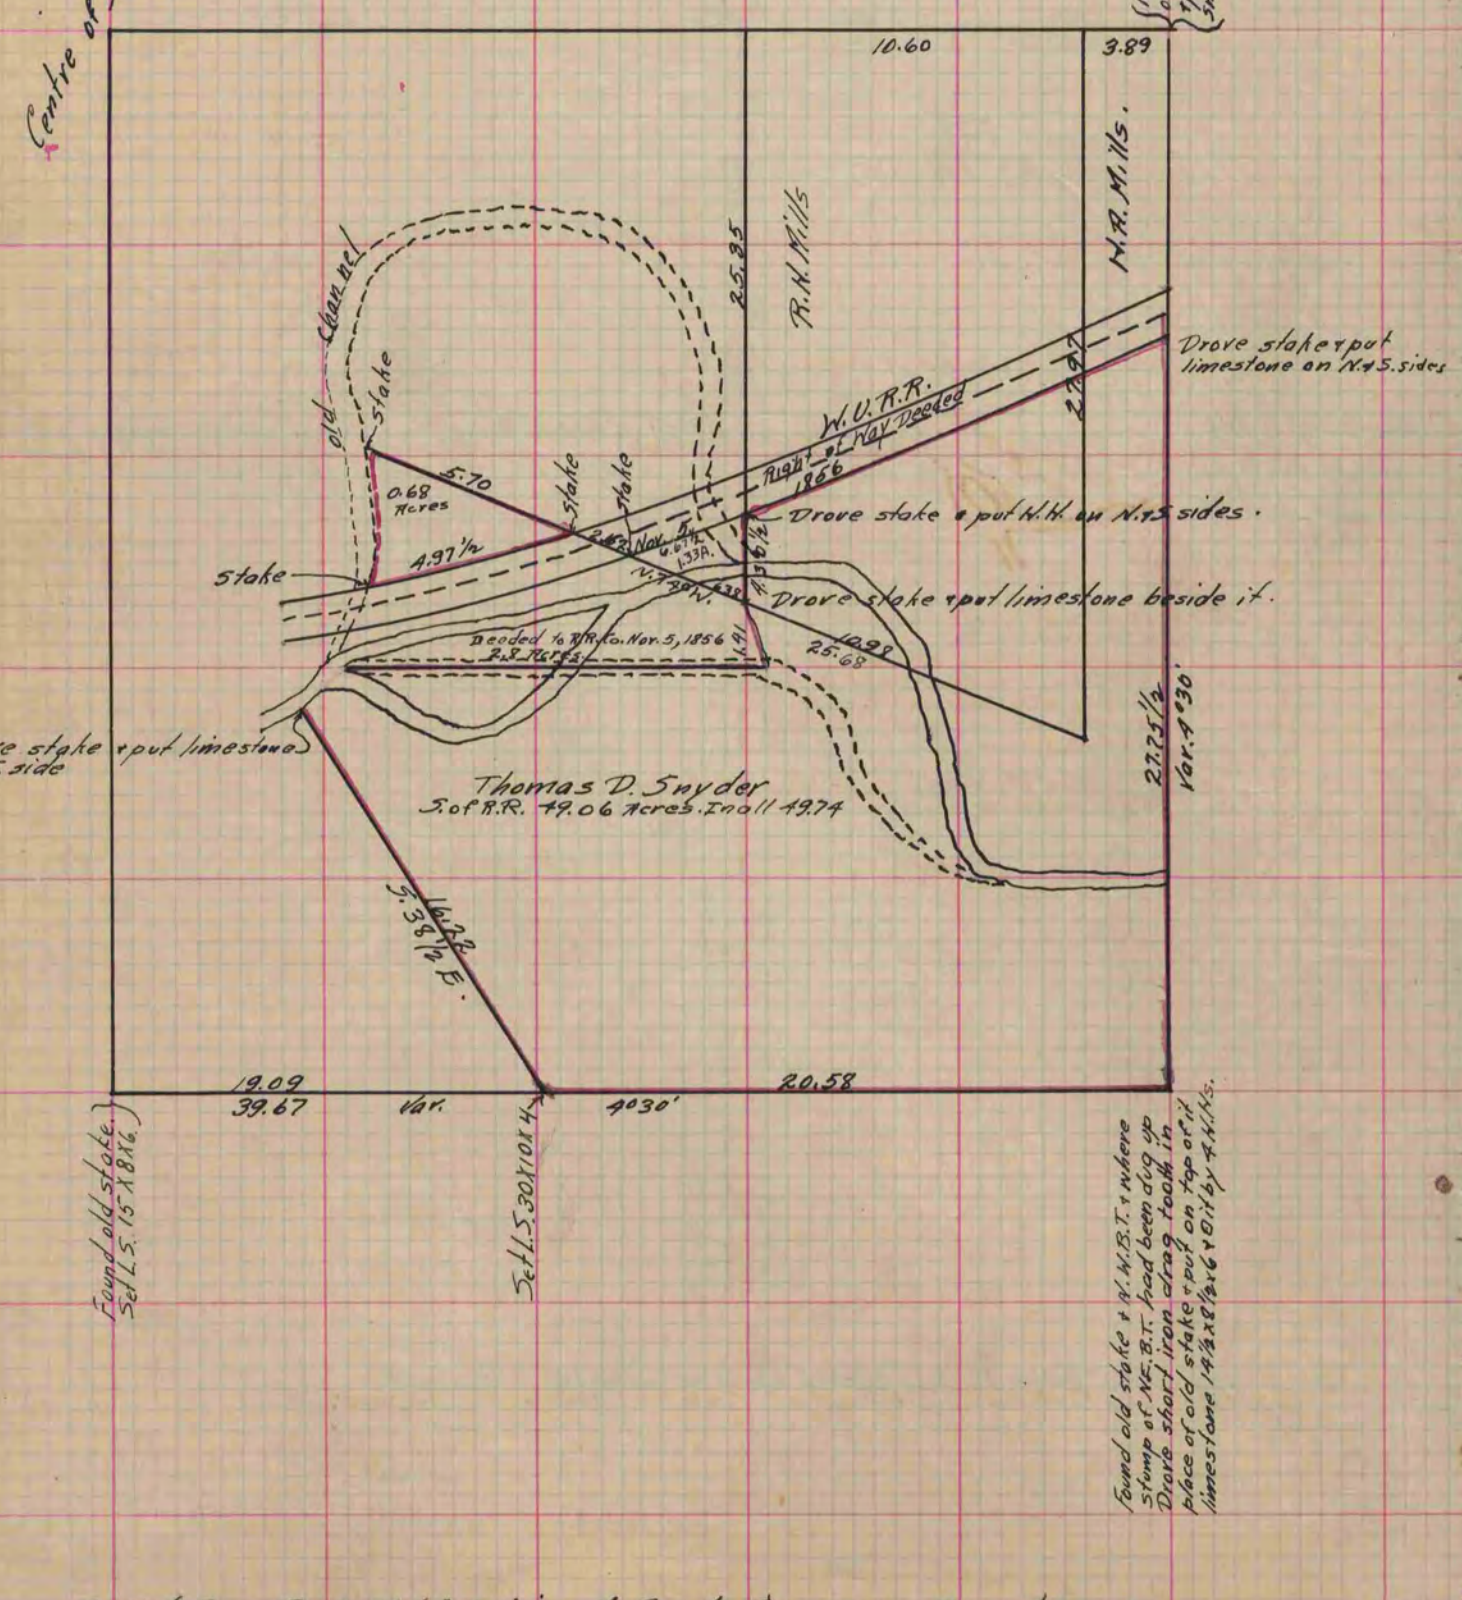

Copied from P105 Vol. 2 original County Surveyors Record.