42

PLAT AND RECORD

Of a Survey on Section 19 T 1 R 11 E. of the 4 P. M. in Newark Township

Rock County, Wisconsin, made November the 21, 22 + 23 1870

COUNTY BUILDING
IN CITY OF BELOIT

I hereby certify that the following is a correct record of said survey as made by me.

(Signed) Edward Ruger R.H.B. Deputy County Surveyor.

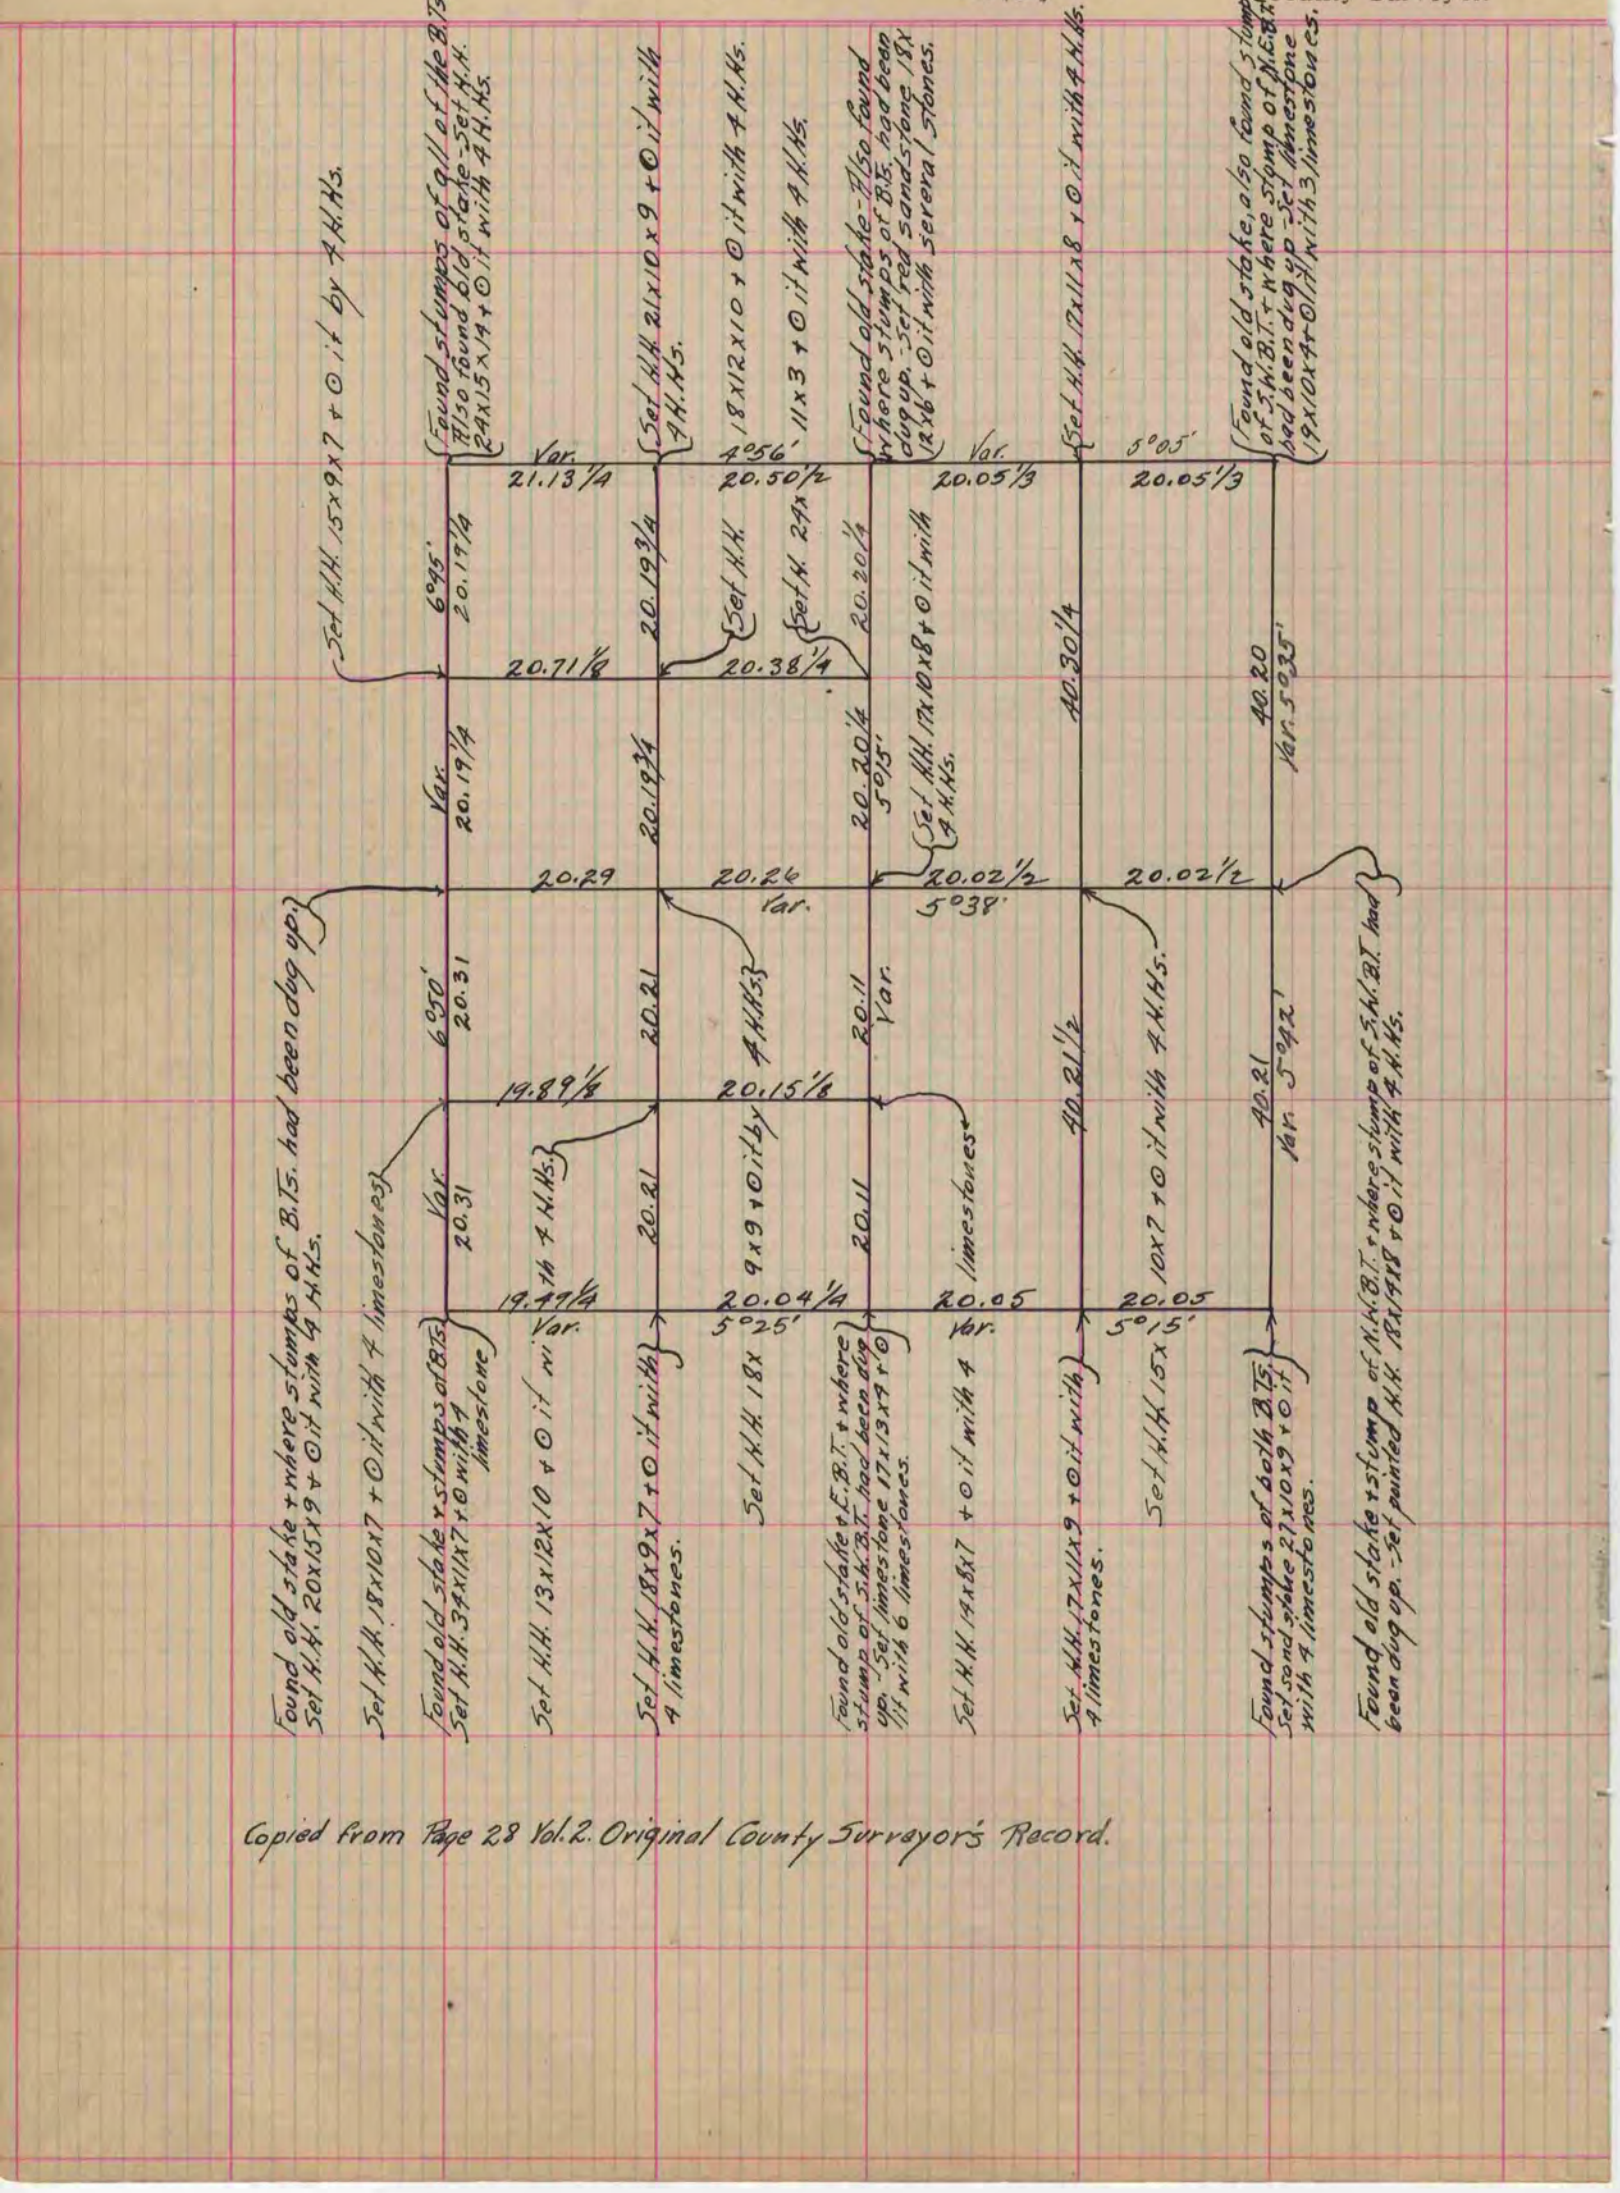

Copied from Page 28 Vol. 2. Original County Surveyor's Record.