PLAT AND RECORD

Of a Survey on Section 3 T 3 R 14 E. of the 4 P. M. in Johnstown Township

Rock County, Wisconsin, made December the 26+27 1870

I hereby certify that the following is a correct record of said survey as made by me.

COUNTY BUILDING
IN CITY OF BELOIT

(Signed) Edward Ruger R.W.B. {Deputy County Surveyor.

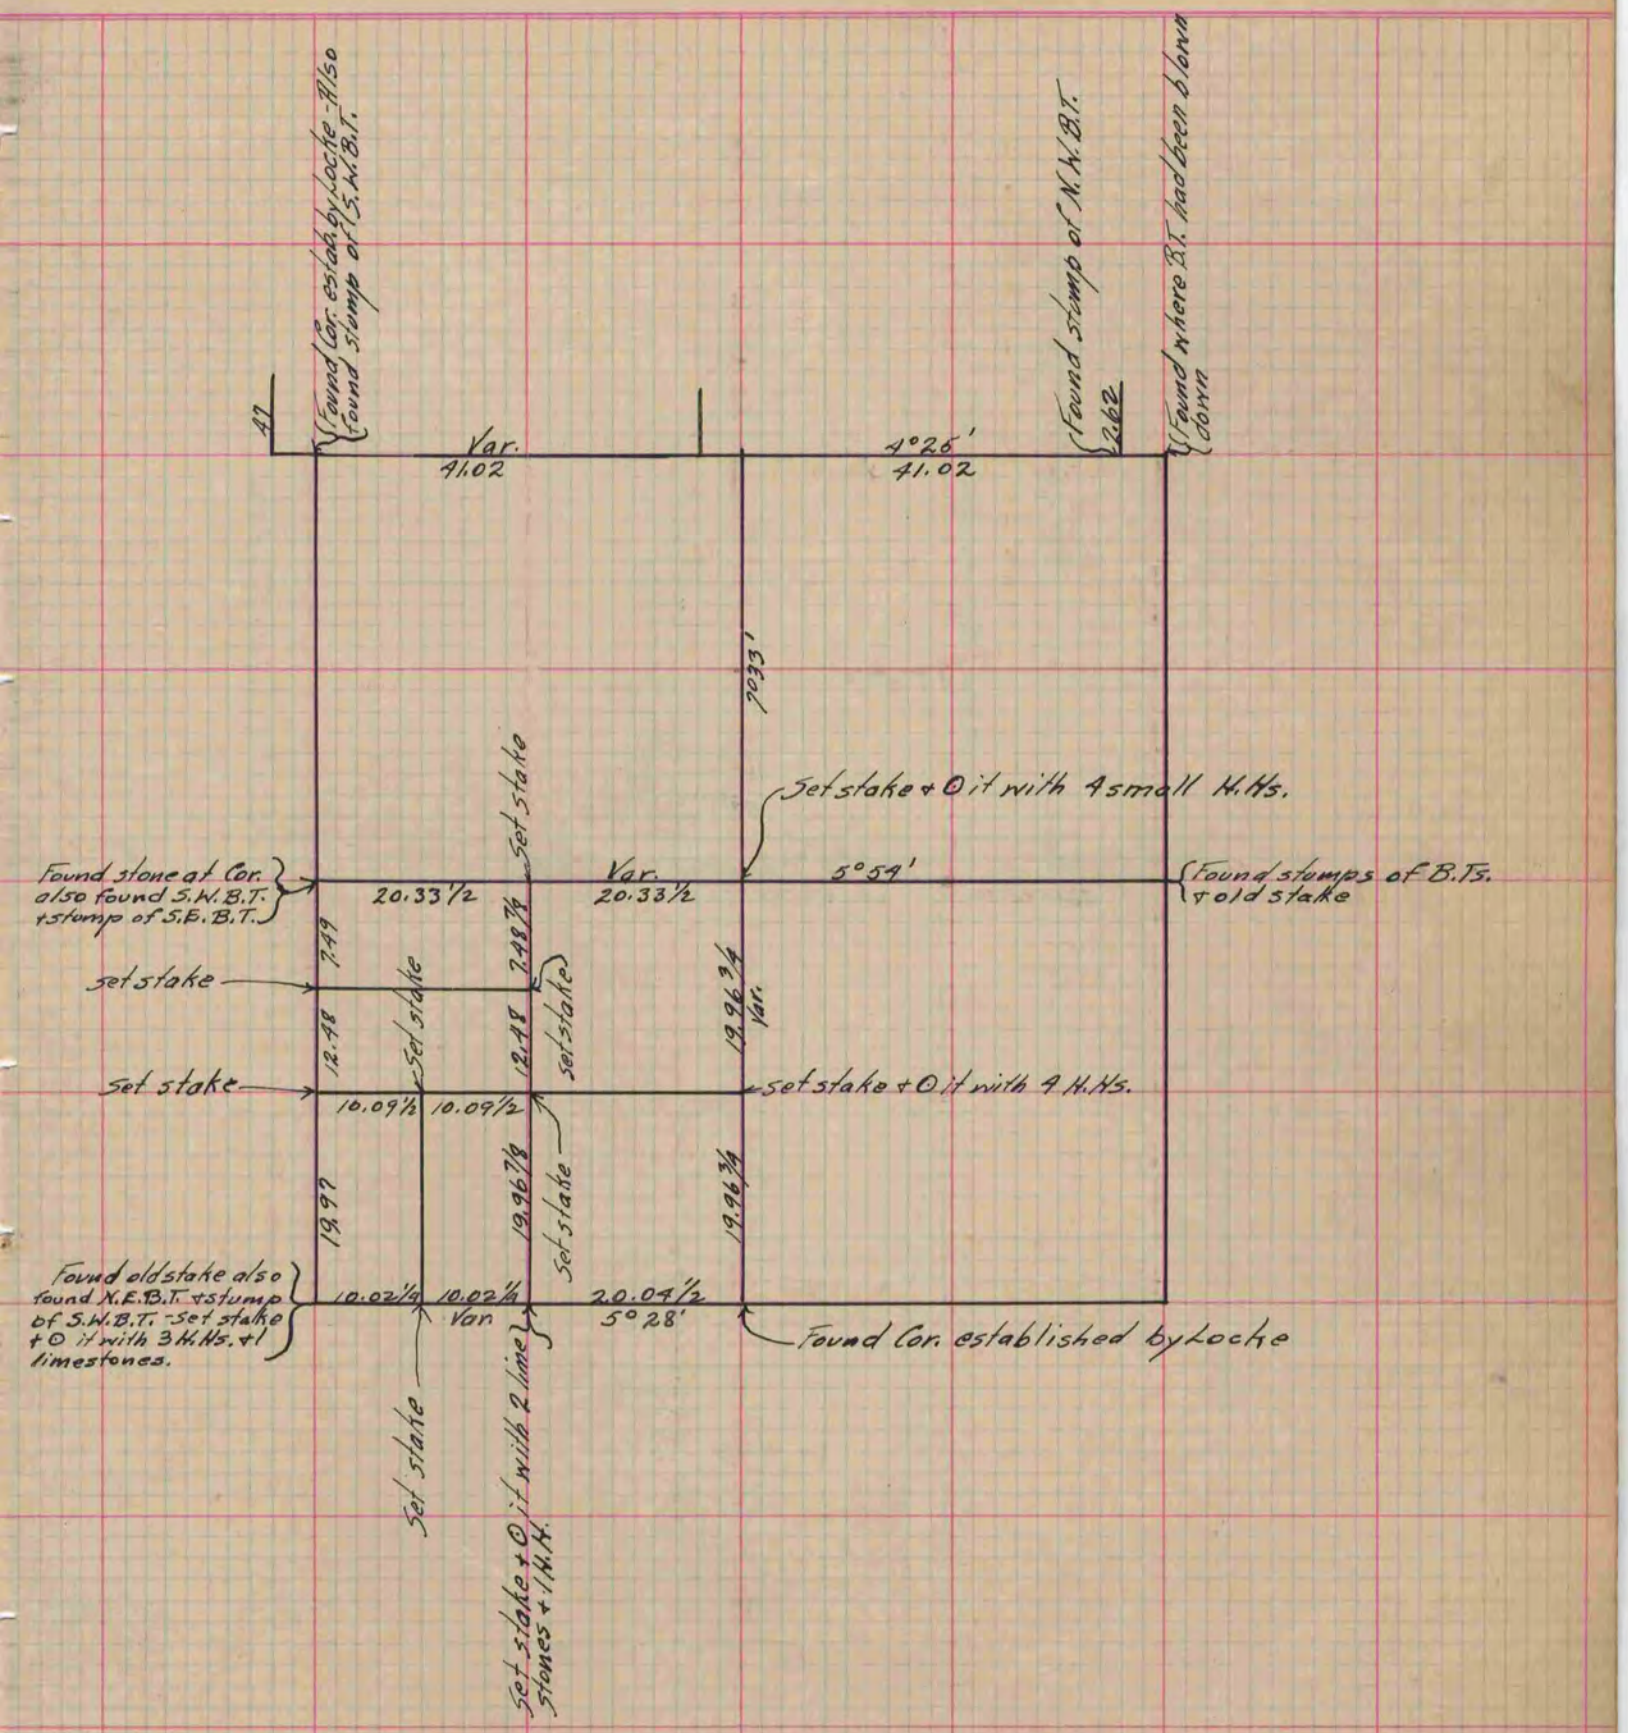

Copied from Page 33 Vol. 2 Original County Surveyor's Records.