192

PLAT AND RECORD

Of a Survey on Section 9 T 3 R 10 E. of the 4 P. M. in Magnolia Township

Rock County, Wisconsin, made June the 7-8 & 9 1875

I hereby certify that the following is a correct record of said survey as made by me.

COUNTY BUILDING
IN CITY OF BELOIT

(Signed) Edward Ruger
RMB
County Surveyor.

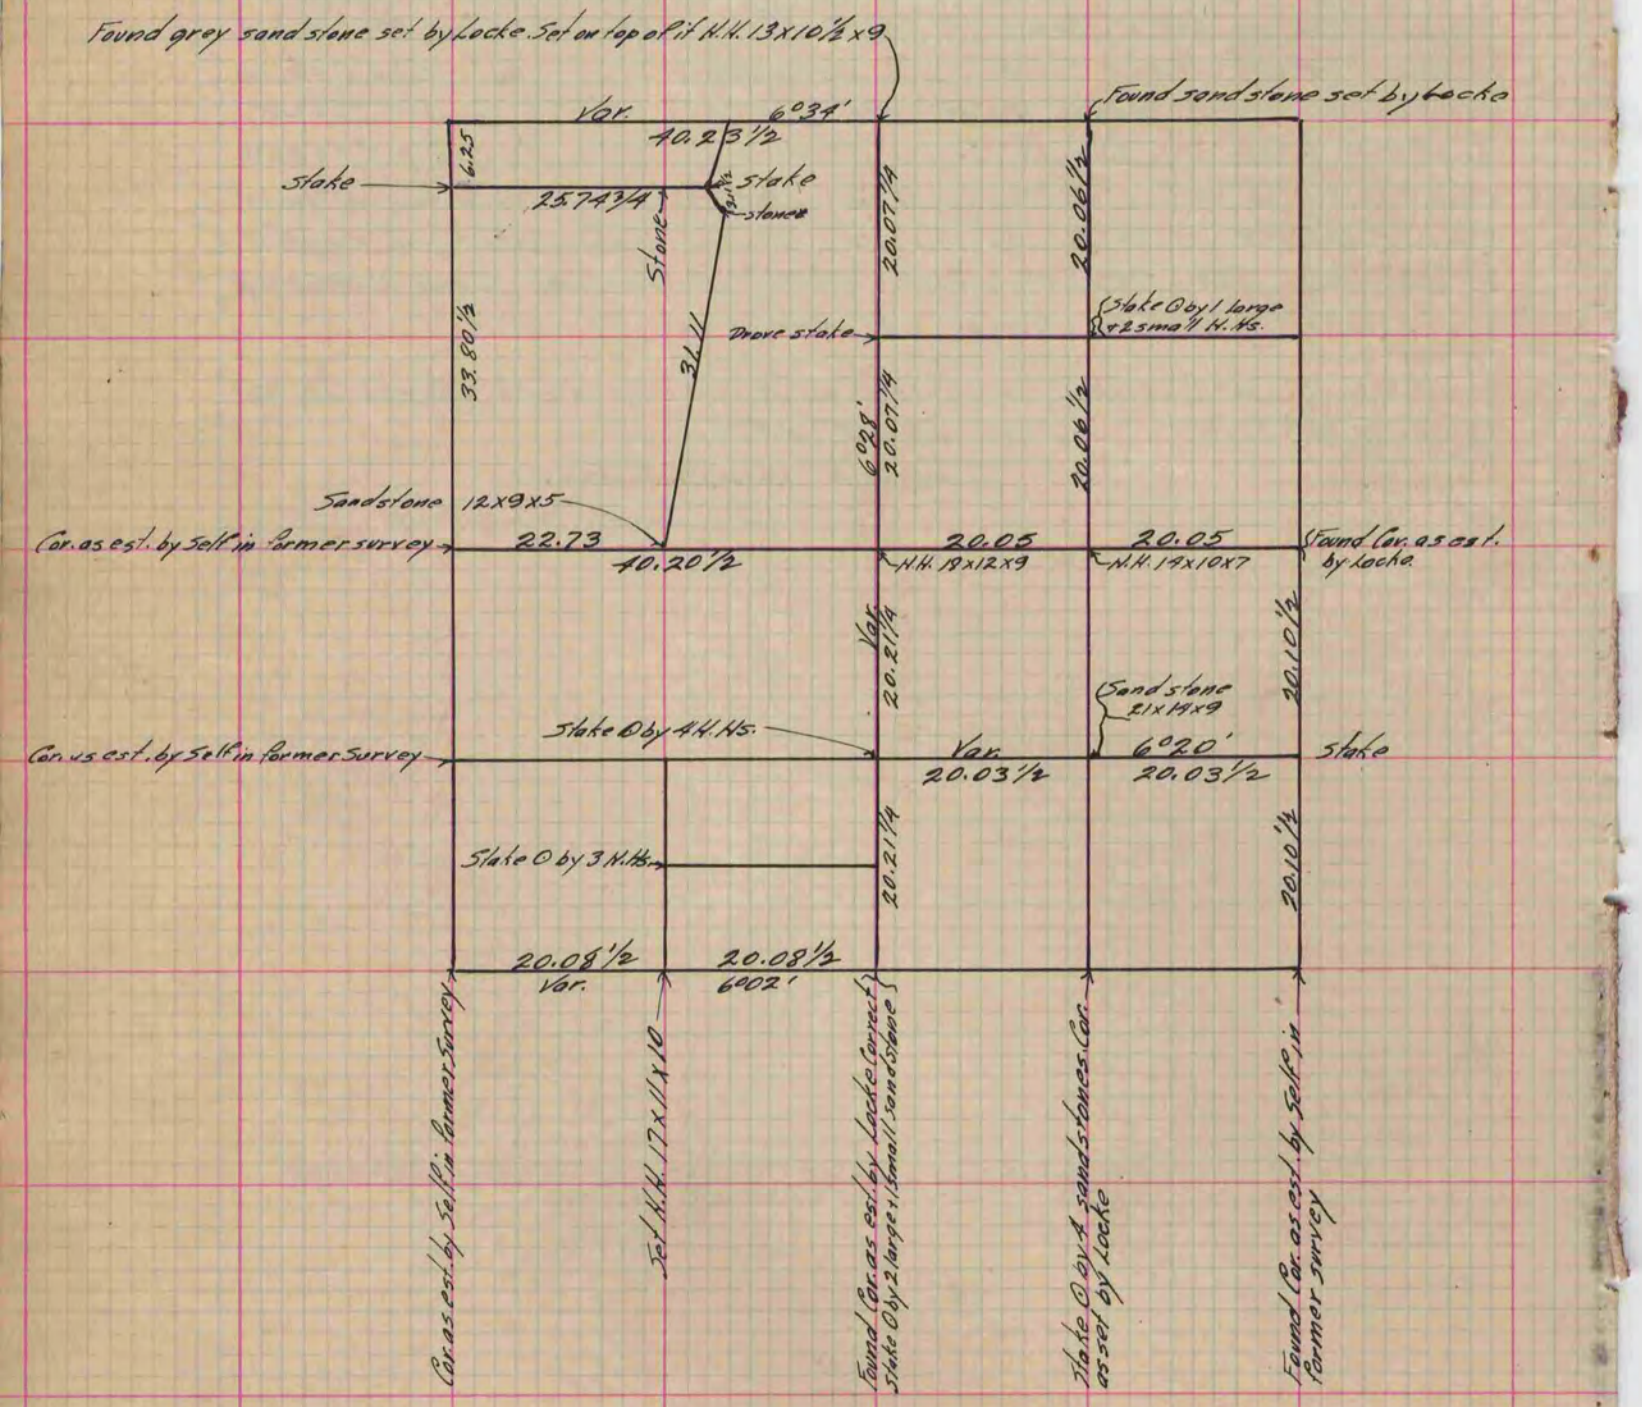

Copied from P. 146 Vol. 2 Original County Surveyor's Record.